


8310
 774-8300
 09-00-055-000-025

ARTHUR & DOROTHY ROGERS
 4-24-70 Vol. 1002, Pt 971

N. 89° 48' 20" W. 1300.90'

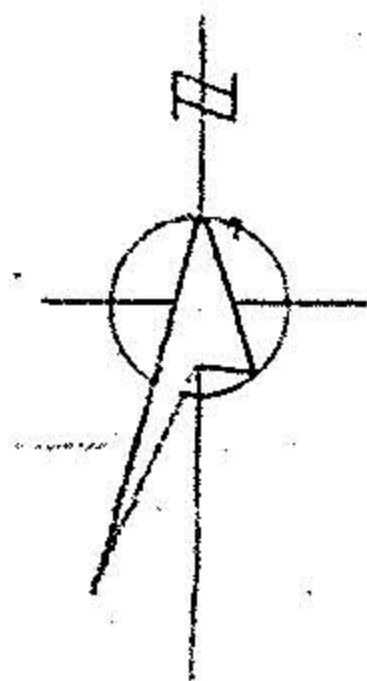

CHARLES M. HAYSLETT
 Vol. 1182 P. 741

S. 0° 47' 40" W. 11320.07'

S. 0° 47' 40" W. 1219.60'

09-00-055-000-005

3.9995 Ac.

09-00-055-000-006
 9.2839 Ac.

09-00-055-000-007
 4.7716 Ac.

09-00-055-000-008
 1.2128 Ac.

09-00-055-000-009

LEROY E. & ALBERTA L. WARD
 5-25-72 Vol. 1043 P. 401

ADAM ZBYNIEWSKI
 Vol. 313 Pt. 503

25.5335 ACRES

8.62 A

BUTTERNUT RIDGE RD. 50'

SURVEY FOR
 LEONARD TWINING
 O. L. 55 RUSSIA TWP, LORAIN COUNTY, OHIO
 SCALE 1"=100' DEC. 1978

LAUNDON SIMON CAHL & ASSOC.
 78-815 E.B. 156 P. 31

DEC 22 1978

2-4-80 SUPPOSED TO CALL PEOPLE BACK BUT FRANK SAID TO LET THEM CALL THE MAP DEPT. & THEN TELL THEM TO CALL ARNOLD KOEPP ABOUT TRIANGLE ... DOES NOT CLOSE.

45.0000 acres