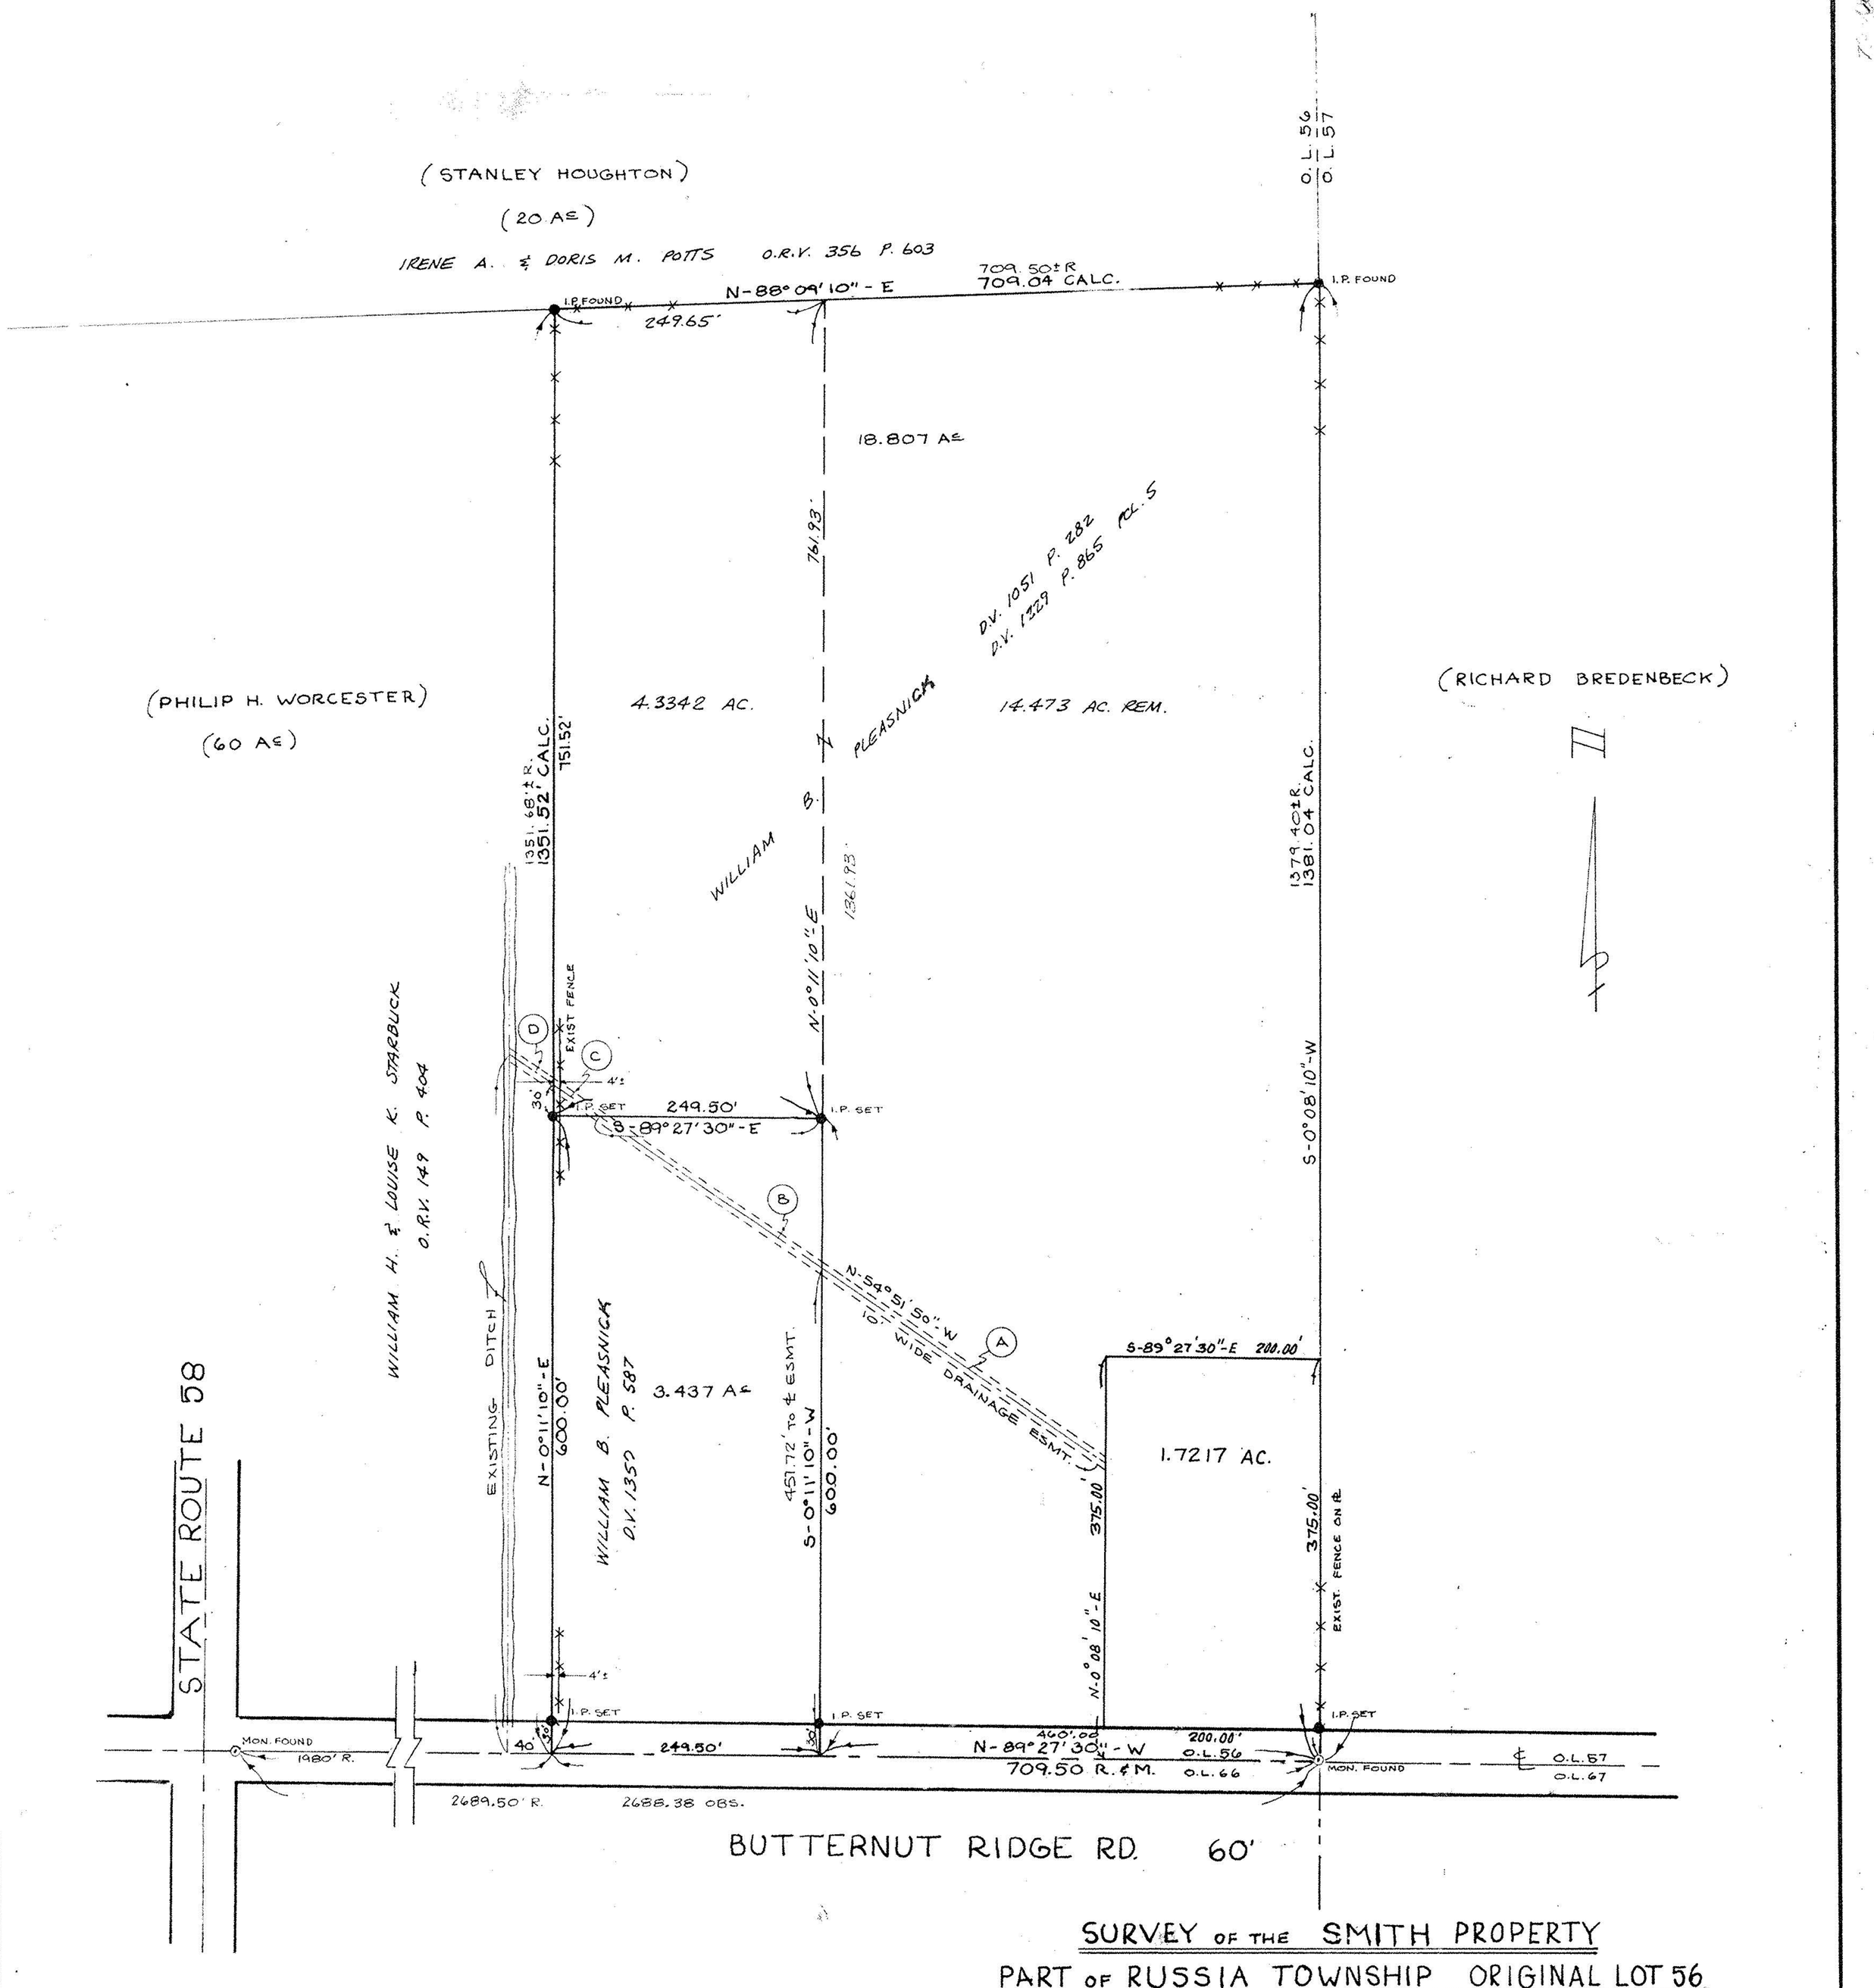

SURVEY OF THE SMITH PROPERTY

PART OF RUSSIA TOWNSHIP ORIGINAL LOT 56

TOWNSHIP OF RUSSIA — COUNTY OF LORAIN

STATE OF OHIO

SCALE: 1" = 100'

APRIL 26, 1972
REV.: 10-13-73

PREPARED BY
JAMES H. SCHMIDT
REGISTERED SURVEYOR

REVISED & UPDATED PER 4.3342 ACRE PARCEL BY
KS ASSOCIATES INC.
ENGINEERS SURVEYORS

David L. Elwell
REG. SURV. NO. 6333
3-5-92
REV. 10-5-93 (1.7217 AC. PCL.)

STATE OF OHIO
DAVID L. ELWELL
6333
REGISTERED
SURVEYOR

72-106