


09-00-062-000

9-E

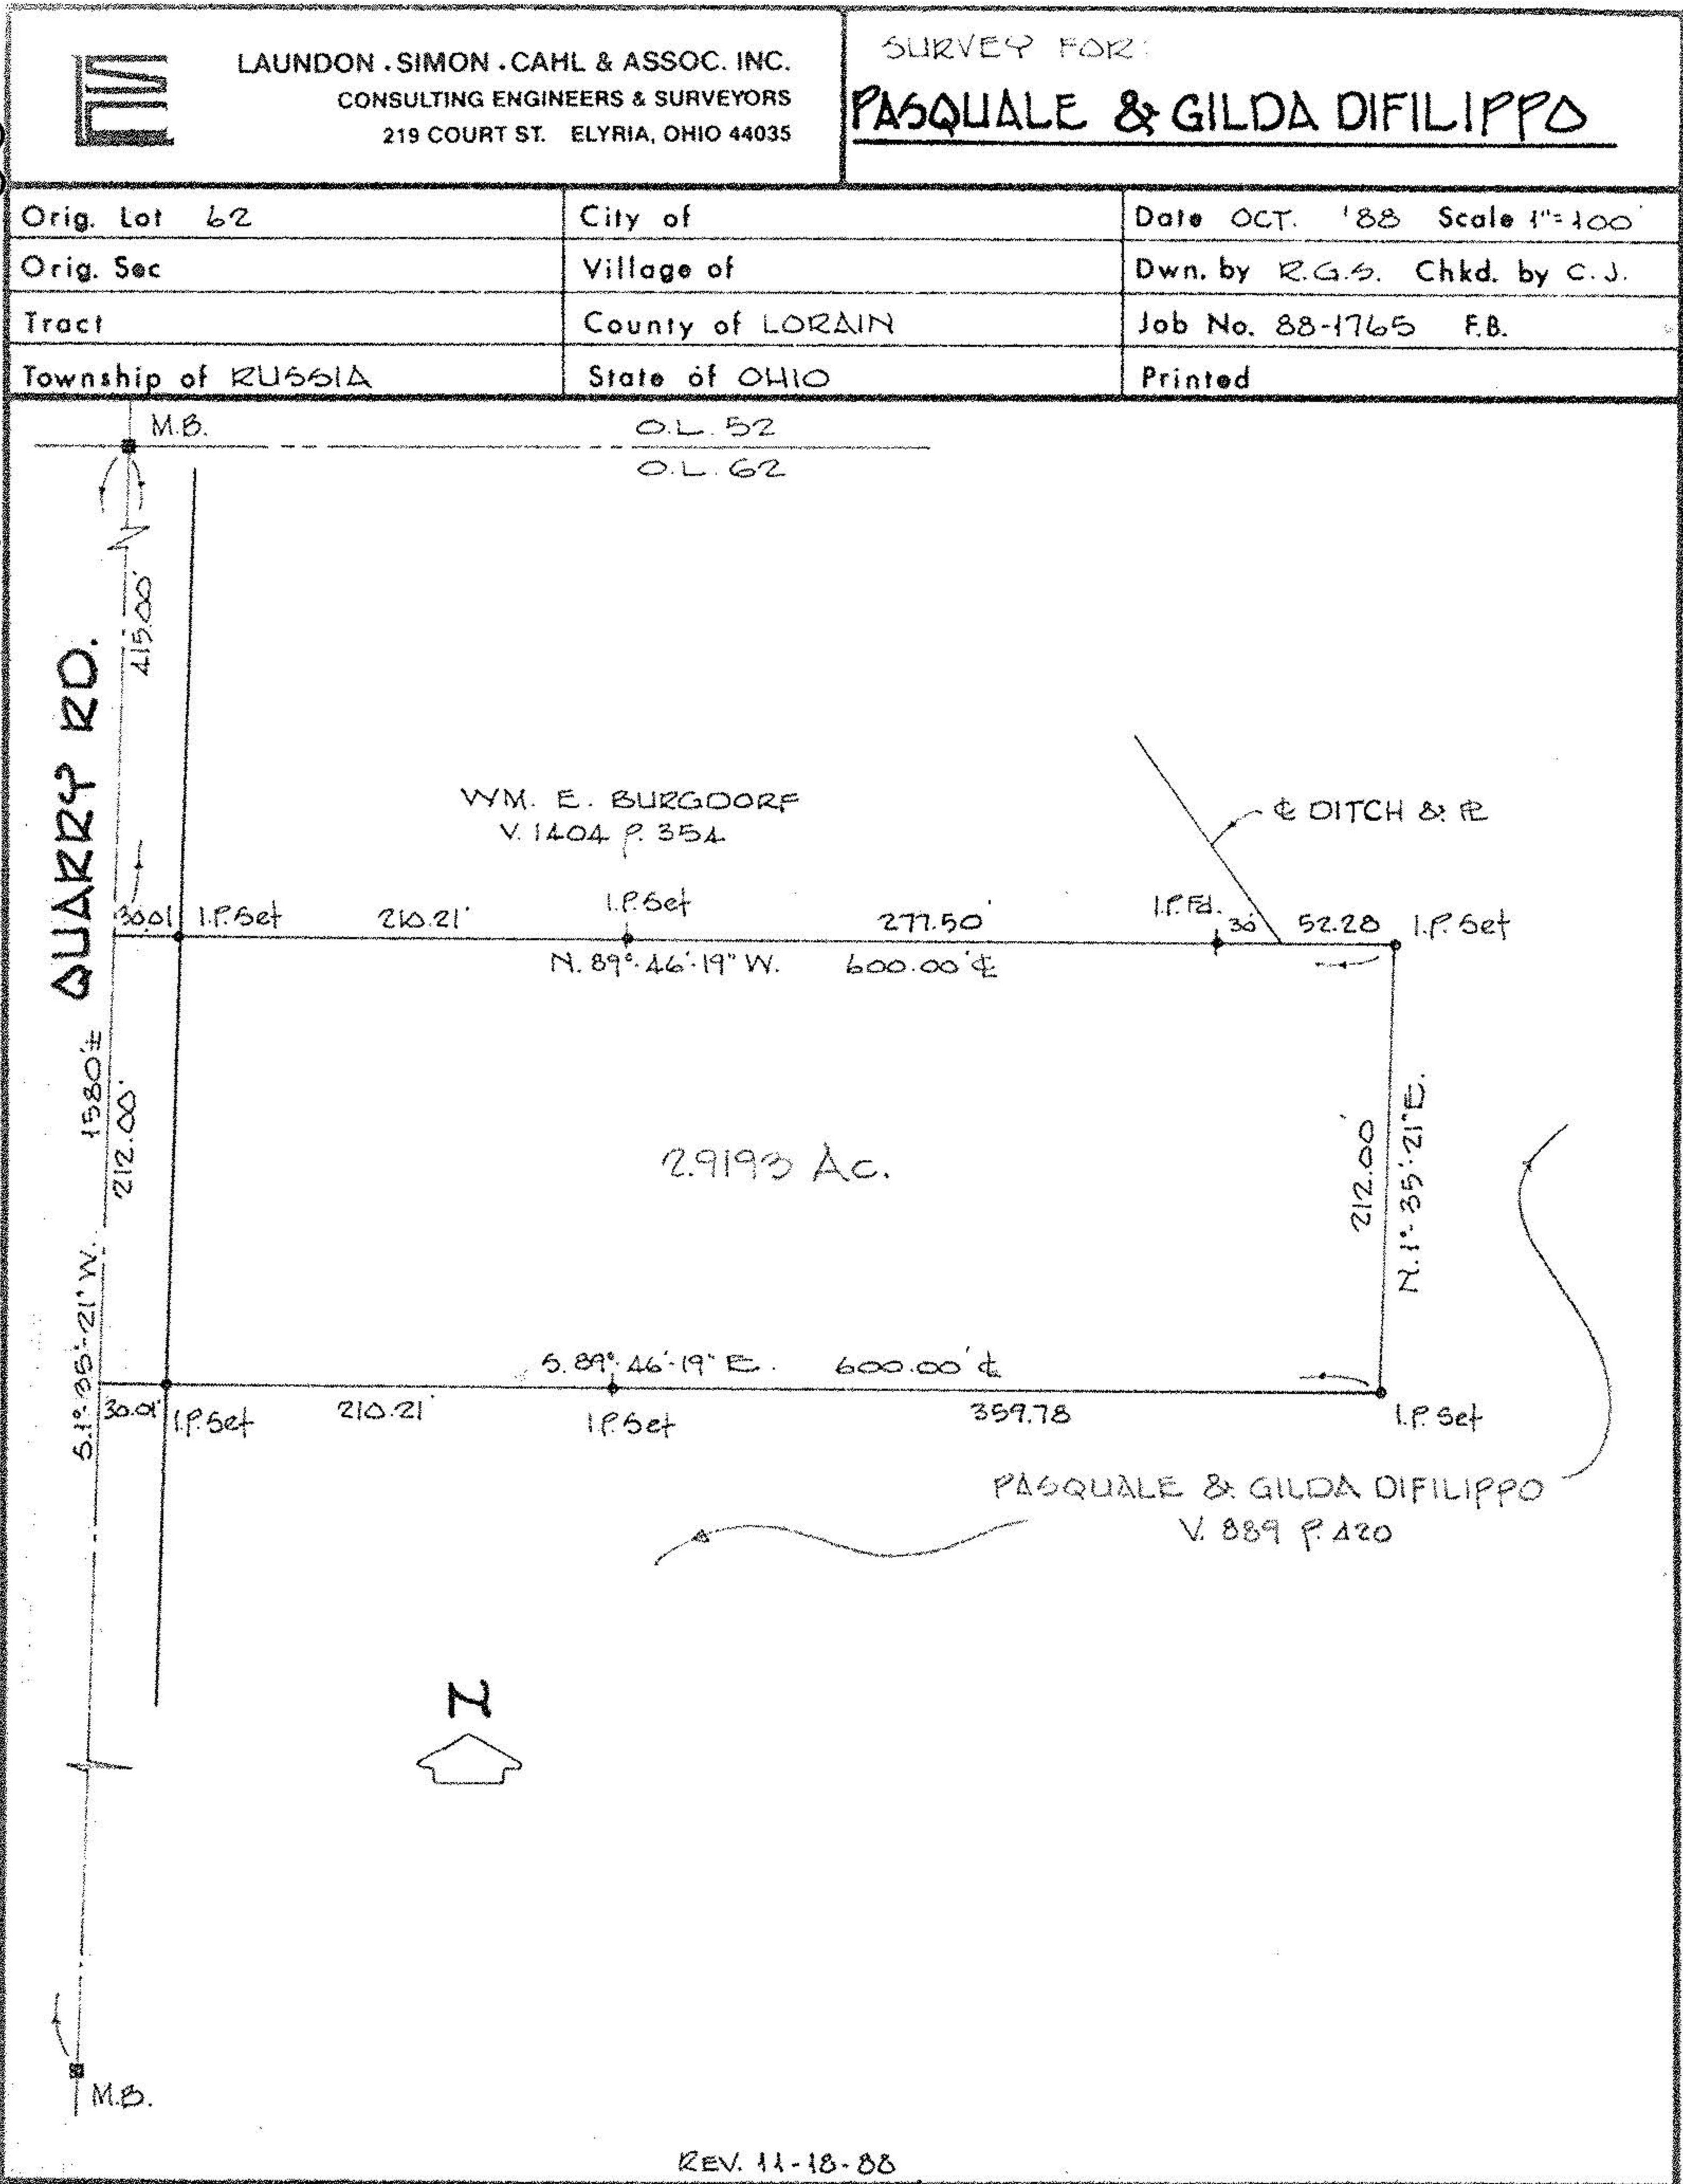

09-00-062-000

#18200

9-E

