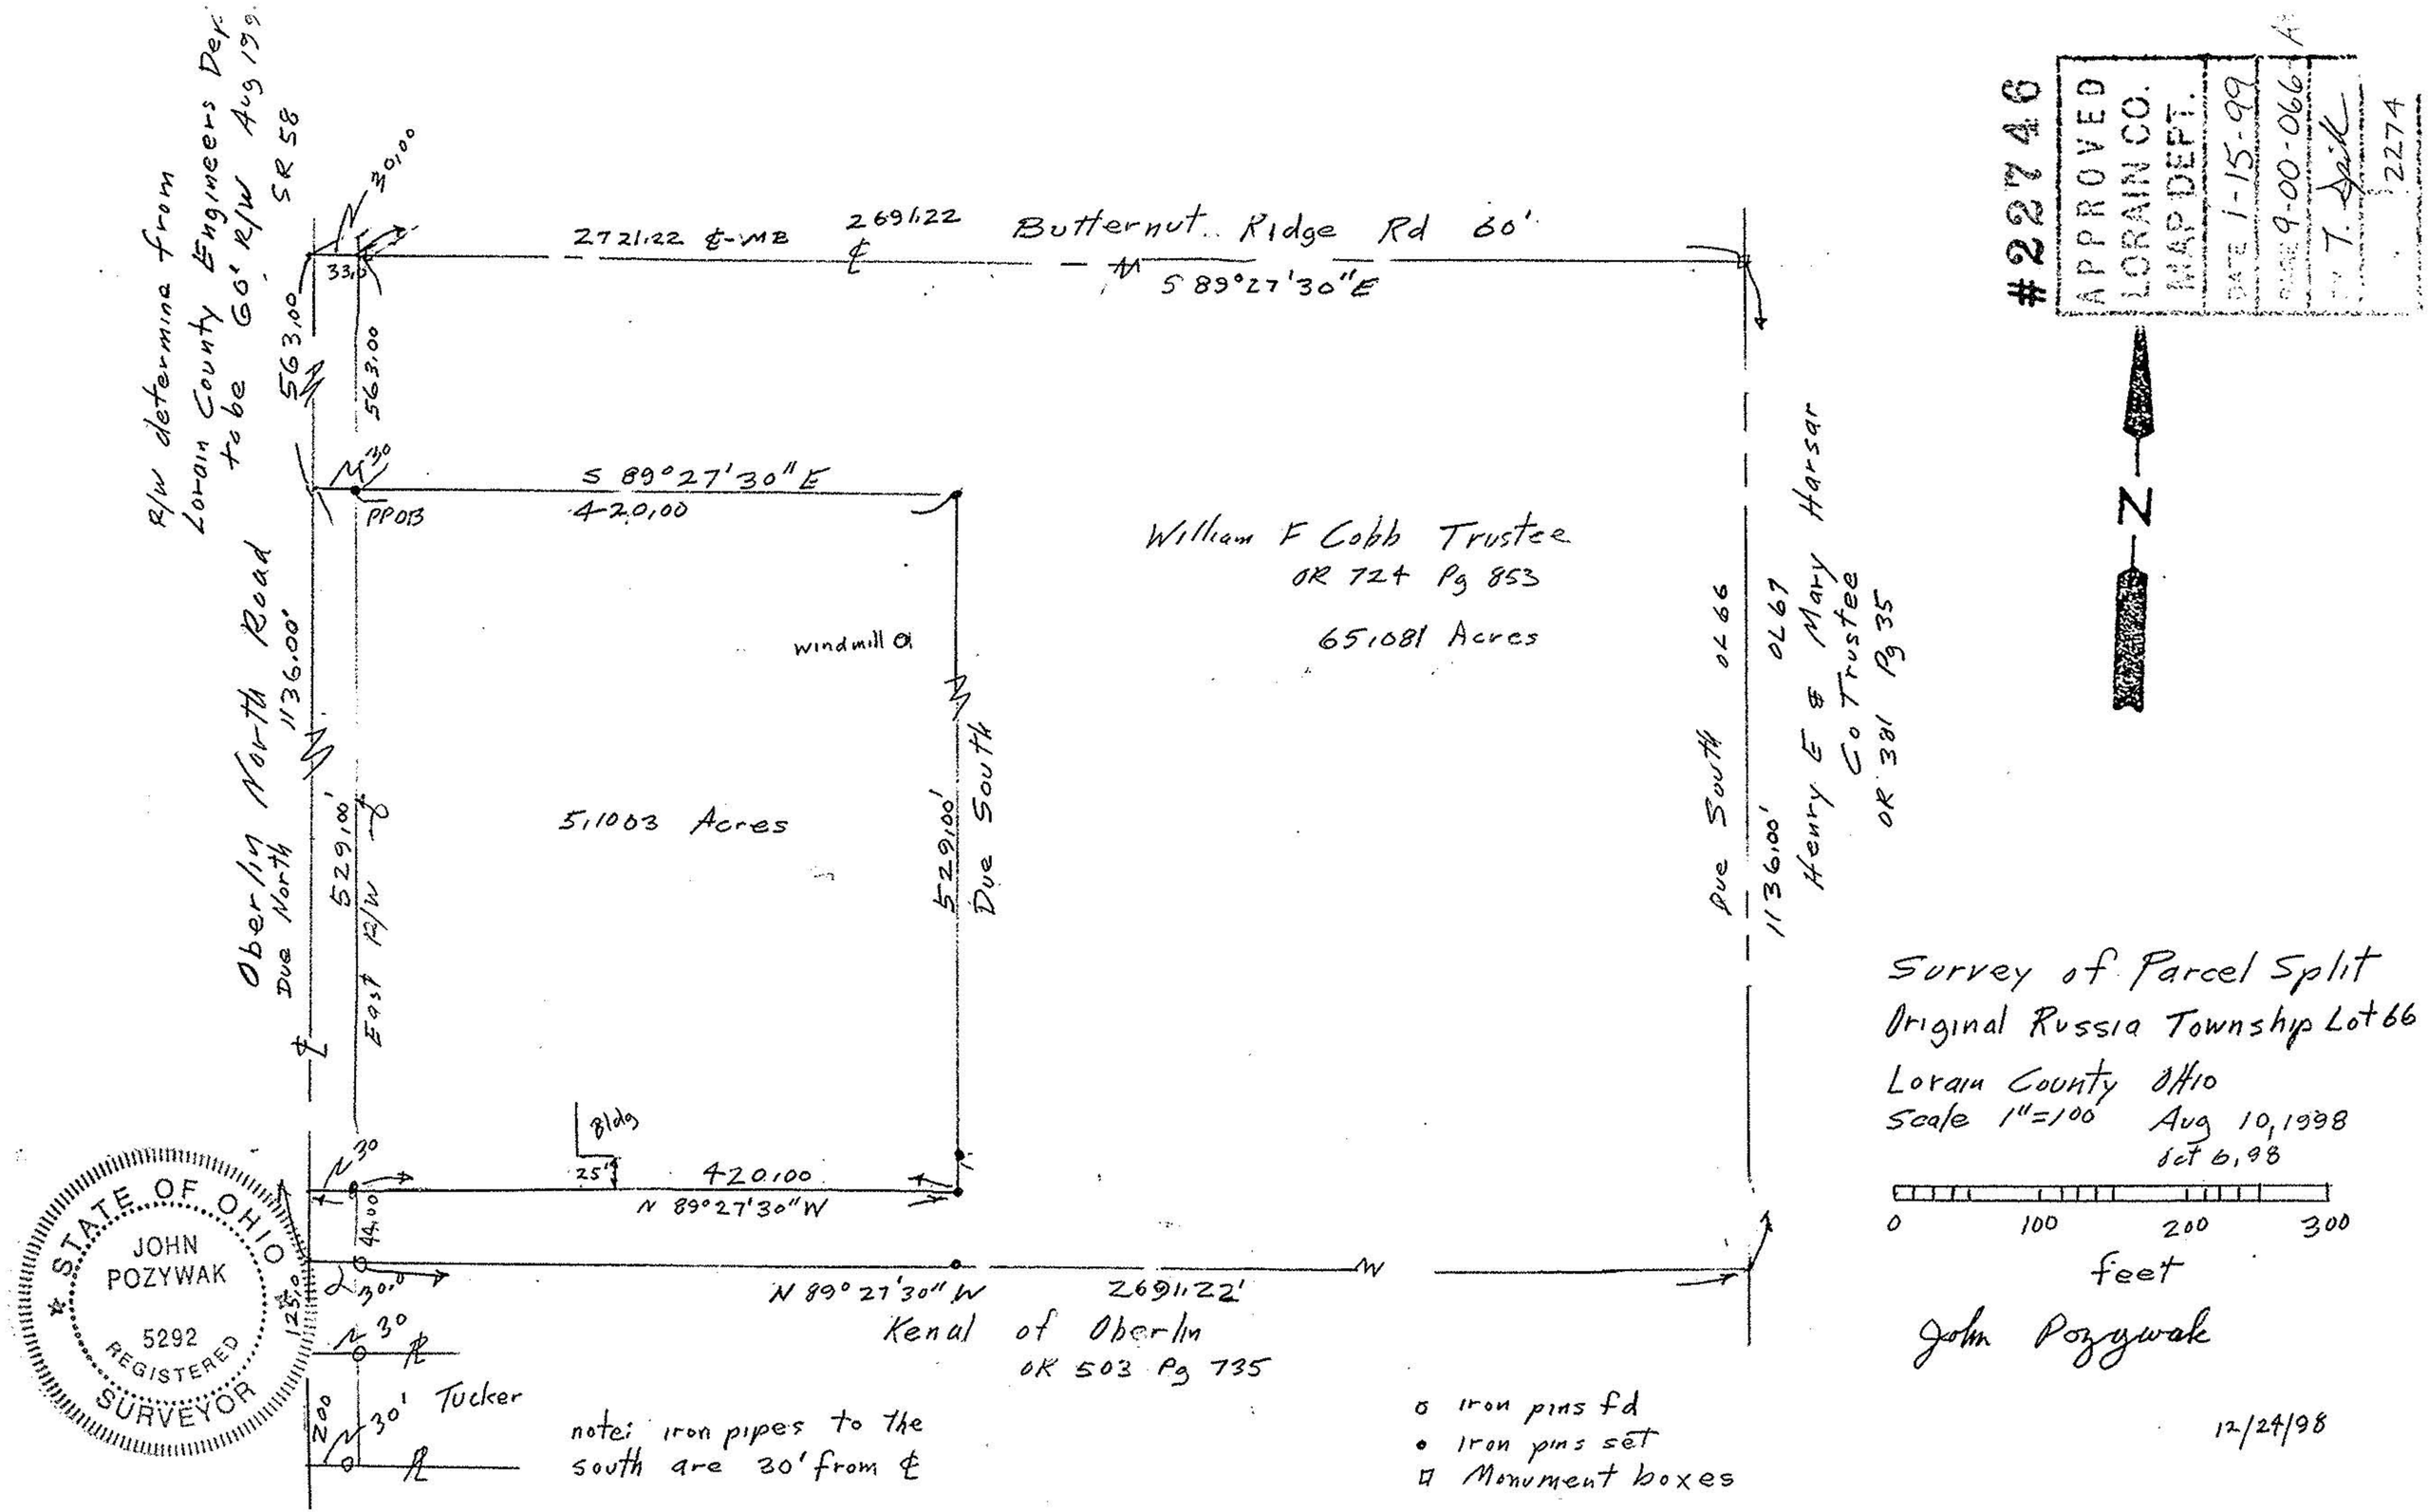

Survey of Parcel Split
Original Russia Township Lot 66
Lorain County Ohio
Scale 1"=100 Aug 10, 1998
Oct 6, 98

John Pozywak

12/24/98