#20312

APPROVED
LORAIN CO.
MAP DEPT.
DATE 5·5·93
PAGE 9-00-067-A
BY CE FRANCIS
VOID AFTER 20312

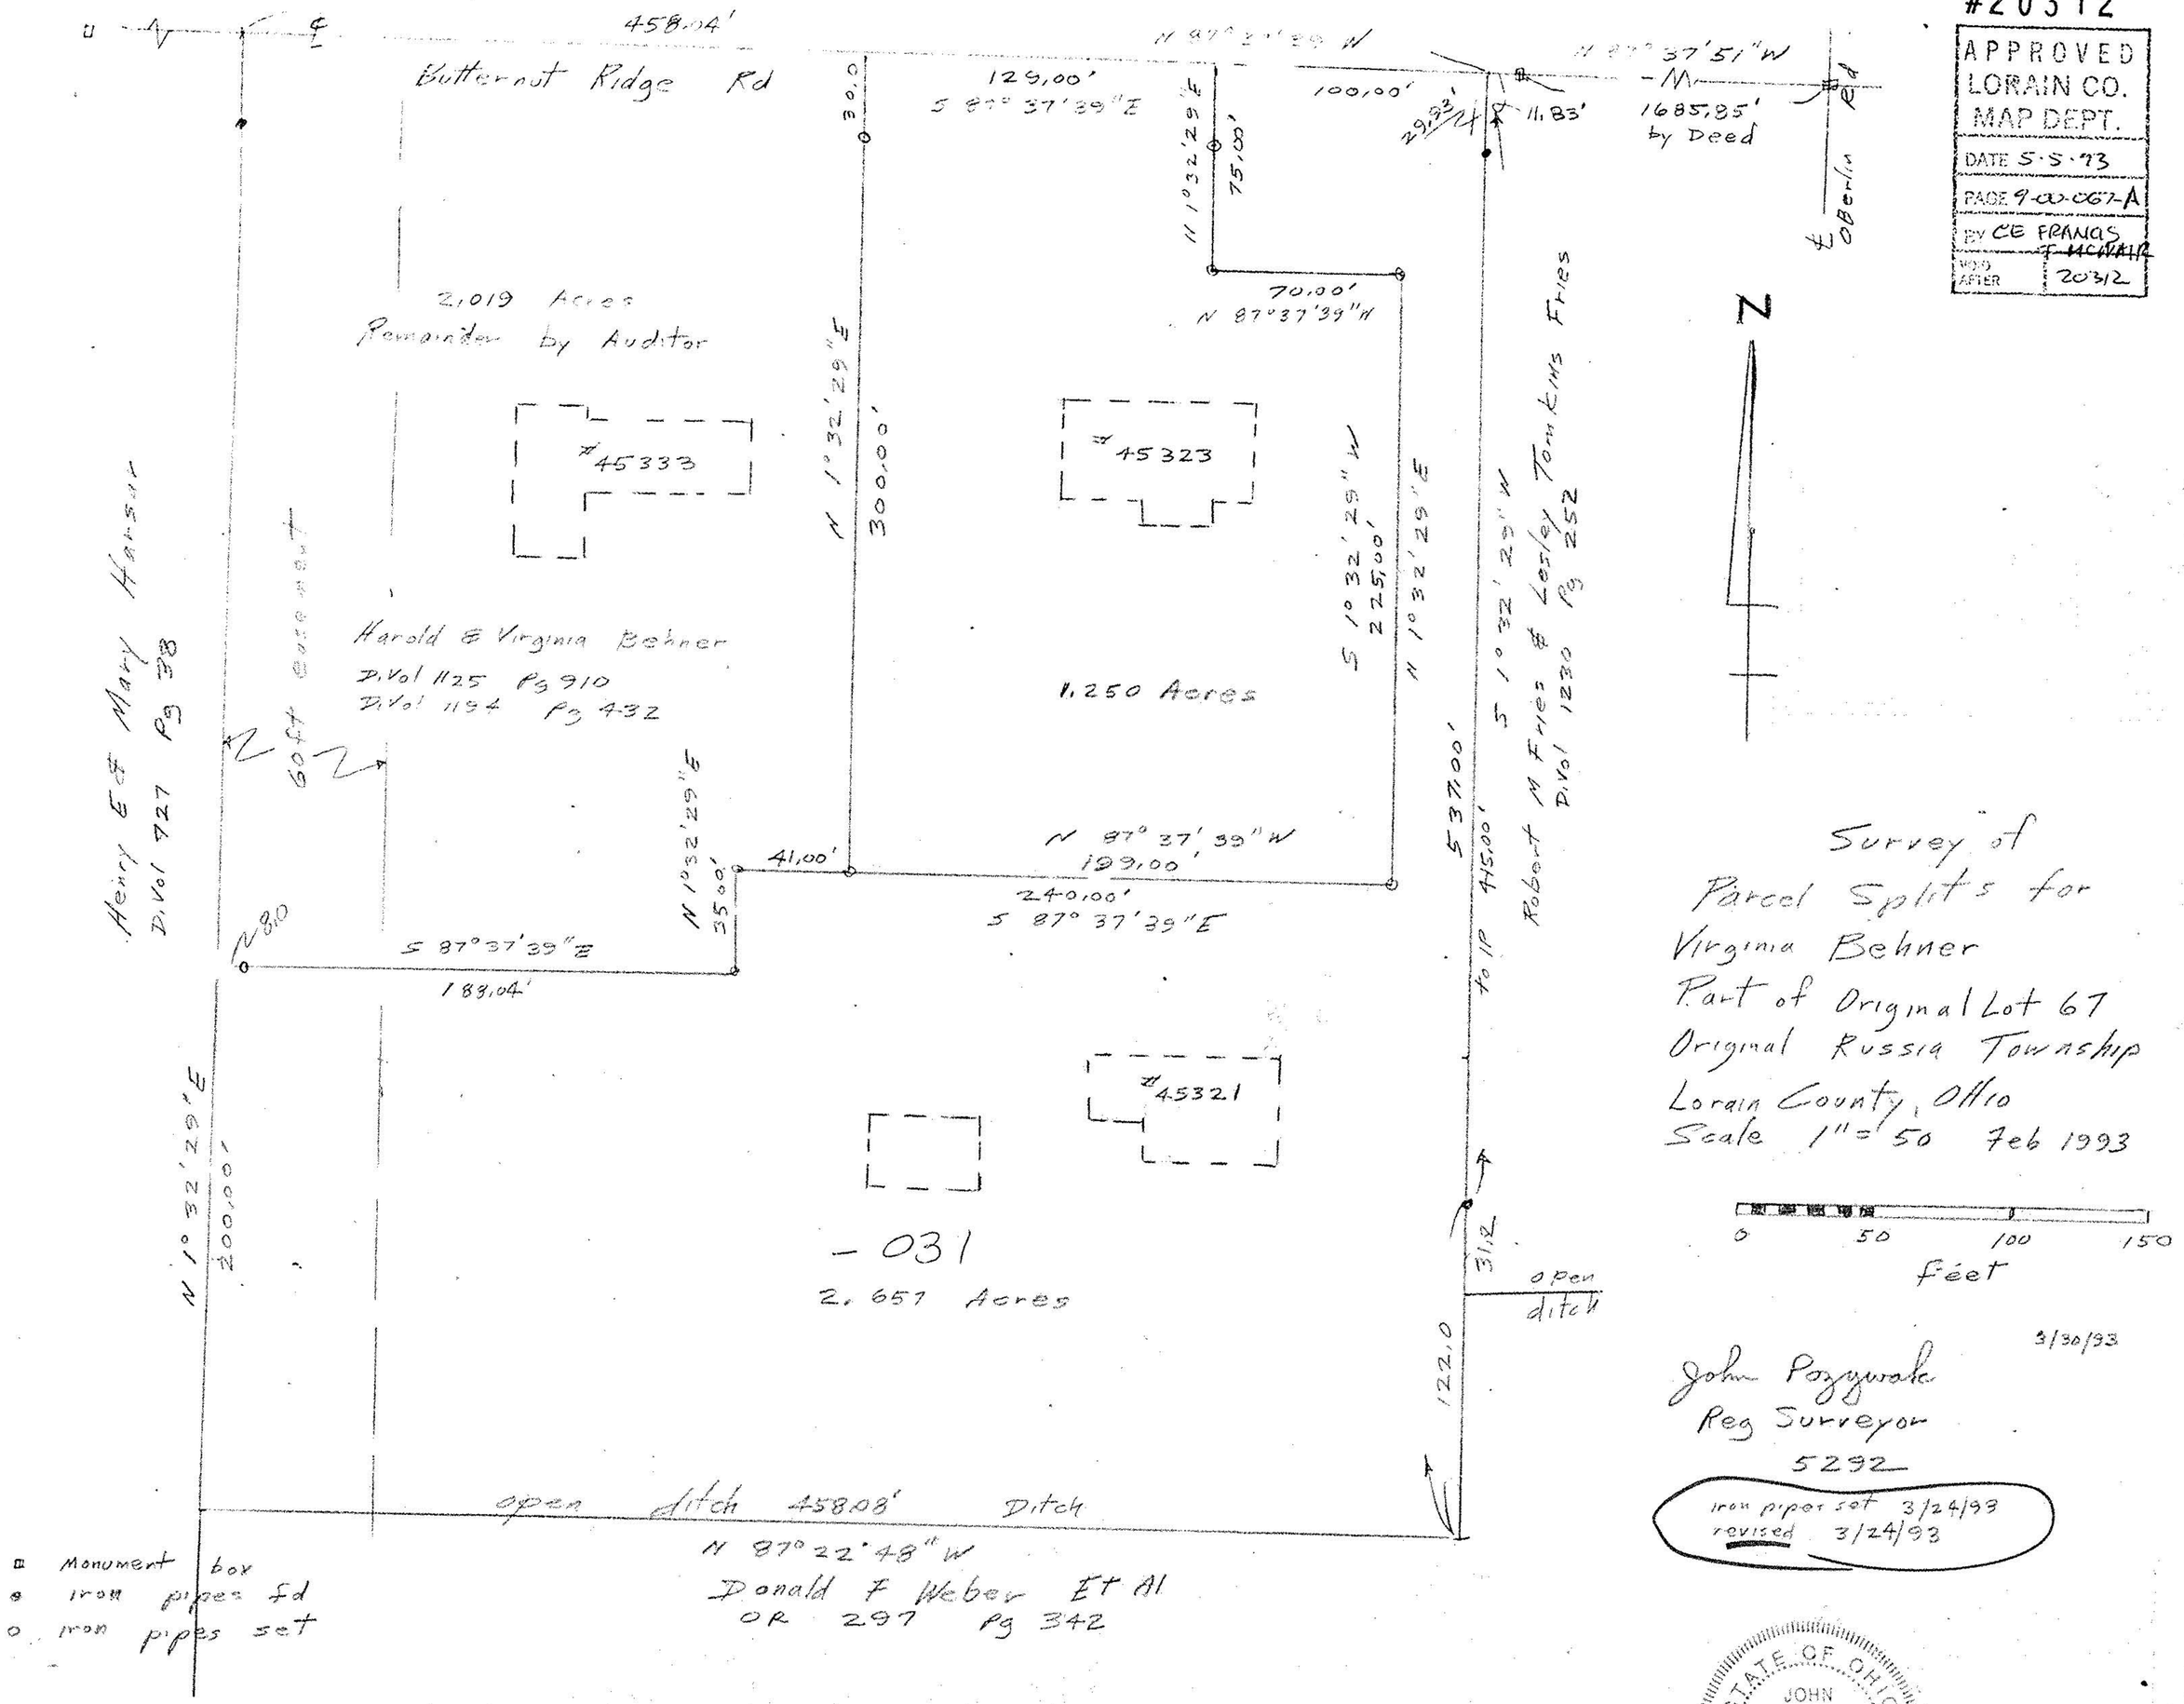

Survey of
Parcel Splits for
Virginia Behner
Part of Original Lot 67
Original Russia Township
Lorain County, Ohio
Scale 1" = 50 Feb 1993

0 50 100 150
Feet

3/30/93

John Pozywak
Reg Surveyor
5292

iron pipes set 3/24/93
revised 3/24/93

STATE OF OHIO
JOHN POZYWAK
5292
REGISTERED SURVEYOR