LAUNDON • SIMON • CAHL & ASSOC., INC.
PROFESSIONAL LAND SURVEYORS
110 MIDDLE AVE., ELYRIA, O. 44035

SURVEY FOR
EUGENE J. PRESTI

Orig. Lot No. 74	City of	Date Apr. 1 1998 Scale 1" = 100'
Orig. Sec No.	Village of	Dwn. by RC Chkd. by RS
Tract "	County of Lorain	Job No. 95-2733 F.B. 244 P.3
Township of New Russia	State of Ohio	Printed

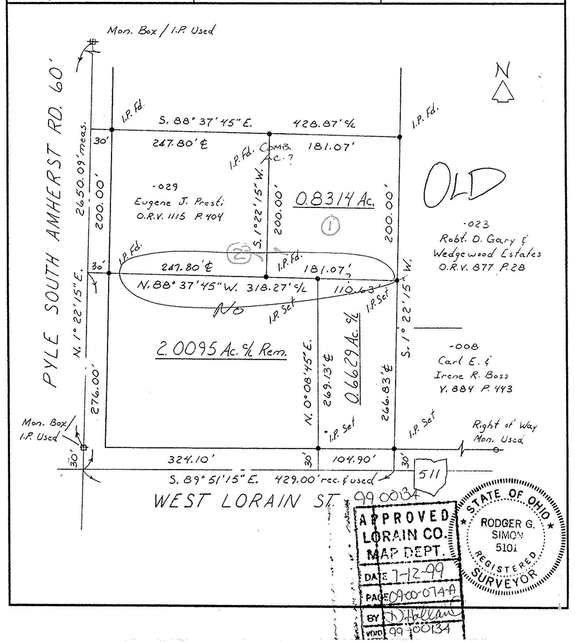

APPROVED
LORAIN CO.
MAP DEPT.
DATE 7-12-99
PAGE 99-074-A
BY
WO# 99-00134

STATE OF OHIO
RODGER G. SIMON
5101
REGISTERED
SURVEYOR

LAUNDON • SIMON • CAHL & ASSOC., INC.
PROFESSIONAL LAND SURVEYORS
110 MIDDLE AVE., ELYRIA, O. 44035

SURVEY FOR
EUGENE J. PRESTI

Orig. Lot No. 74	City of	Date Apr. 1 1998 Scale 1" = 100'
Orig. Sec No.	Village of	Dwn. by RC Chkd. by RS
Tract "	County of Lorain	Job No. 95-2733 F.B. 244 P.3
Township of New Russia	State of Ohio	Printed

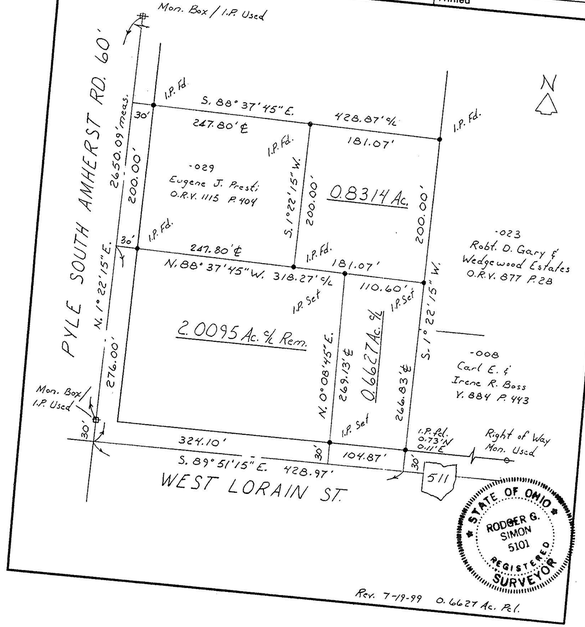

STATE OF OHIO
RODGER G. SIMON
5101
REGISTERED
SURVEYOR

Rev. 7-19-99 0.6627 Ac. Pcl.

LAUNDON • SIMON • CAHL & ASSOC., INC.
PROFESSIONAL LAND SURVEYORS
110 MIDDLE AVE., ELYRIA, O. 44035

SURVEY FOR
EUGENE J. PRESTI

Orig. Lot No. 74	City of	Date Apr. 1 1998 Scale 1" = 100'
Orig. Sec No.	Village of	Dwn. by RC Chkd. by RS
Tract "	County of Lorain	Job No. 95-2733 F.B. 244 P.3
Township of New Russia	State of Ohio	Printed

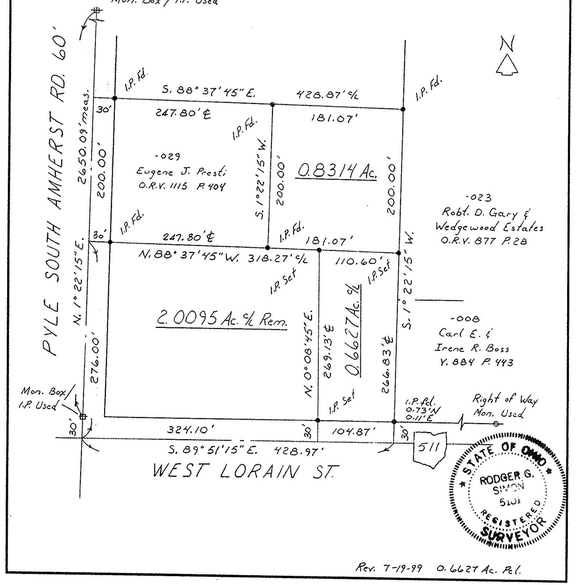

STATE OF OHIO
RODGER G. SIMON
5101
REGISTERED
SURVEYOR

Rev. 7-19-99 0.6627 Ac. Pcl.

LAUNDON • SIMON • CAHL & ASSOC., INC.
PROFESSIONAL LAND SURVEYORS
110 MIDDLE AVE., ELYRIA, O. 44035

SURVEY FOR
EUGENE J. PRESTI

Orig. Lot No. 74	City of	Date Apr. 1 1998 Scale 1" = 100'
Orig. Sec No.	Village of	Dwn. by RC Chkd. by RS
Tract "	County of Lorain	Job No. 95-2733 F.B. 244 P.3
Township of New Russia	State of Ohio	Printed

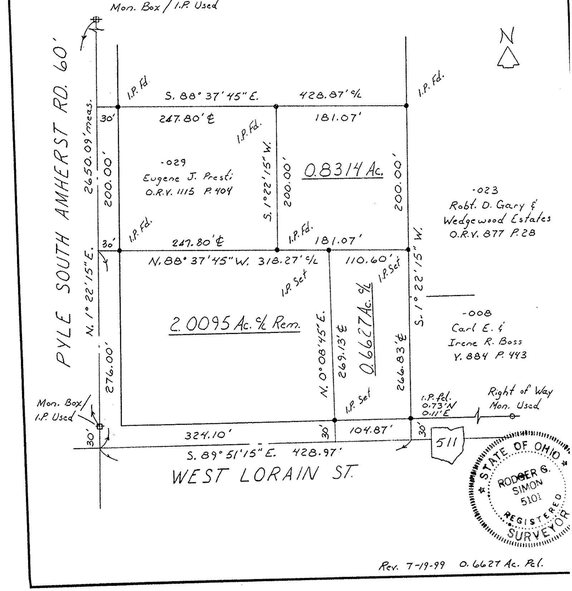

STATE OF OHIO
RODGER G. SIMON
5101
REGISTERED
SURVEYOR

Rev. 7-19-99 0.6627 Ac. Pcl.