LAUNDON • SIMON • CAHL & ASSOC., INC.
CONSULTING ENGINEERS & SURVEYORS
110 MIDDLE AVE., ELYRIA, O. 44035

Lot Split for
ERIC D. GAINES

Orig. Lot 75	City of Oberlin	Date May 1995 Scale 1"=100'
Orig. Sec	Village of	Dwn. by RC Chkd. by RS
Tract	County of Lorain	Job No. 95-2694 F.B. 235 P. 29
Township of Russia	State of Ohio	Printed

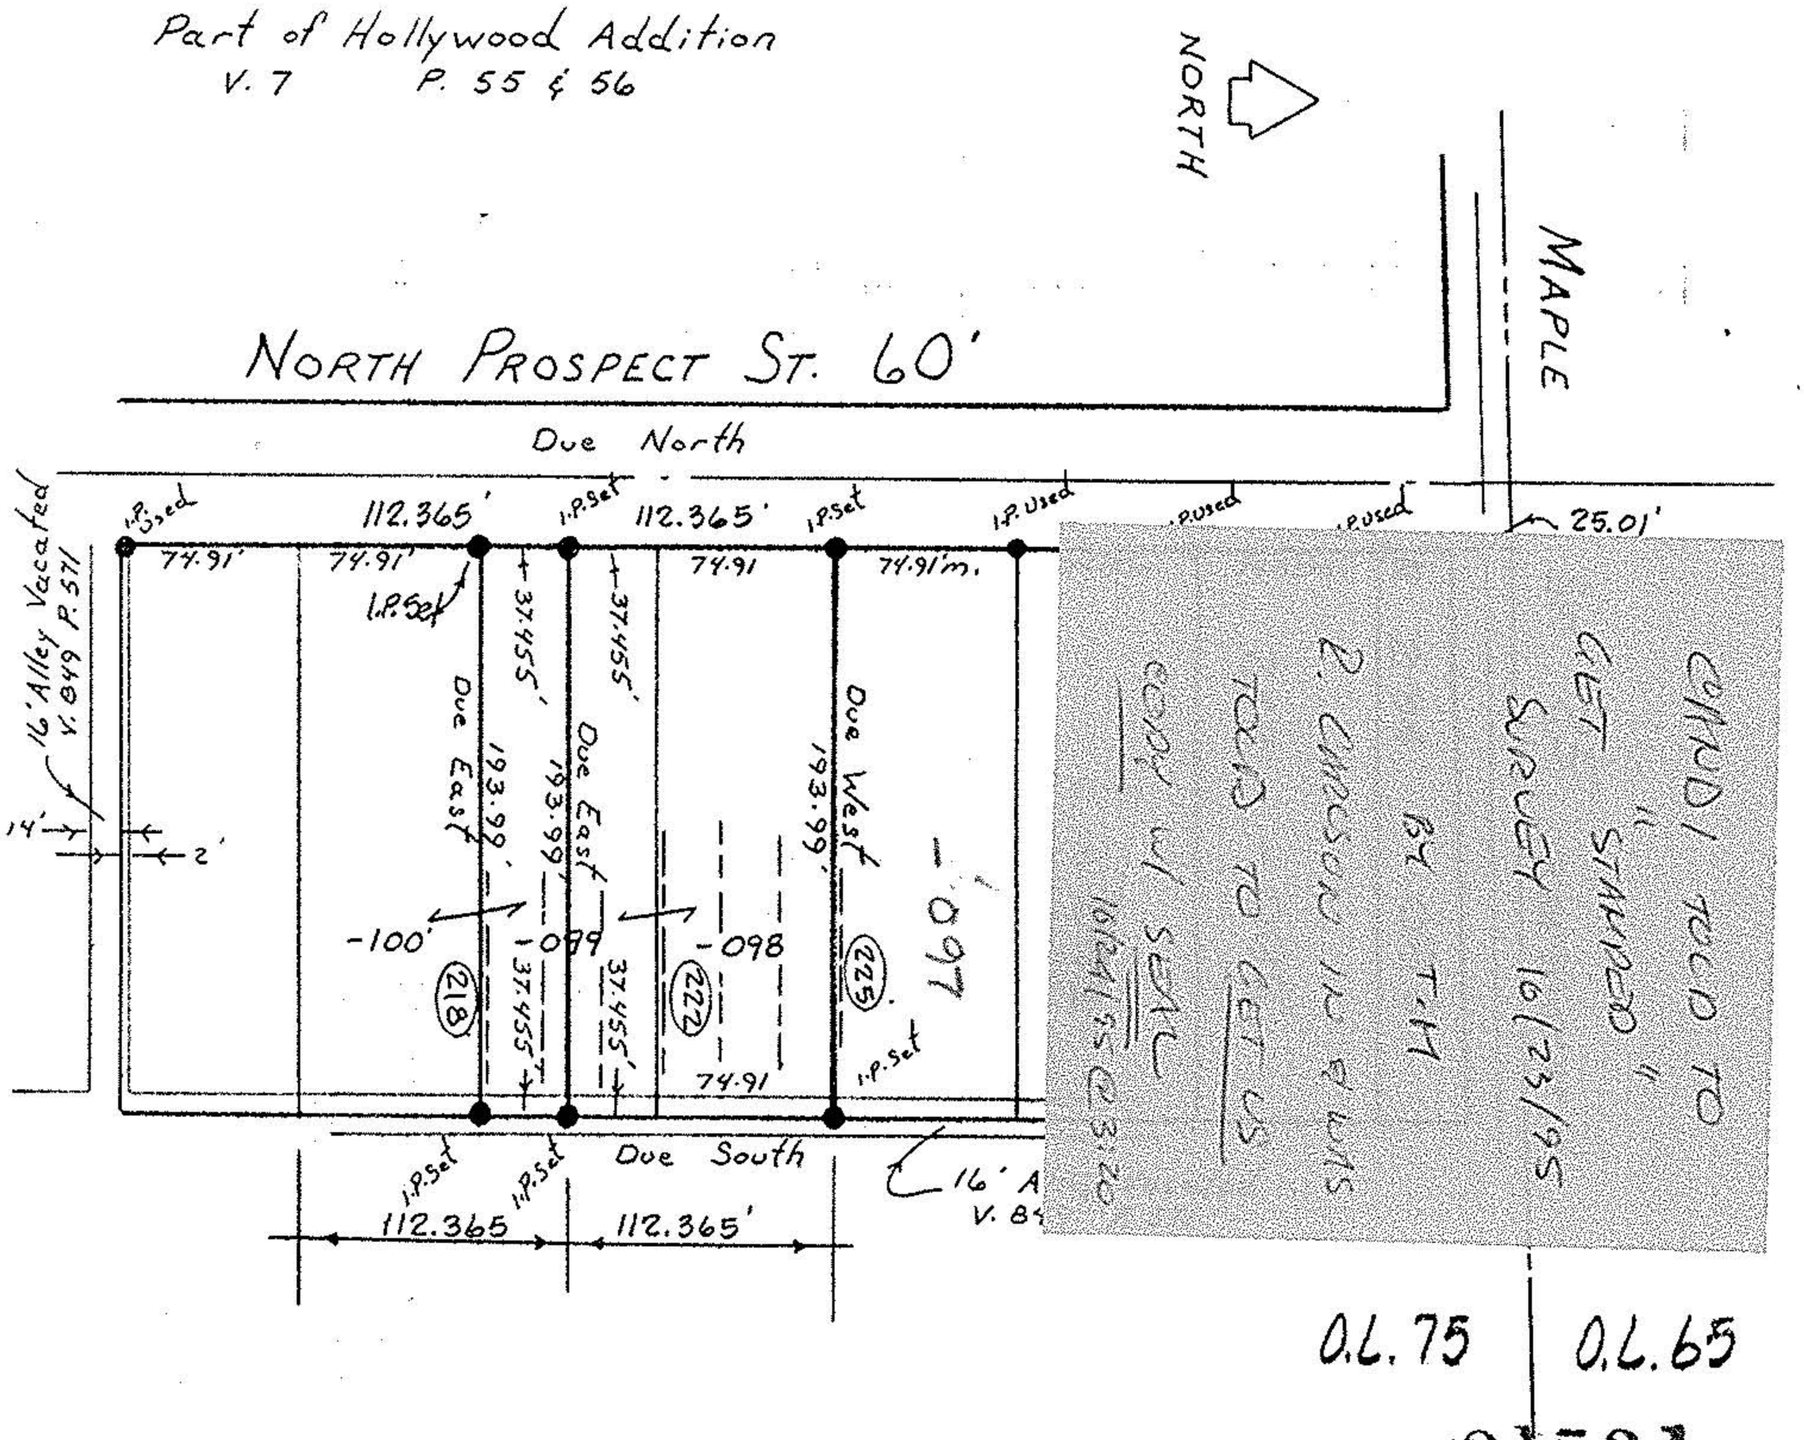

CANDI TOLD TO
"STAMPED"
GET
SURVEY 10/23/95
BY T.H.
R. CARLSON IN 9 WAS
TOLD TO GET US
COPY W/ SEAL
10/24/95 @ 3:20

O.L. 75 | O.L. 65

21531

APPROVED
LORAIN CO.
MAP DEPT
DATE 10-17-95
PAGE 9-00-075-A
BY CAROLYN FRANCIS
21531