LAUNDON • SIMON • CAHL & ASSOC., INC.
PROFESSIONAL LAND SURVEYORS
110 MIDDLE AVE., ELYRIA, O. 44035

Survey For
JEFFRIE & MELISSA BUTTS

Orig. Lot No. 89 & 90	City of	Date 8-4-00 Scale 1" = 200'
Orig. Sec No.	Village of	Dwn. by RC Chkd. by RS
Tract	County of Lorain	Job No. 00-3262 F.B. 248 P.12
Township of New Russia	State of Ohio	Printed

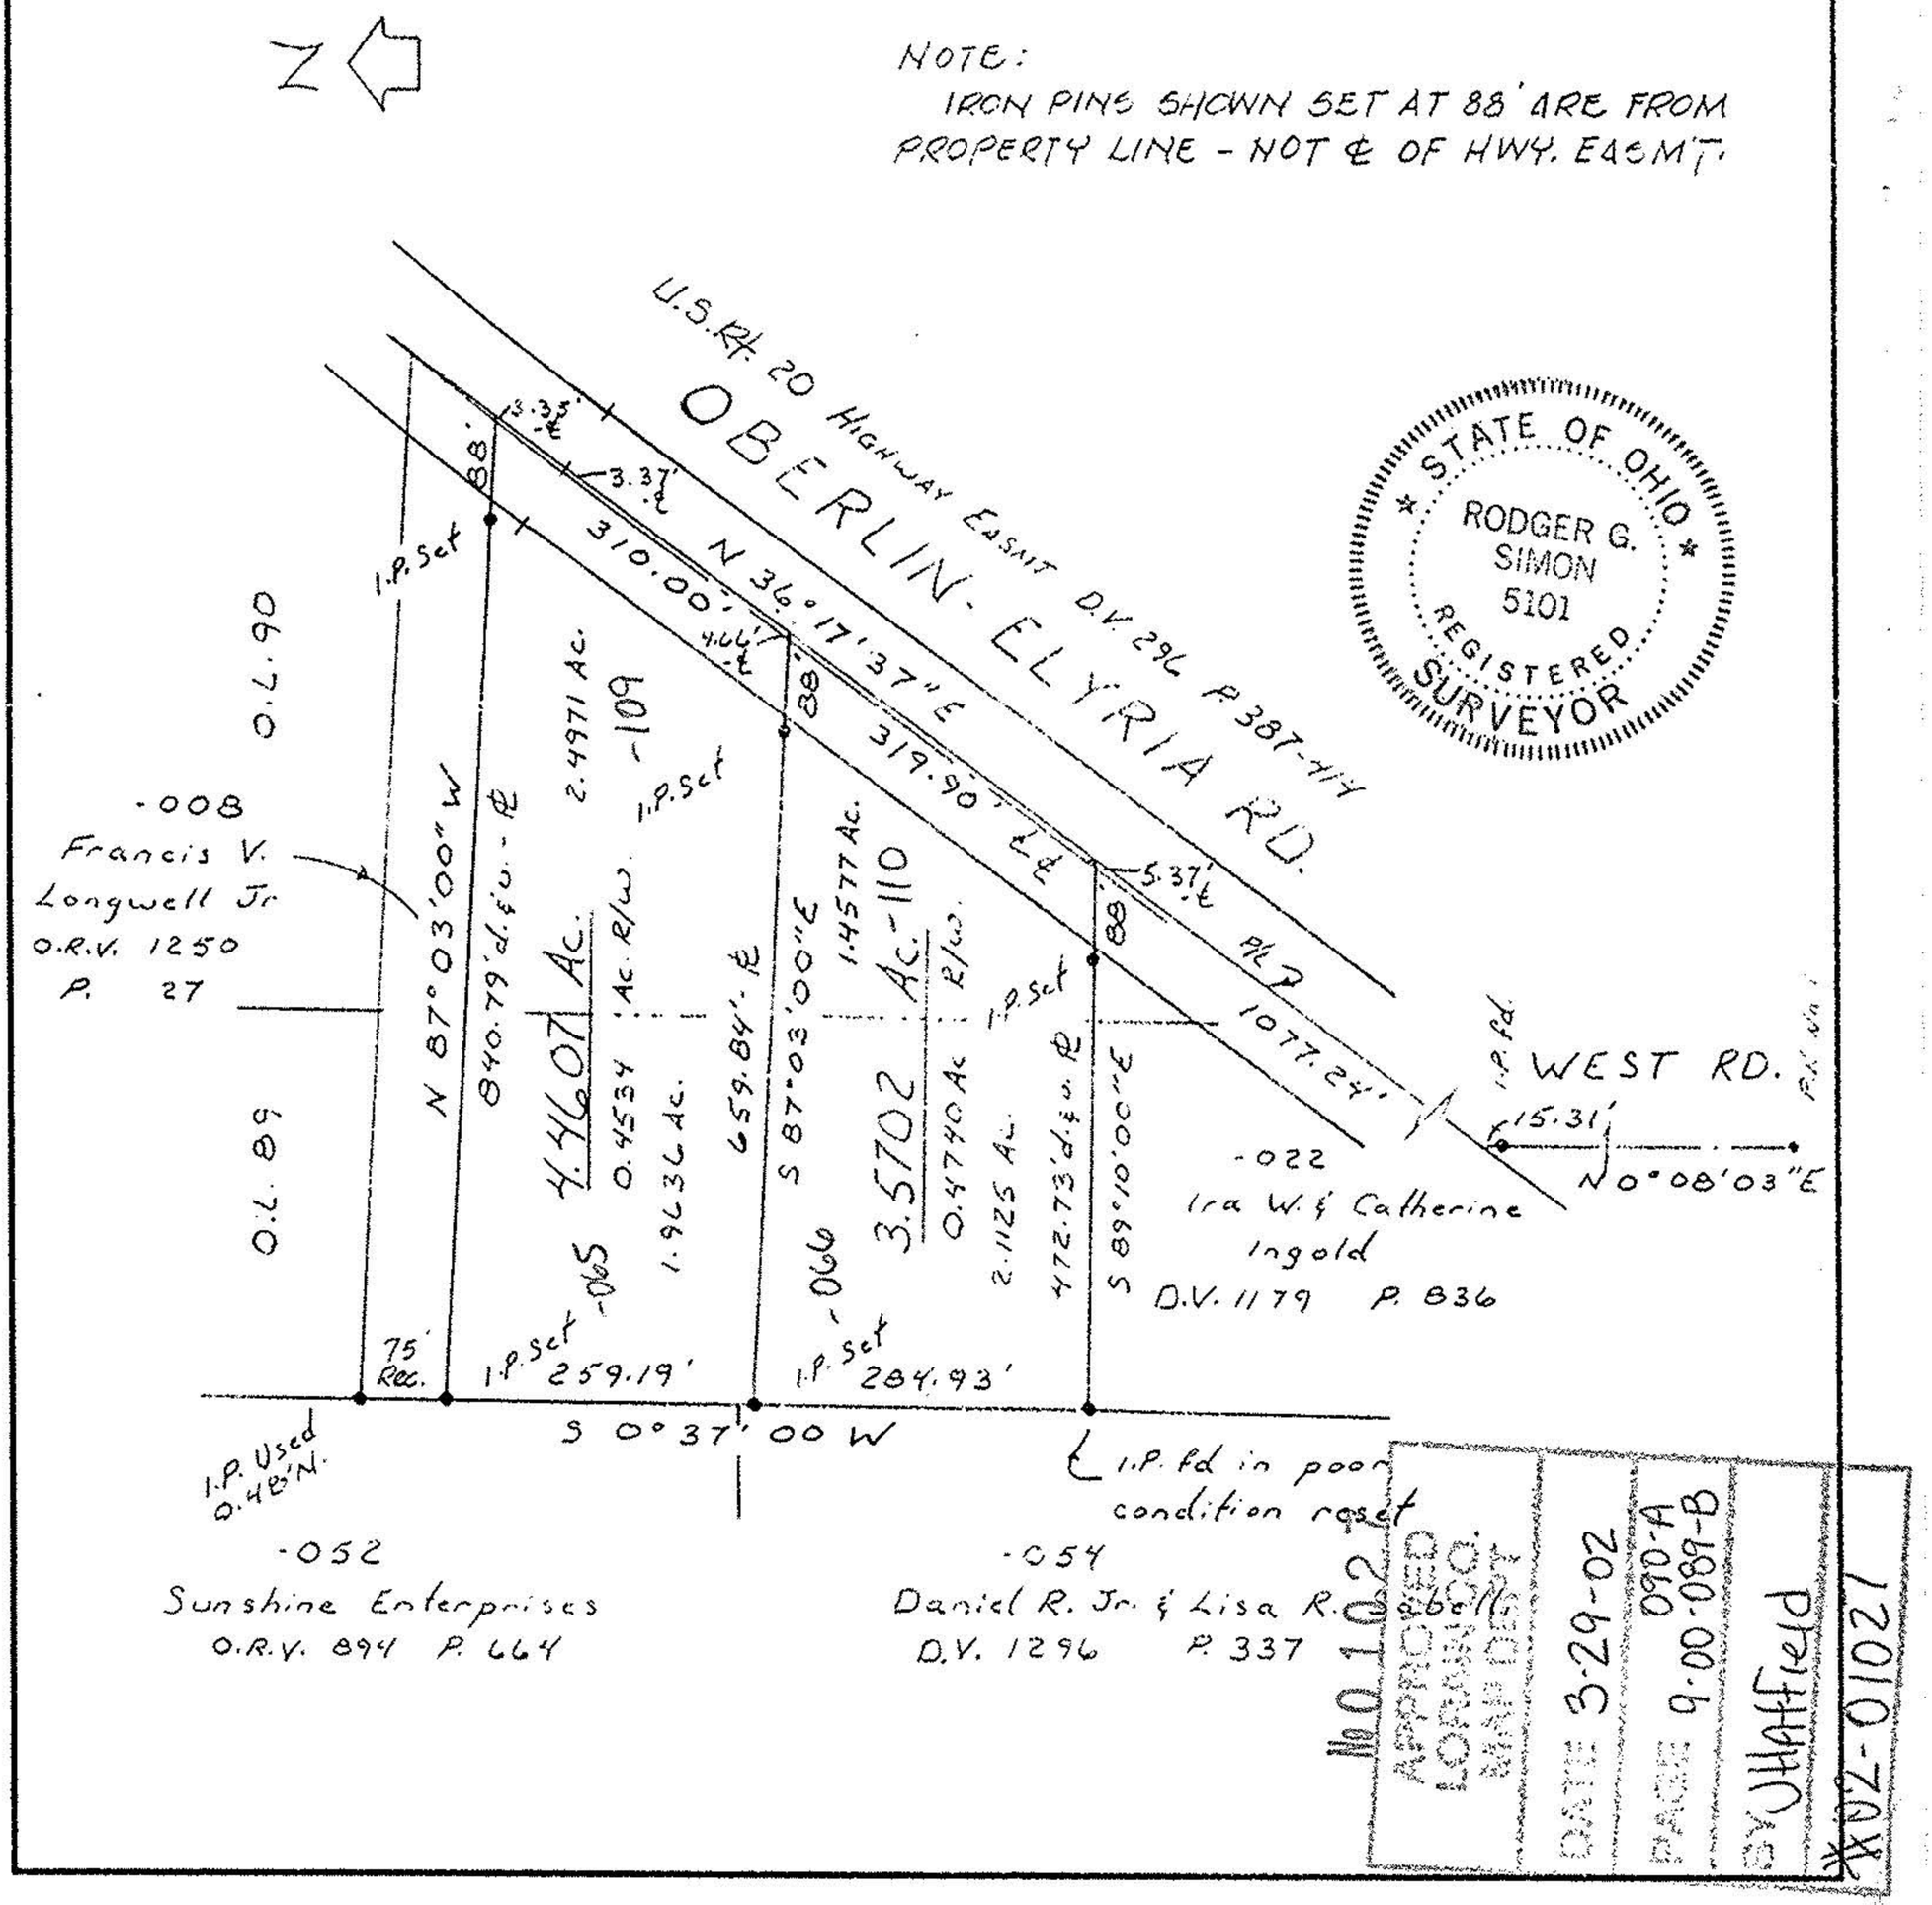

APPROVED LORAIN CO. MAP DEPT
DATE 3-29-02
PAGE 090-A 9-00-089-B
BY JHaffield
#02-01021