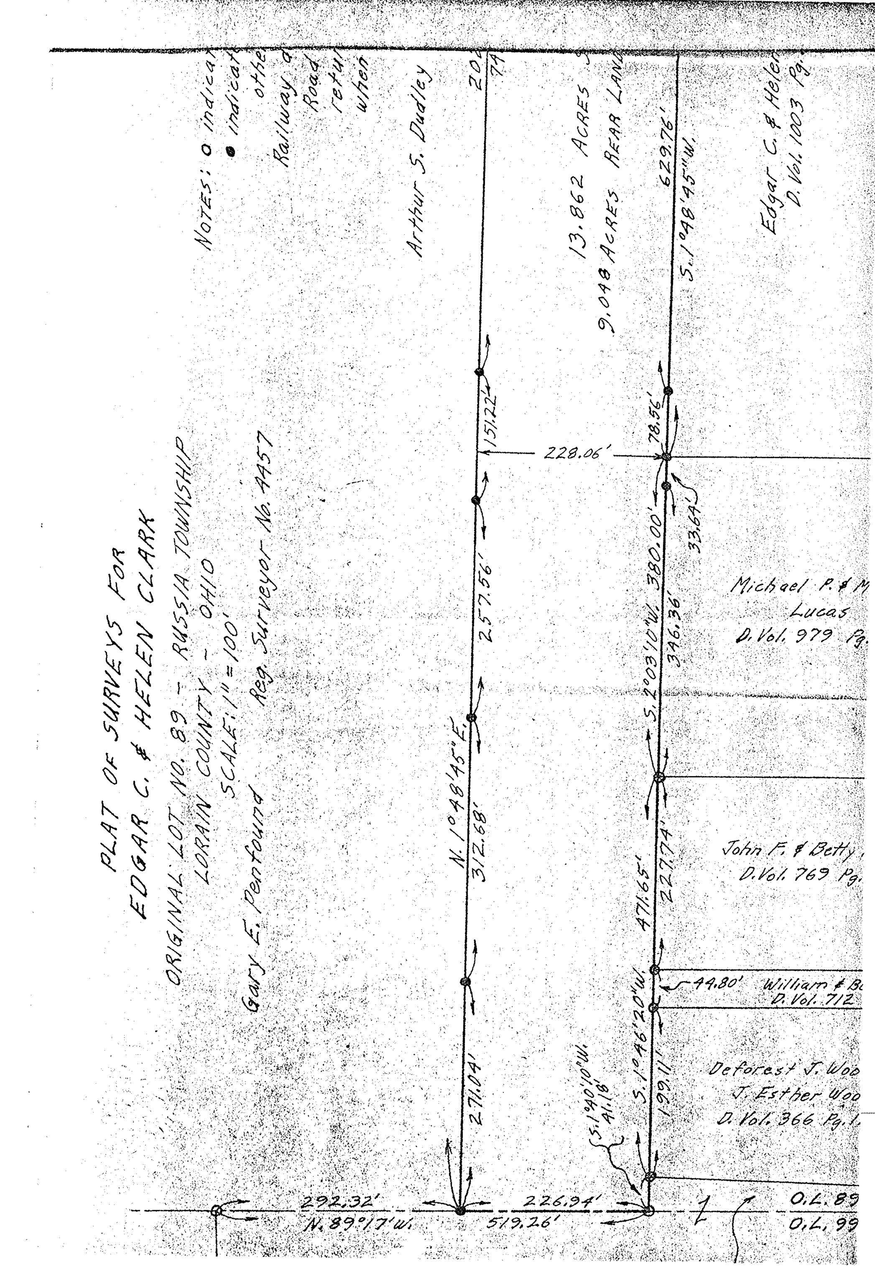
PLAT OF SURVEYS FOR
EDGAR C. & HELEN CLARK
ORIGINAL LOT NO. 89 - RUSSIA TOWNSHIP
LORAIN COUNTY - OHIO
SCALE: 1" = 100'
Gary E. Penfound Reg. Surveyor No. 7457
NOTES: ○ indicates
● indicates
Railway, &
Road
retur
when
Arthur S. Dudley
20
74
13.862 ACRES
9.048 ACRES REAR LAN
Edgar C. & Hele
D. Vol. 1003 Pg.
S. 1°48'45"W.
629.76'
78.56'
151.22'
228.06'
33.64'
Michael P. & M
Lucas
D. Vol. 979 Pg.
S. 2°03'10"W. 380.00'
396.36'
2577.56'
N. 1°48'45"E.
312.68'
John F. & Betty
D. Vol. 769 Pg.
471.65'
227.74'
S. 1°46'20"W.
44.80'
William & B
D. Vol. 712
Deforest J. Woo
J. Esther Woo
D. Vol. 366 Pg. 1
S. 1°46'20"W.
199.11'
S. 1°40'10"W.
41.18'
271.04'
292.32'
N. 89°17'W.
226.94'
S. 19.26'
O.L. 89
O.L. 99

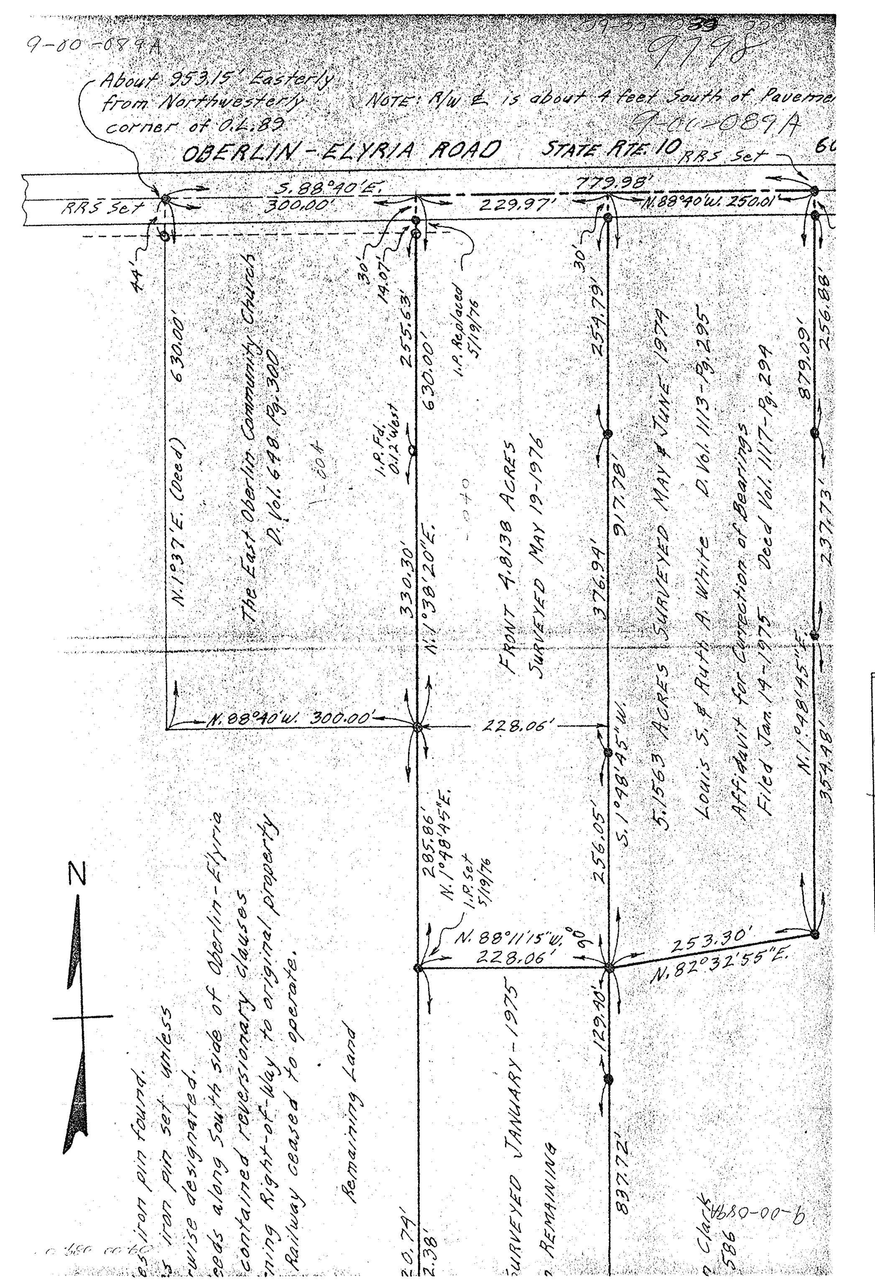
9-80-089A
About 953.15' Easterly
from Northwesterly
corner of O.L. 89
NOTE: R/W E. is about 4 feet South of Pavem
9-80-089A
OBERLIN-ELYRIA ROAD
STATE RTE 10
RRS Set
RRS Set
S. 88°40'E.
300.00'
229.97'
779.98'
N. 88°40'W. 250.00'
44'
30'
14.07'
I.P. Replaced 5/19/76
30'
N. 1°37'E. (Used)
630.00'
The East Oberlin Community Church
D. Vol. 678 Pg. 300
I.P. Fd. 0.1' West
630.00'
255.63'
253.79'
I.P. Replaced 5/19/76
FRONT 4.0138 ACRES
SURVEYED MAY 19-1976
N. 1°38'20"E.
330.30'
376.94'
917.78'
SURVEYED MAY & JUNE 1974
5.1563 ACRES
Louis S. & Ruth A. White D. Vol. 1113-Pg. 295
Affidavit for Correction of Bearings Deed Vol. 1117-Pg. 294
Filed Jan. 9-1975
879.09'
256.88'
237.73'
N. 1°48'45"E.
354.48'
N. 88°40'W. 300.00'
228.06'
285.86'
N. 1°48'45"E.
I.P. Set 5/19/76
256.05'
S. 1°48'45"W.
N. 88°11'15"W.
90°
228.06'
253.30'
N. 82°32'55"E.
129.40'
SURVEYED JANUARY - 1975
REMAINING
837.72'
N
Remaining Land
Iron pin found.
Iron pin set unless
wise designated.
eds along South side of Oberlin-Elyria
Contained reversionary clauses
ning Right-of-Way to original property
Railway ceased to operate.
Clark
586
9-80-00-b