MAP OF SURVEY, LOT SPLIT AND ASSEMBLY

PREPARED FOR

ROBERT L. KING

LOCATED IN THE TOWNSHIP OF RUSSIA, COUNTY OF LORAIN, STATE OF OHIO
AND BEING PART OF ORIGINAL RUSSIA TOWNSHIP LOT NO. 14

SURVEYOR'S STATEMENT

Rev. 7-6-93
5-20-93

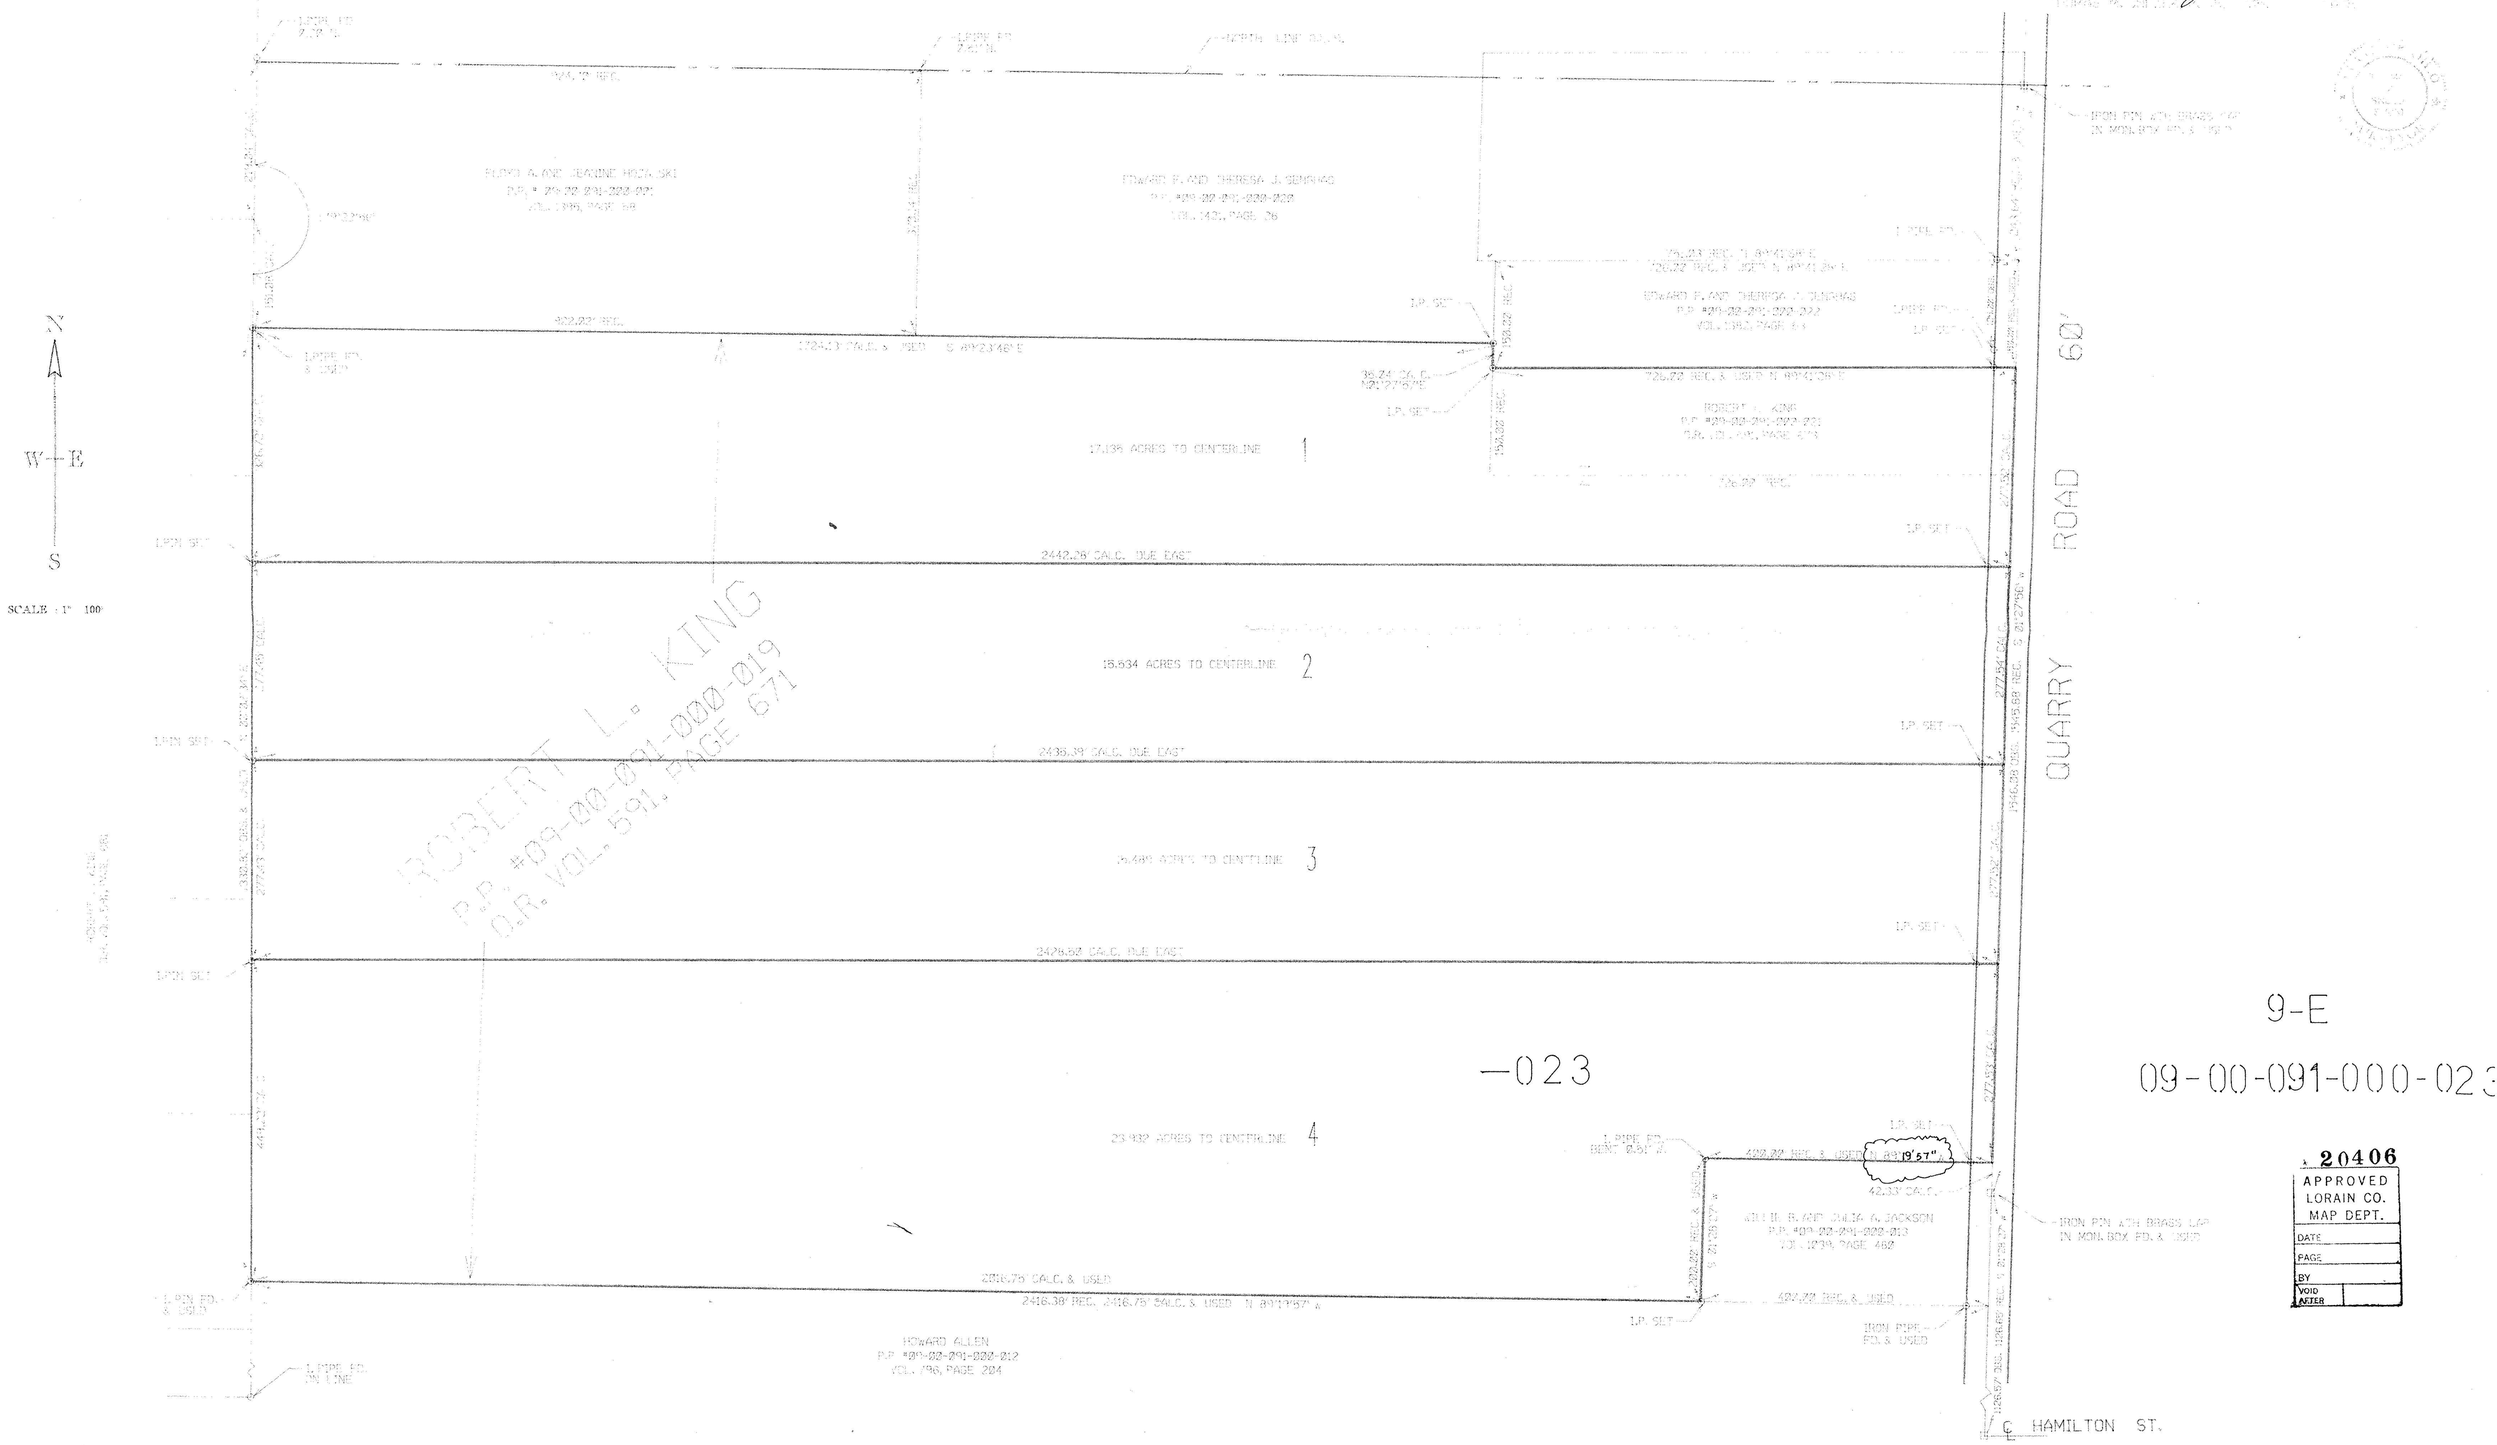

20406
APPROVED
LORAIN CO.
MAP DEPT.
DATE
PAGE
BY
VOID AFTER

9309