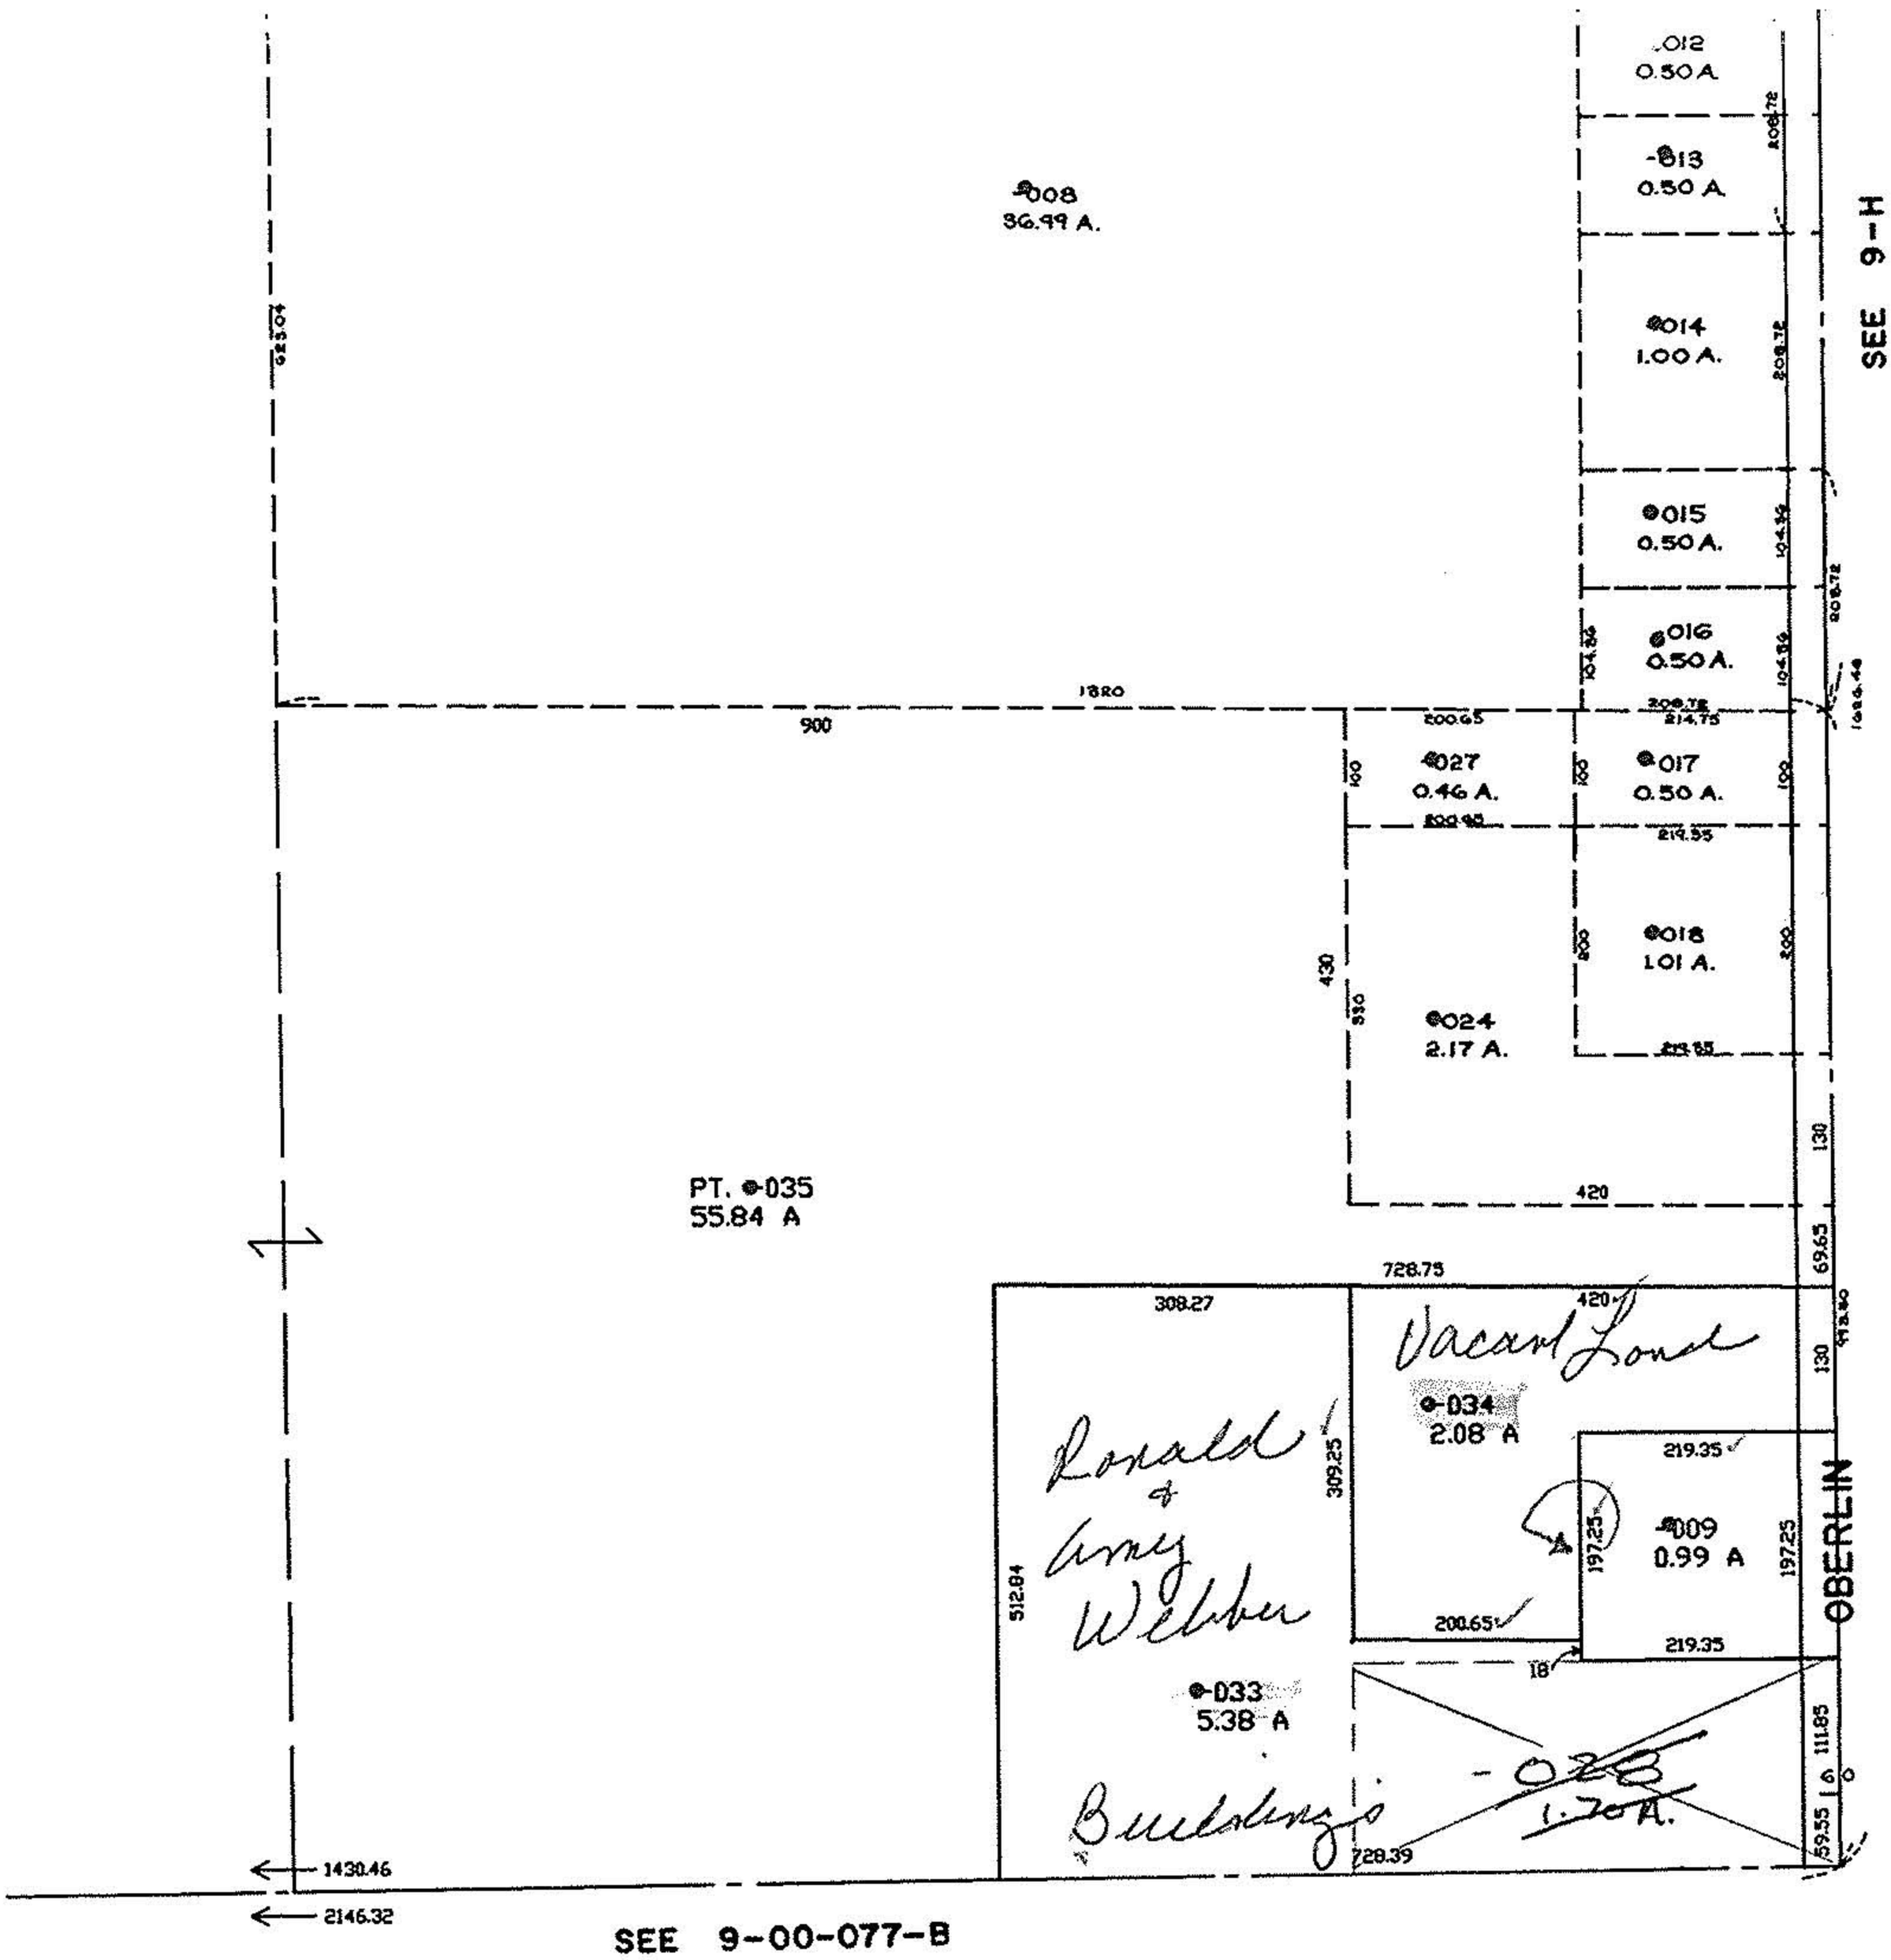

100 200

12 LOT 67

RUSSIA TWP.

OUT 2/1/01

REVISE
9-00

9.00-067-A&B

[redacted] 01-00509-X