


09-00-103-000-

9-00-103-A

9664
OL
9-00-103-A

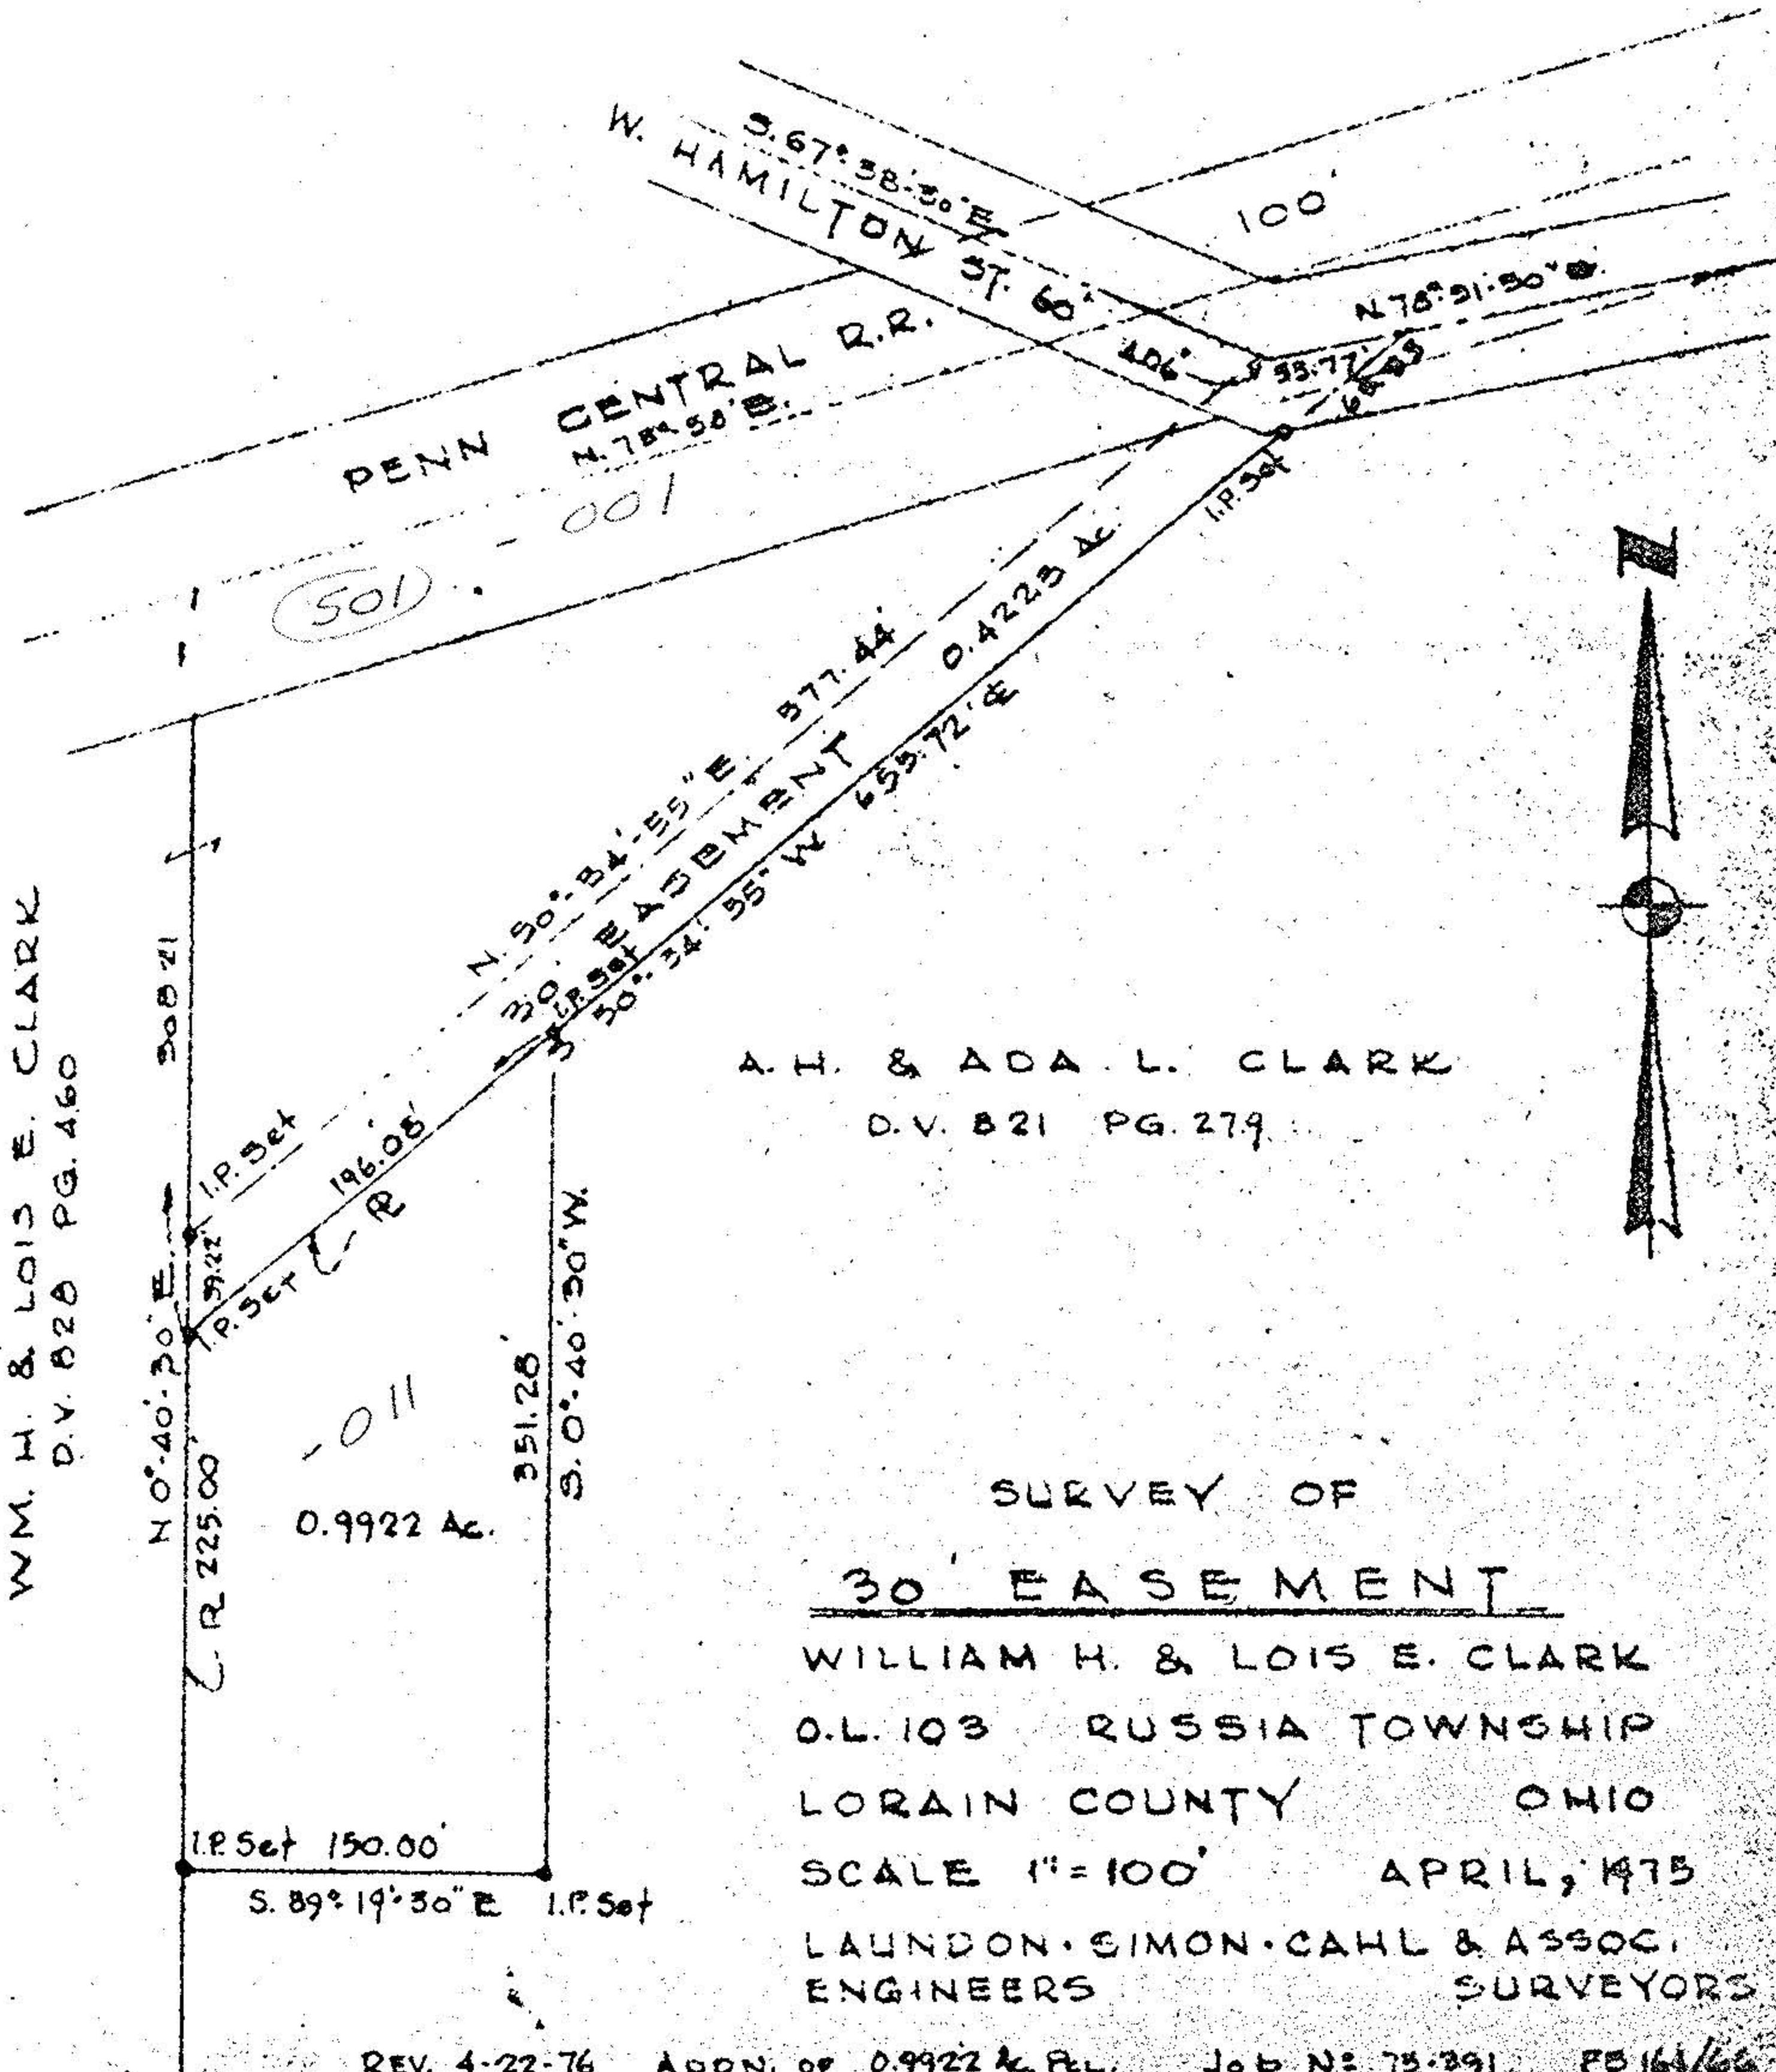

WM. H. & LOIS E. CLARK
D.V. B28 PG. 460

N 0° 40' 30" E 308.21
 I.P. Set 196.05'
 I.P. Set 150.00'
 S. 89° 19' 30" E I.P. Set
 351.28'
 S. 0° 40' 30" W
 0.9922 Ac.

(501)

011

W. HAMILTON ST. 60'

PENN CENTRAL R.R.
N. 78° 58' B.

 30' EASEMENT 0.4223 Ac.
 I.P. Set

100'

N 78° 51' 30" E

A. H. & ADA L. CLARK
D.V. B21 PG. 279

SURVEY OF

30' EASEMENT

WILLIAM H. & LOIS E. CLARK
O.L. 103 RUSSIA TOWNSHIP
LORAIN COUNTY OHIO

SCALE 1" = 100' APRIL, 1975

LAUNDON · SIMON · CAHL & ASSOC.
ENGINEERS SURVEYORS

