Land Exchange For Habitat

Sublots 7,8 & 9 in Follett,s First **Addition Vol. 2 Pg. 1**

City of Oberlin:Lorain County:Ohio

Part of Original Russia Twp. Lot 95.
P.P.N's 9-00-095-102 -026,-027 & -028

SCALE 1"=30'
February 1995

Distances are in feet and decimals:
Bearings are for calculations only:

Vincent C. McGervey,
Consulting Engineer
& Surveyor #4289
2643 Joseph Street
Avon, Ohio 44011
871-4075 937-5353

STATE OF OHIO
VINCENT C. McGERVEY 4289
REGISTERED SURVEYOR

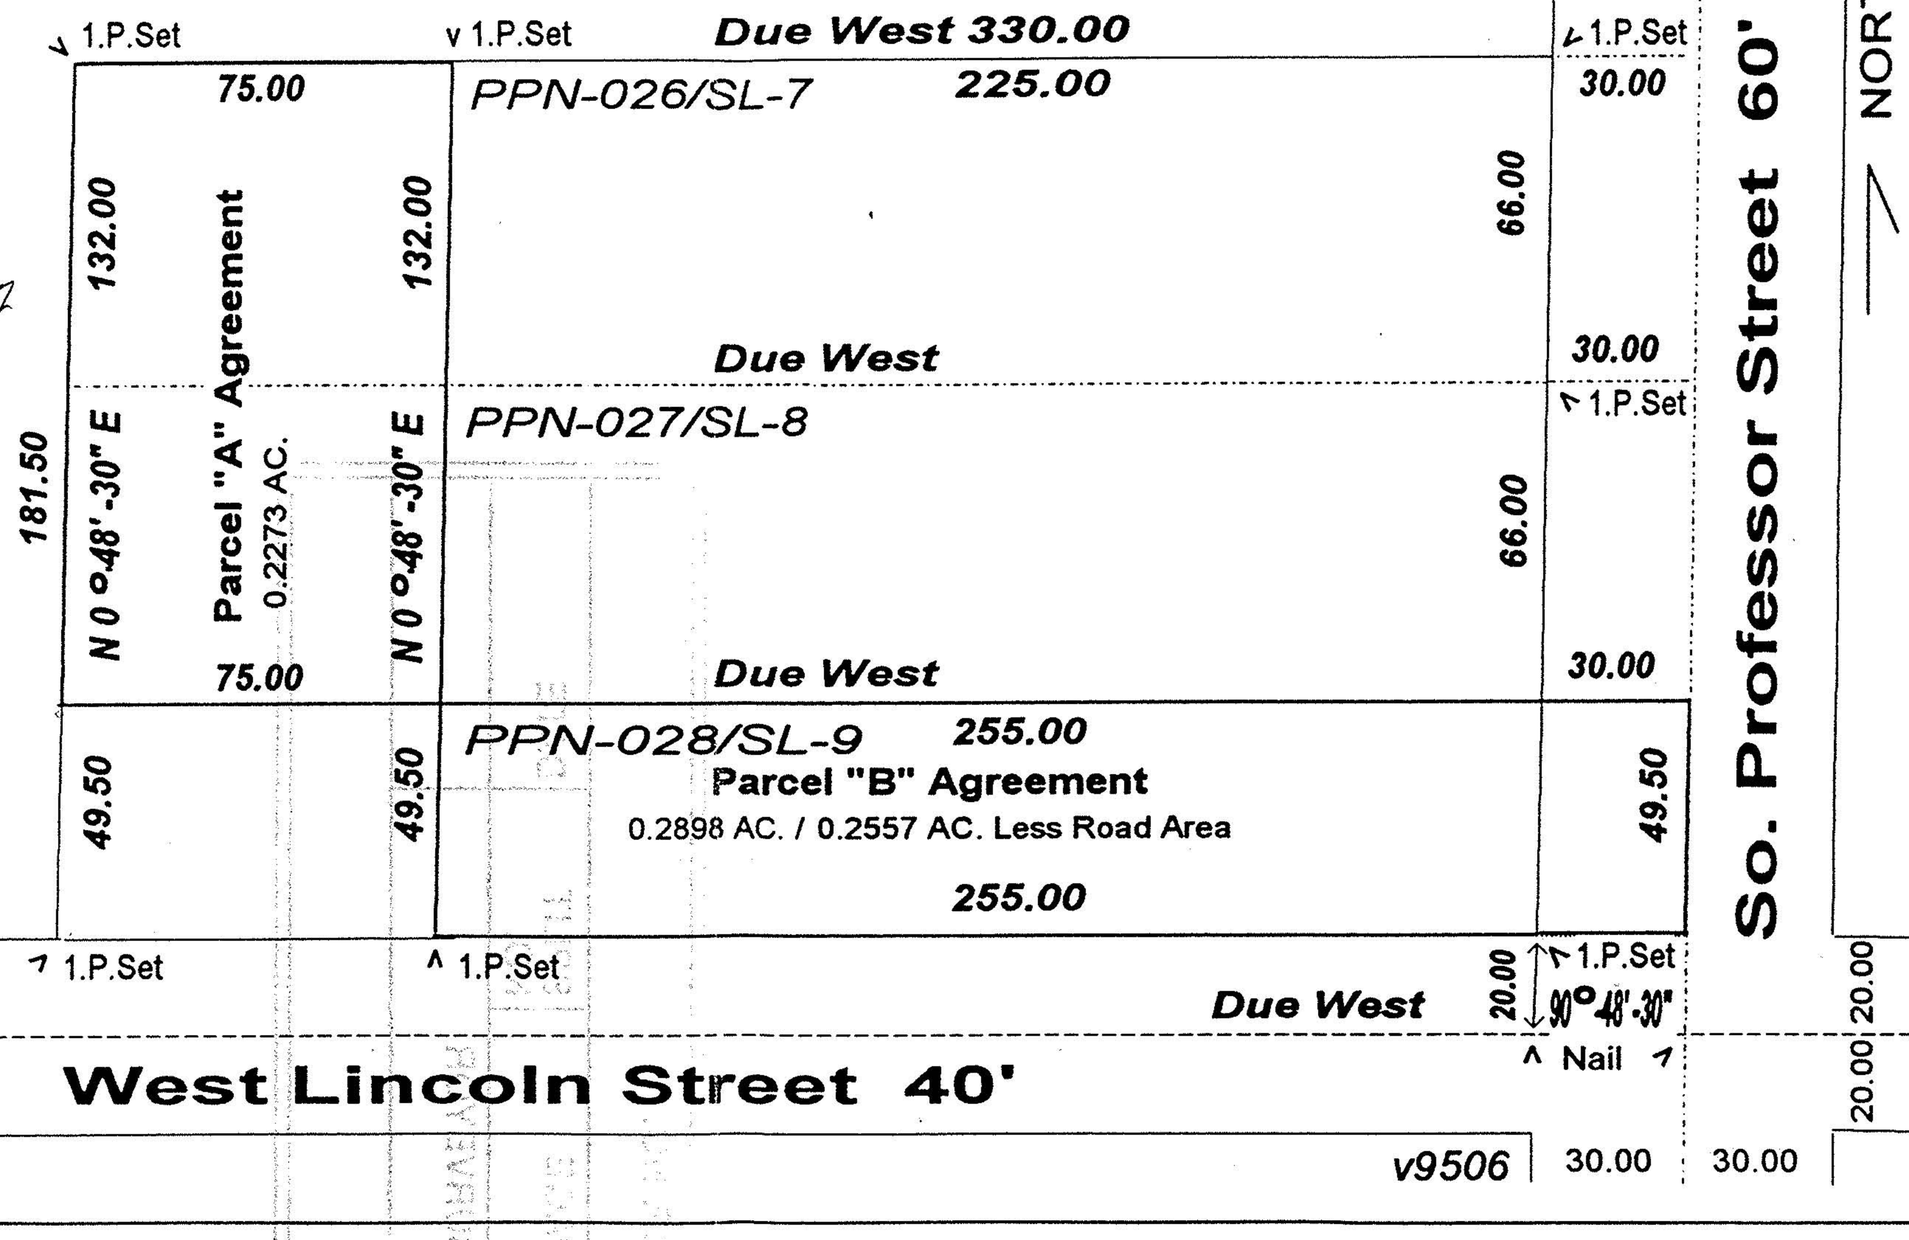

AJM for Habitat February 1995