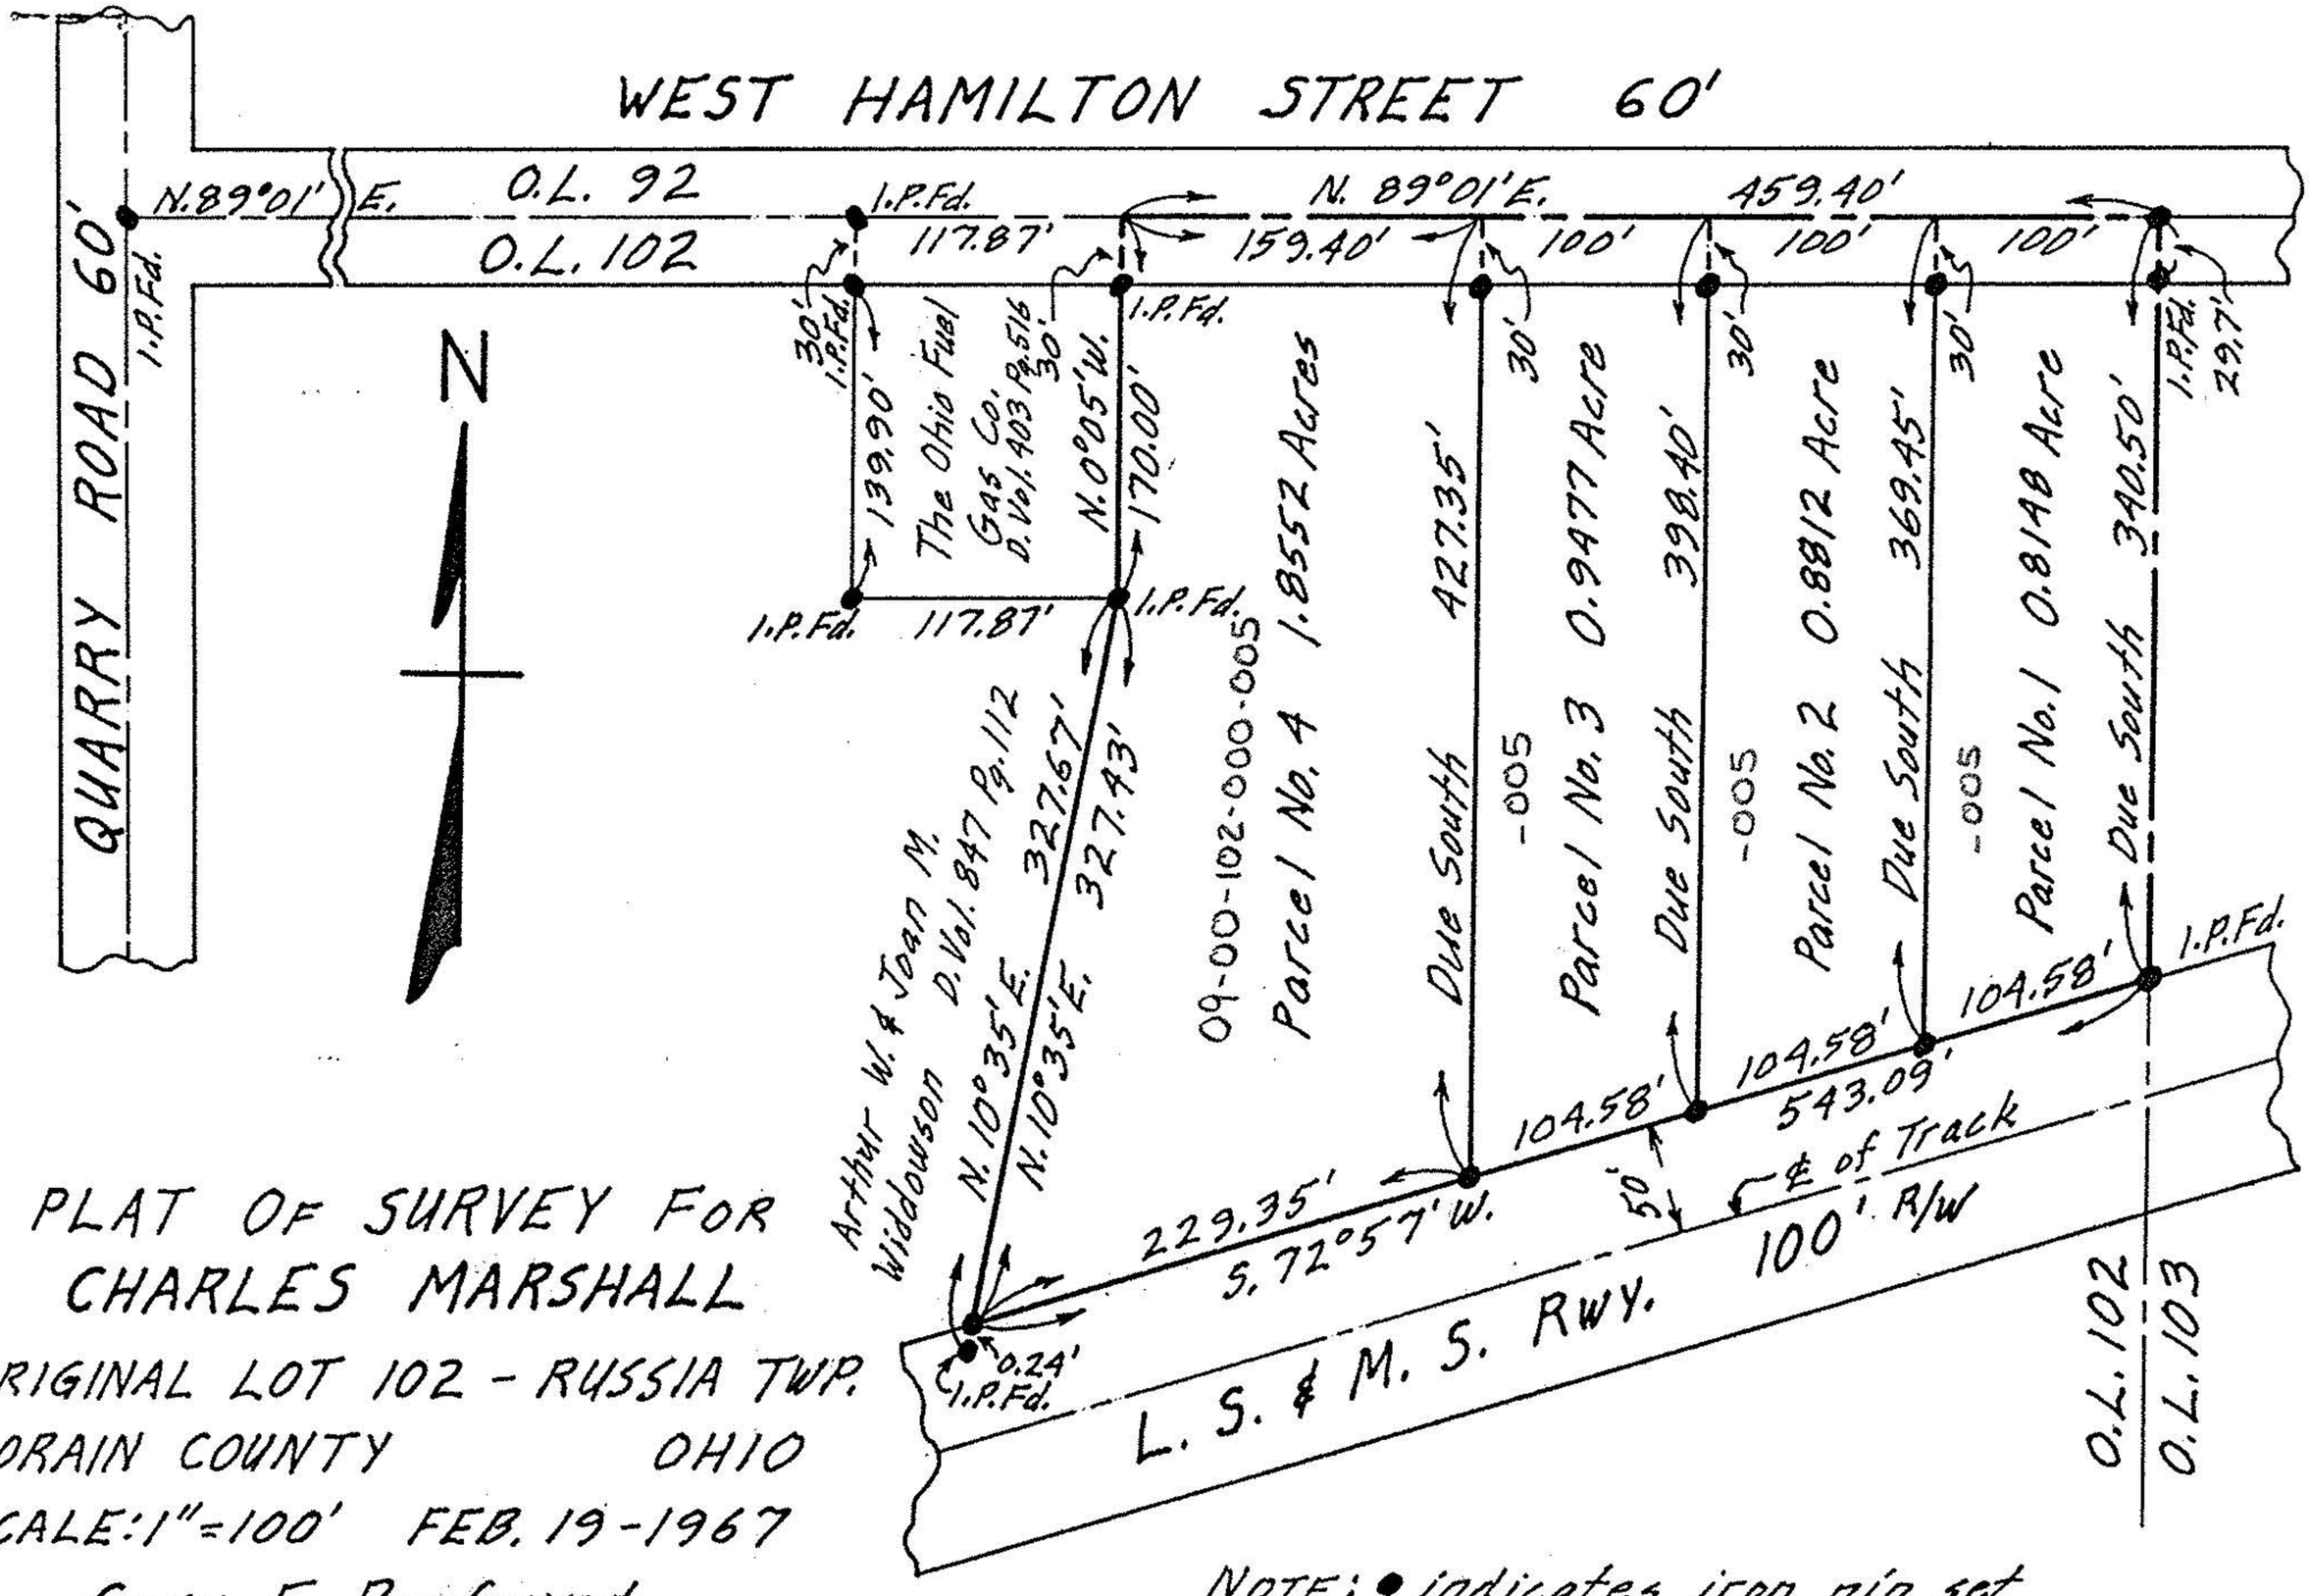

PLAT OF SURVEY FOR
CHARLES MARSHALL
ORIGINAL LOT 102 - RUSSIA TWP.
LORAIN COUNTY OHIO
SCALE: 1"=100' FEB. 19-1967
Gary E. Penfound
Reg. Surveyor No. 4457

NOTE: ● indicates iron pin set unless otherwise designated.