


7019

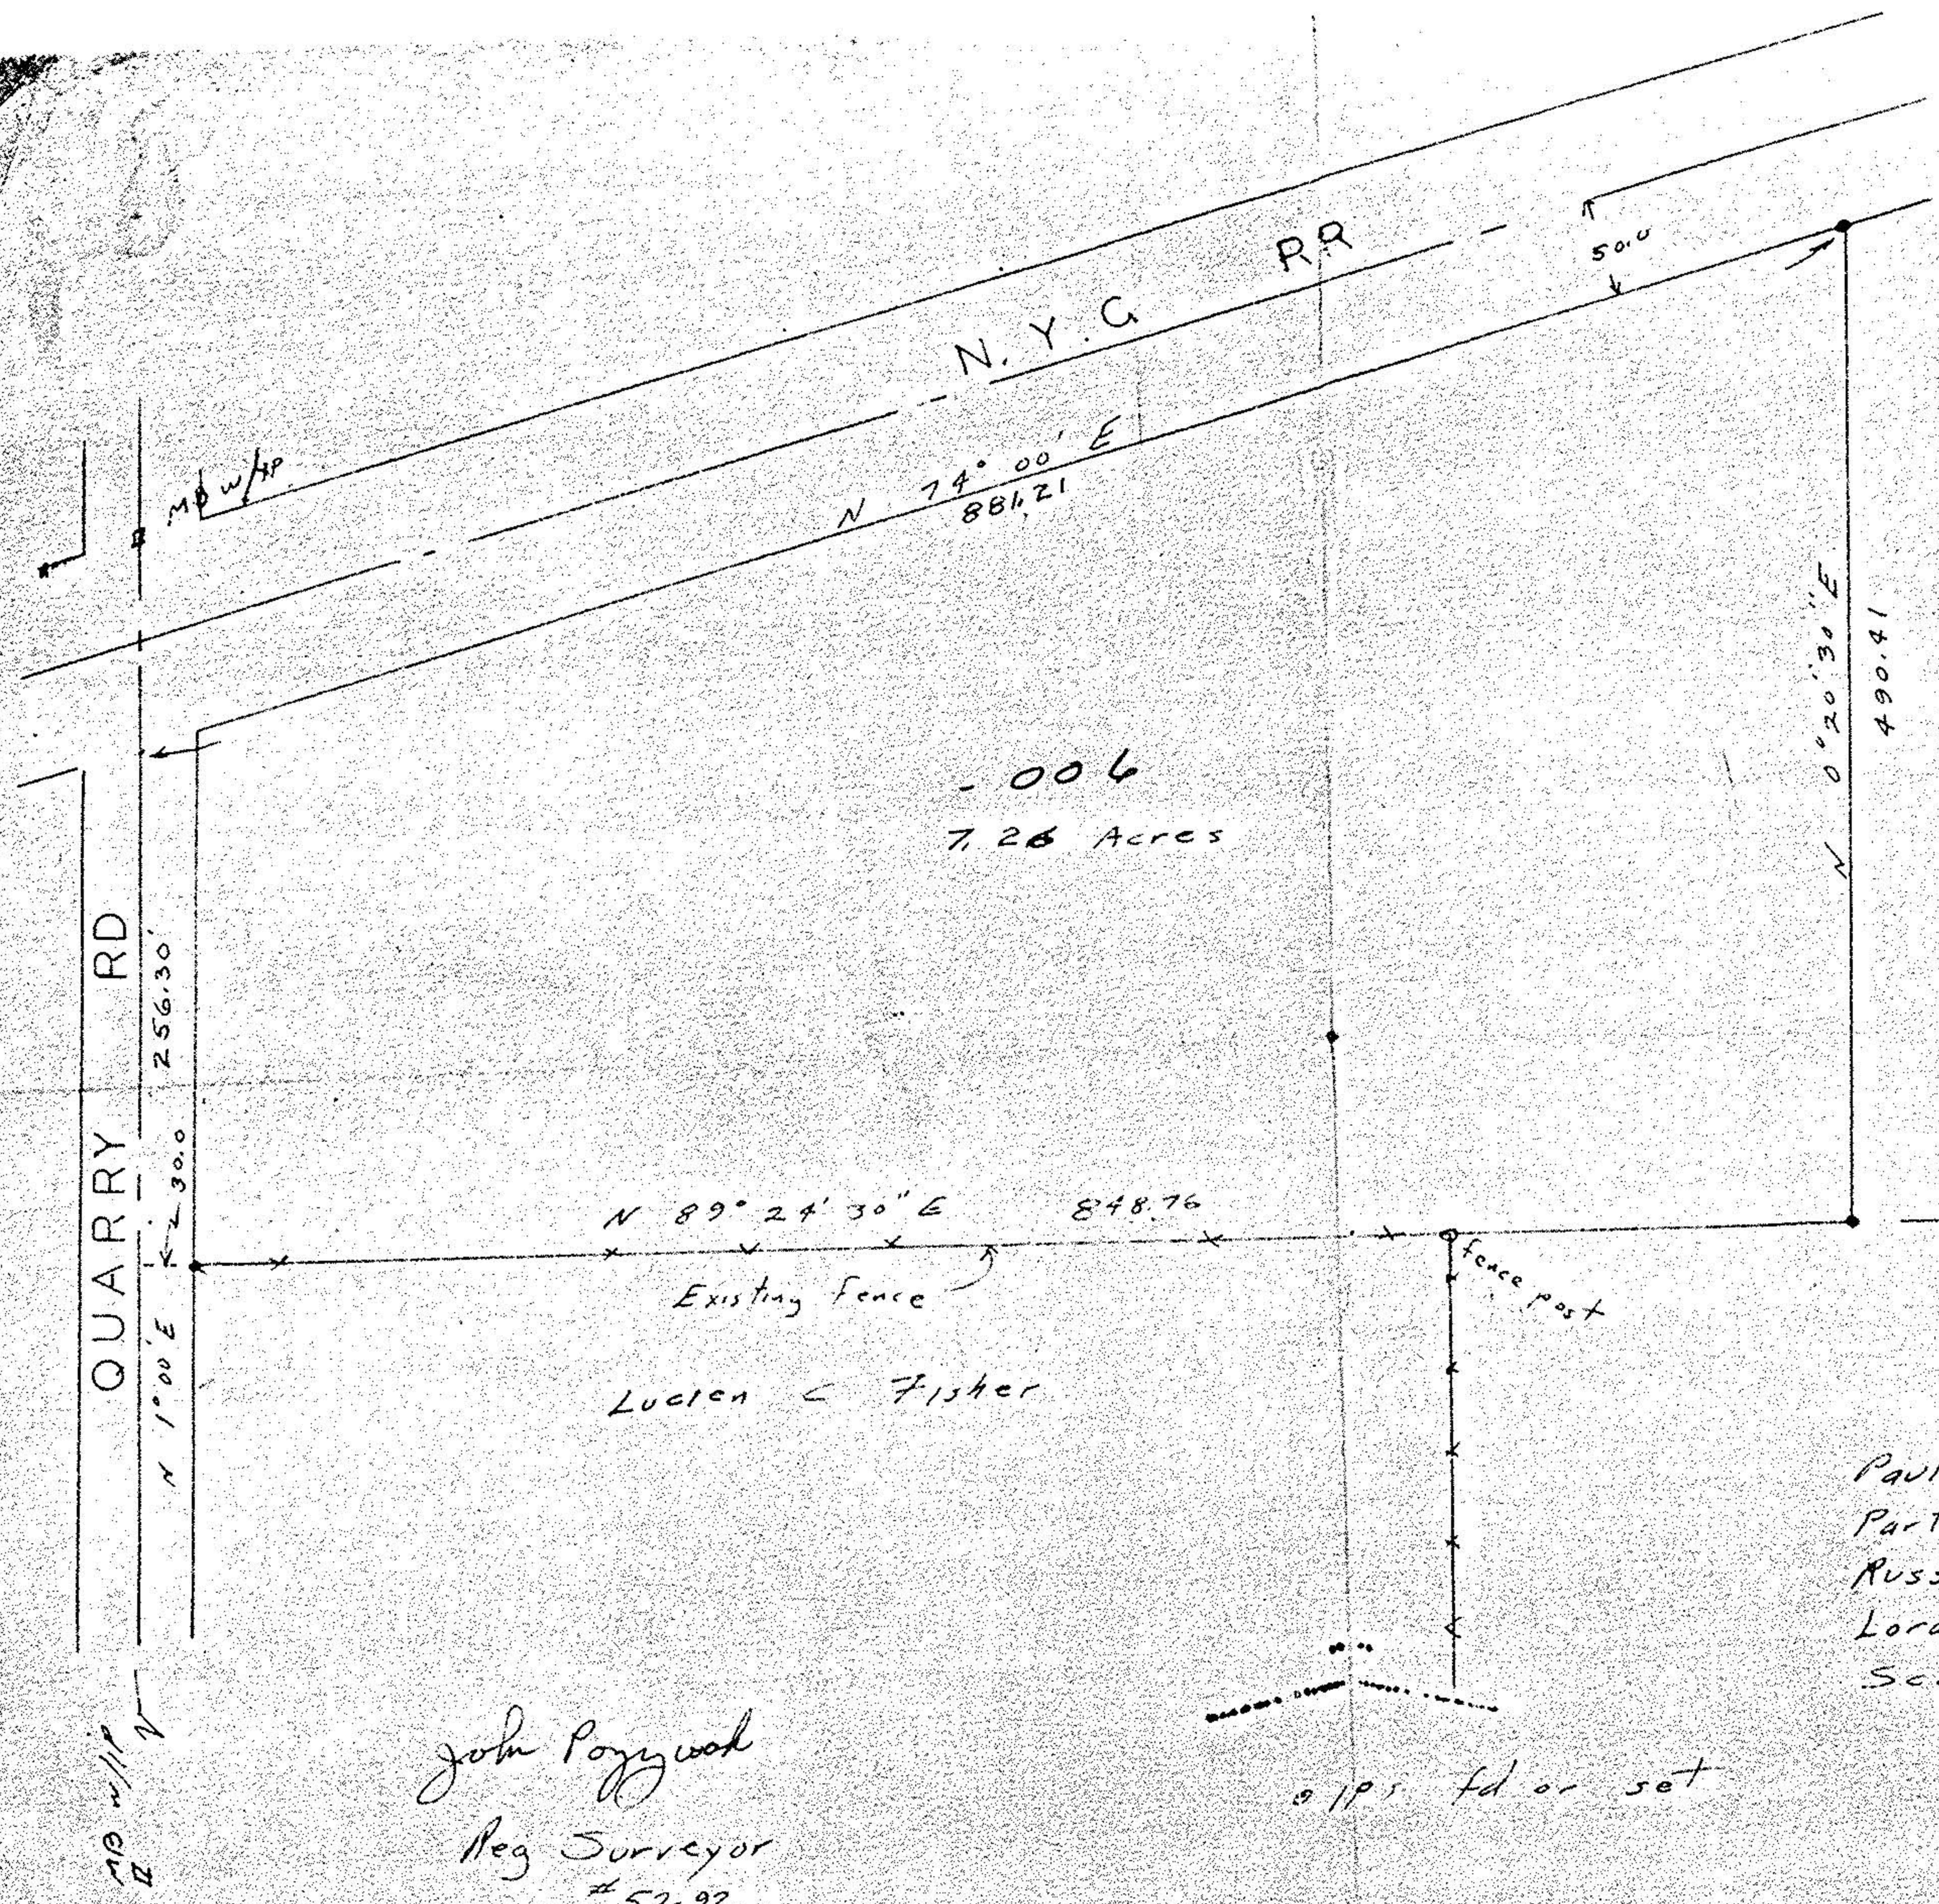

Thelma Smith  
p. Vol 1019 Pg 878

Lucien C Fisher

Survey for  
Paul D. & Marion E. Gordon  
Part of Original Lot 102  
Russia Township  
Lorain County Ohio  
Scale 1" = 100' June 17, 1972

John Pozzywak  
Reg Surveyor  
#5292