


NORTH
 SCALE: 1" = 200'

LEGEND:
 ○ = IRON PIN SET
 ● = IRON PIN FOUND

Ac. breakdown per Lot
 MISSING.

20924
 APPROVED
 LORAIN CO.
 MAP DEPT.
 DATE 7-7-94
 PAGE 9-00-0998
 BY CAROLYN FRANCIS
 # 20924

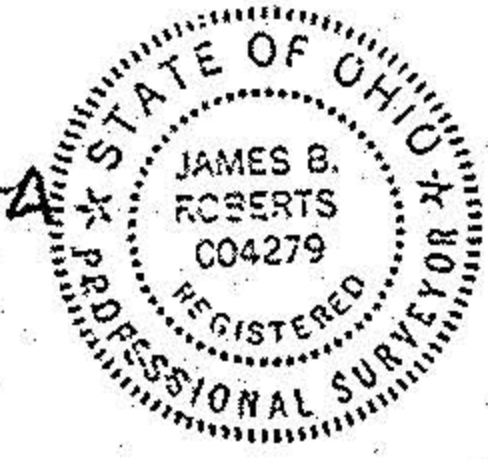

MAP of PROPOSED PARCEL SPLIT
PREPARED FOR MICHAEL VISNIC
PART of ORIGINAL RUSSIA TWP. LOT Nos. 99 & 100
TOWNSHIP of RUSSIA, LORAIN COUNTY, OHIO
 REF: SPLIT FROM 09-00-099-000-071 & 09-00-100-000-005

K.E. MCCARTNEY & ASSOCIATES
ENGINEERS - SURVEYORS
ELTRIA, OHIO
FEBRUARY, 1994 #945075