


21917

APPROVED
LORAIN CO.
MAP DEPT.
DATE 10-4-96
PAGE 9-00-098-A
BY K.DVE
VOID AFTER # 21917

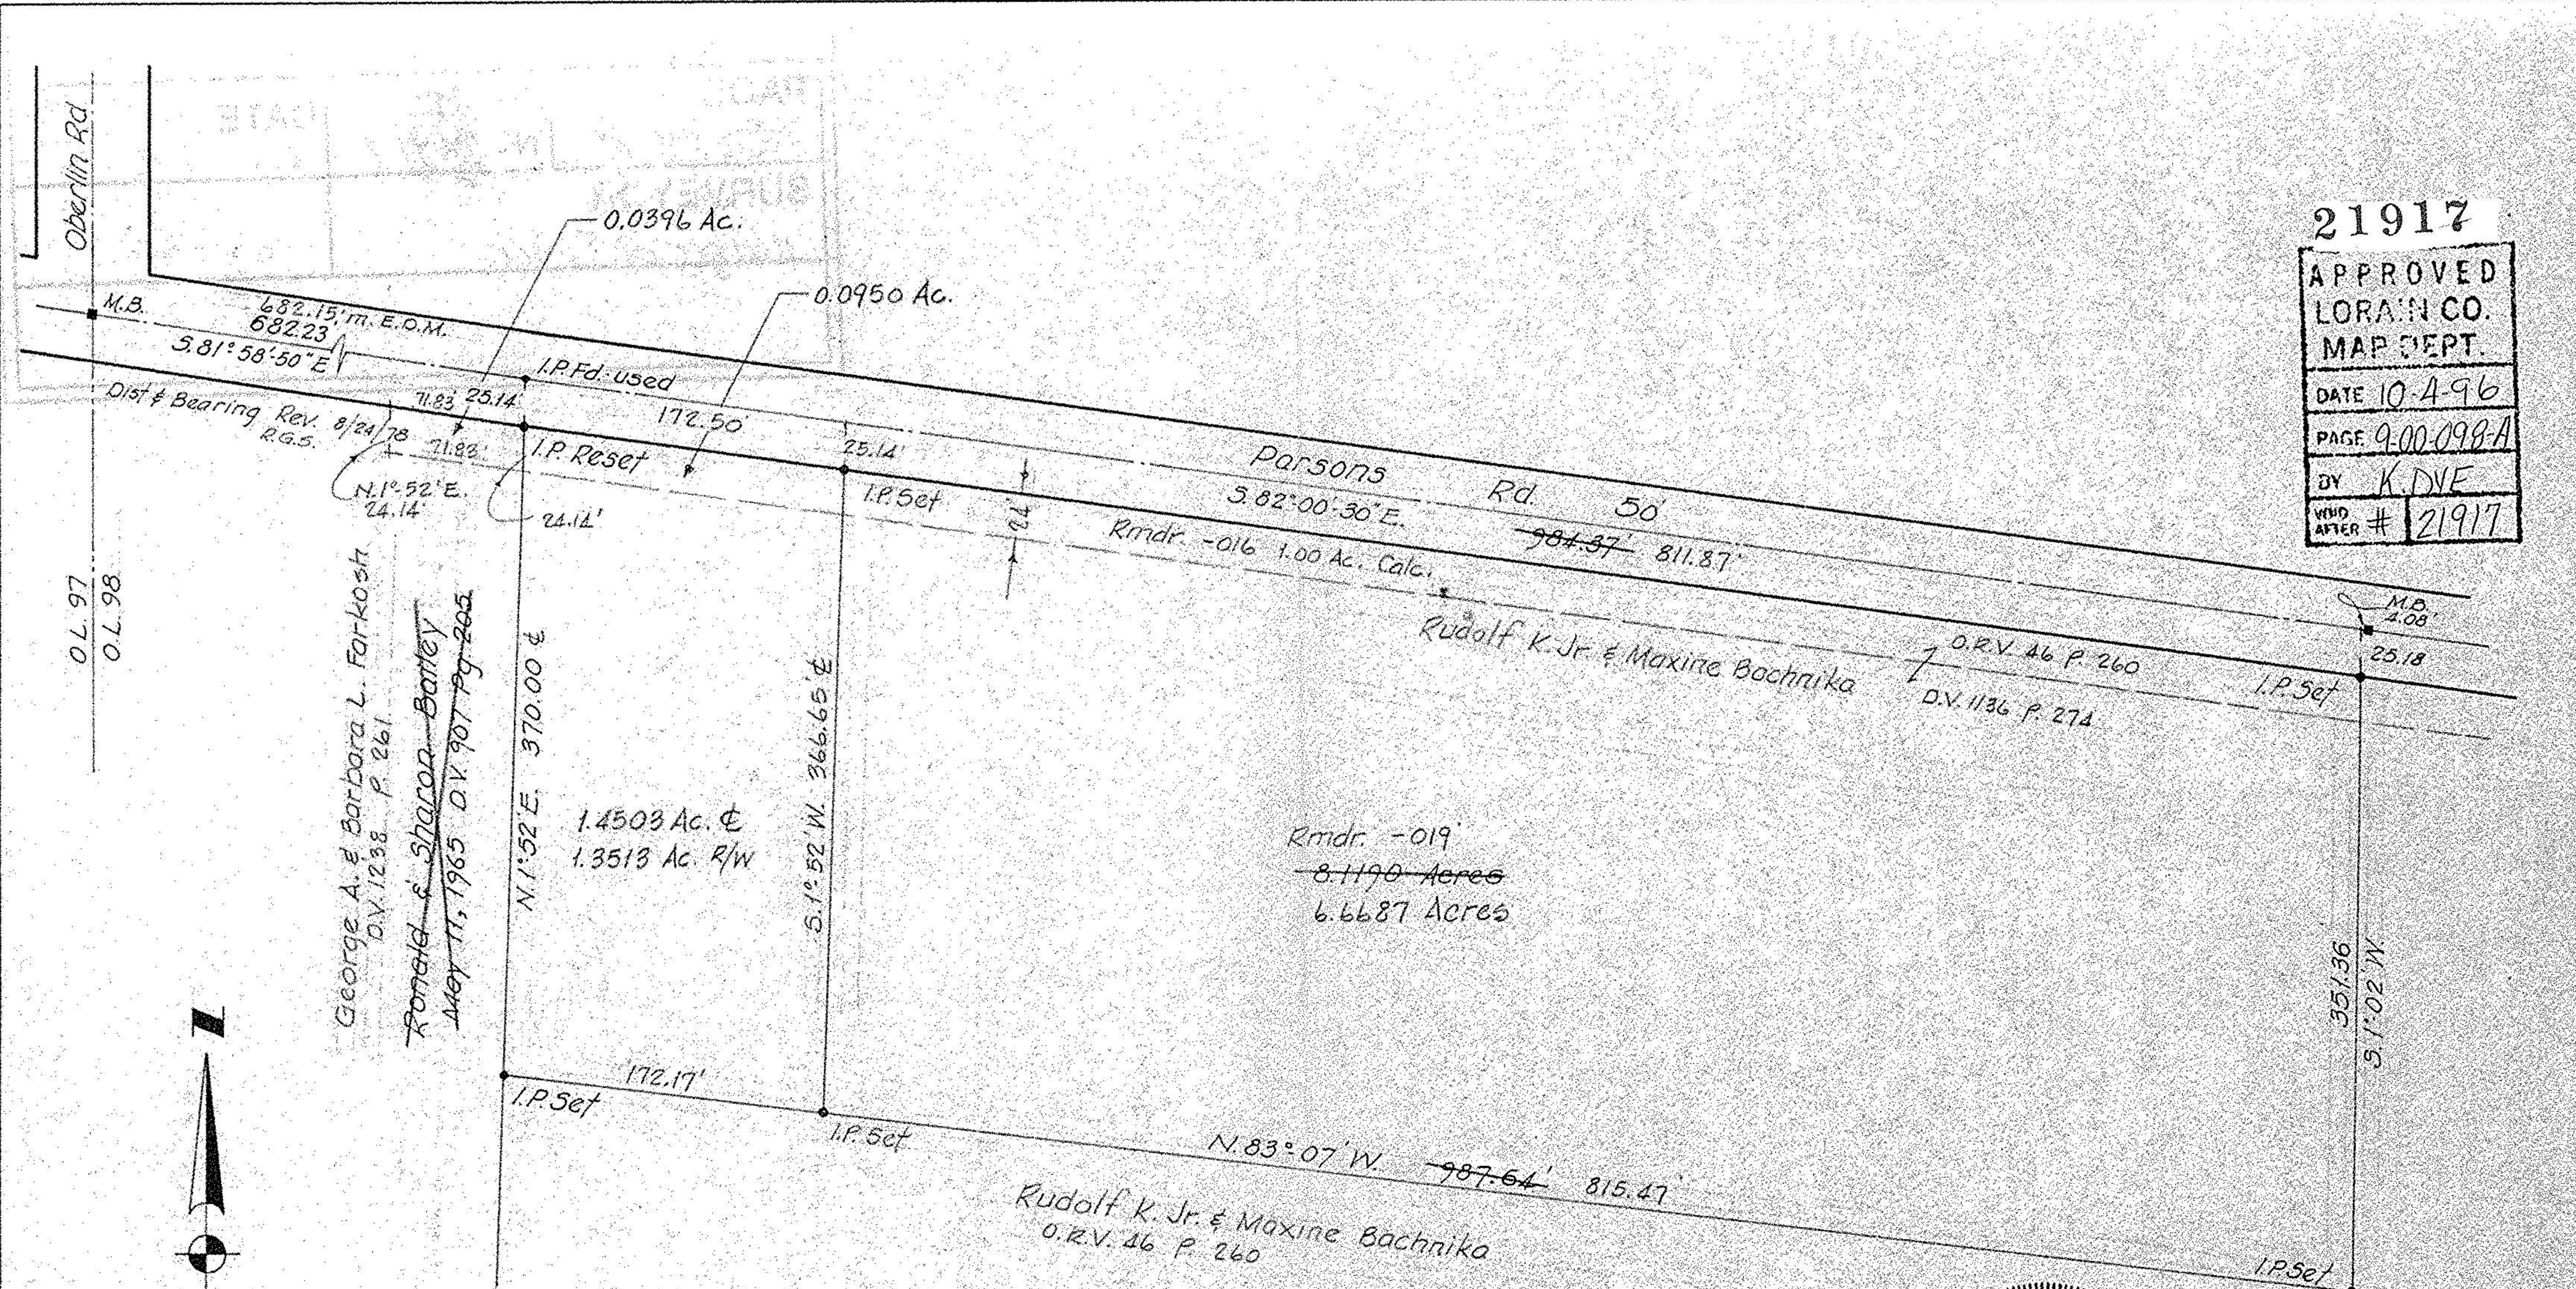

Survey for
Rudolf Jr. & Maxine Bachnika

Part of O.L. 98 New Russia Township
 County of Lorain State of Ohio
 Scale 1"=80' Oct. 22, 1975
 Laundon Simon Cahl & Assoc.
 Engineers Surveyors

