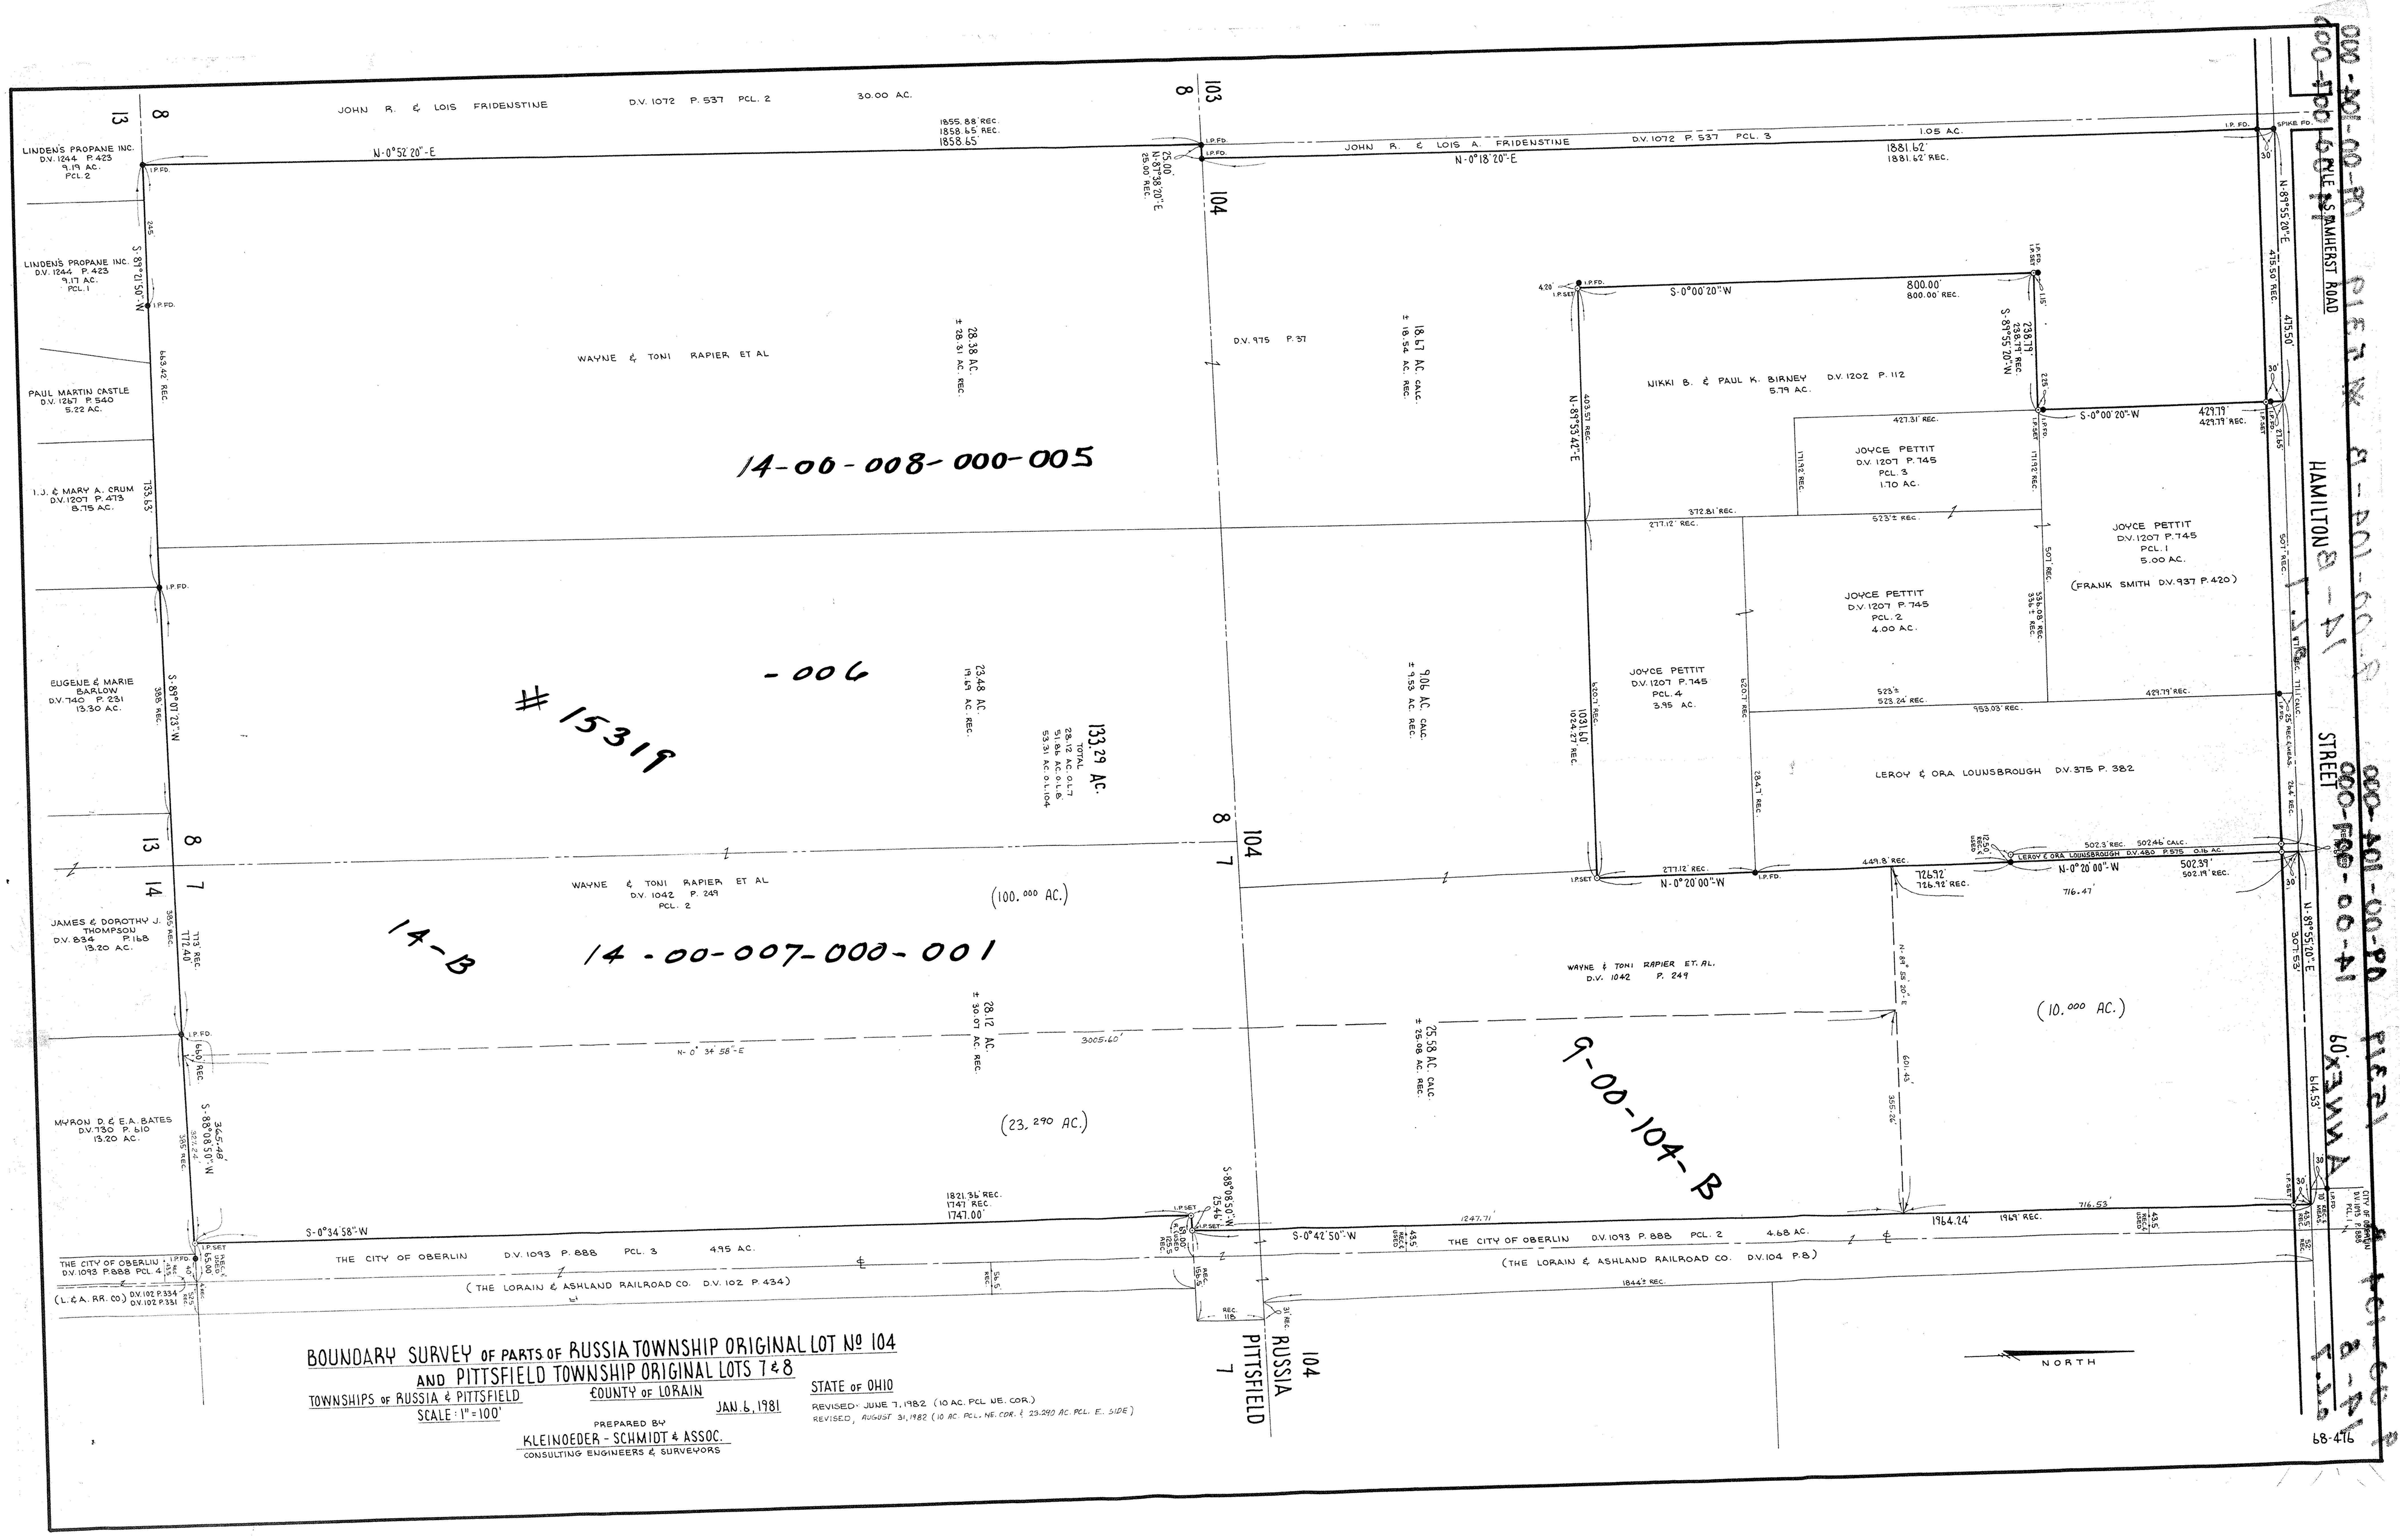
JOHN R. & LOIS FRIDENSTINE D.V. 1072 P. 537 PCL. 2 30.00 AC.
JOHN R. & LOIS A. FRIDENSTINE D.V. 1072 P. 537 PCL. 3 1.05 AC.
LINDEN'S PROPANE INC. D.V. 1244 P. 423 9.19 AC. PCL. 2
LINDEN'S PROPANE INC. D.V. 1244 P. 423 9.17 AC. PCL. 1
PAUL MARTIN CASTLE D.V. 1267 P. 540 5.22 AC.
I.J. & MARY A. CRUM D.V. 1207 P. 473 8.75 AC.
EUGENE & MARIE BARLOW D.V. 740 P. 231 13.30 AC.
JAMES & DOROTHY J. THOMPSON D.V. 834 P. 168 13.20 AC.
MYRON D. & E.A. BATES D.V. 750 P. 610 13.20 AC.
WAYNE & TONI RAPIER ET AL
14-00-008-000-005
D.V. 975 P. 37
NIKKI B. & PAUL K. BIRNEY D.V. 1202 P. 112 5.79 AC.
JOYCE PETTIT D.V. 1207 P. 745 PCL. 3 1.70 AC.
JOYCE PETTIT D.V. 1207 P. 745 PCL. 1 5.00 AC. (FRANK SMITH D.V. 937 P. 420)
JOYCE PETTIT D.V. 1207 P. 745 PCL. 2 4.00 AC.
JOYCE PETTIT D.V. 1207 P. 745 PCL. 4 3.95 AC.
LEROY & ORA LOUNSBROUGH D.V. 375 P. 382
LEROY & ORA LOUNSBROUGH D.V. 480 P. 575 0.16 AC.
WAYNE & TONI RAPIER ET AL D.V. 1042 P. 249 PCL. 2
(100.000 AC.)
14-B
14-00-007-000-001
WAYNE & TONI RAPIER ET. AL. D.V. 1042 P. 249
(10.000 AC.)
9-00-104-B
(23.290 AC.)
THE CITY OF OBERLIN D.V. 1093 P. 888 PCL. 3 4.95 AC.
THE CITY OF OBERLIN D.V. 1093 P. 888 PCL. 2 4.68 AC.
(THE LORAIN & ASHLAND RAILROAD CO. D.V. 102 P. 434)
(THE LORAIN & ASHLAND RAILROAD CO. D.V. 104 P. 8)
(L. & A. RR. CO.) D.V. 102 P. 334 D.V. 102 P. 331
THE CITY OF OBERLIN D.V. 1093 P. 888 PCL. 4
#15319
-006
133.29 AC. TOTAL
28.12 AC. O.L. 7
51.84 AC. O.L. 8
53.31 AC. O.L. 104
HAMILTON ROAD
STREET
RUSSIA
PITTSFIELD
104
7
8
13
14
NORTH
BOUNDARY SURVEY OF PARTS OF RUSSIA TOWNSHIP ORIGINAL LOT Nº 104
AND PITTSFIELD TOWNSHIP ORIGINAL LOTS 7 & 8
TOWNSHIPS OF RUSSIA & PITTSFIELD
COUNTY OF LORAIN
STATE OF OHIO
SCALE: 1" = 100'
JAN. 6, 1981
REVISED: JUNE 7, 1982 (10 AC. PCL. NE. COR.)
REVISED, AUGUST 31, 1982 (10 AC. PCL. NE. COR. & 23.290 AC. PCL. E. SIDE)
PREPARED BY
KLEINOEDER - SCHMIDT & ASSOC.
CONSULTING ENGINEERS & SURVEYORS
68-476