



COUNTY OF MEDINA DATE
 TOWNSHIP, VILLAGE, CITY CARLISLE LOT 101 TRACT
 SUBDIVISION _____ SUBLOT # _____
 PROPERTY OWNER RAY WENSINK to Smith 5542

#5542 10-00-009-101

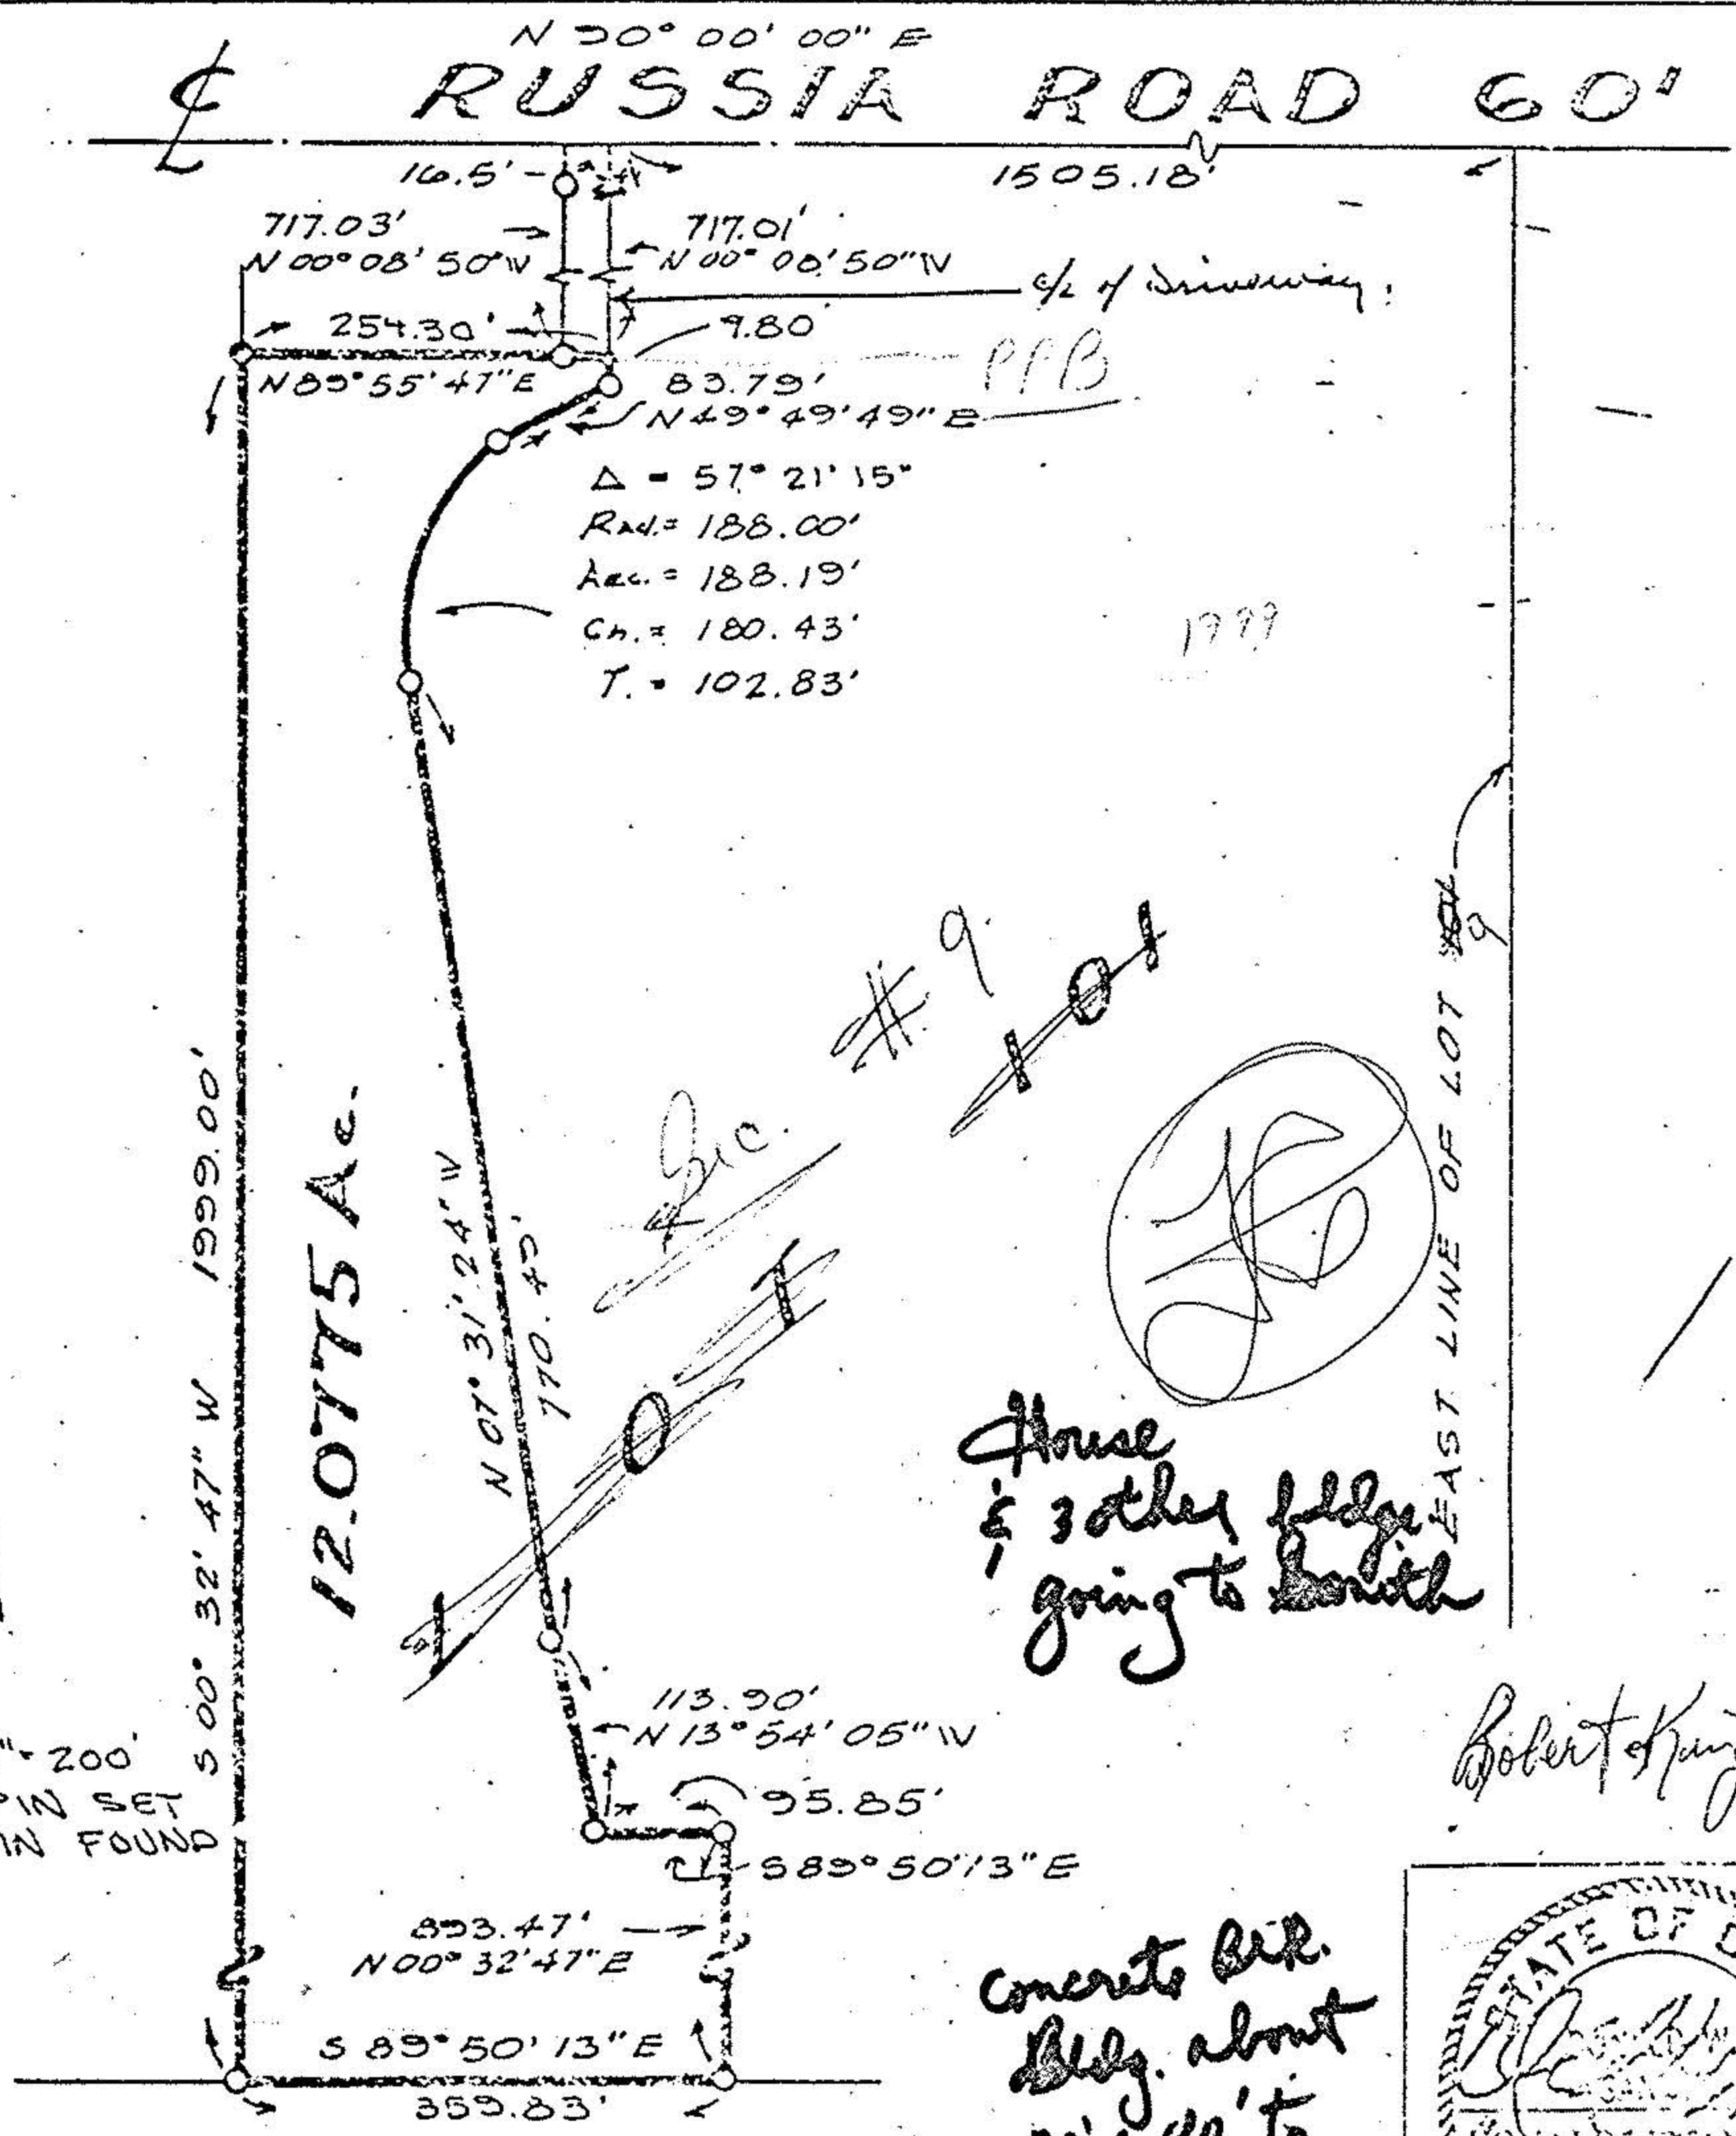

SANNEY ASSOCIATES
 ENGINEERS SURVEYORS

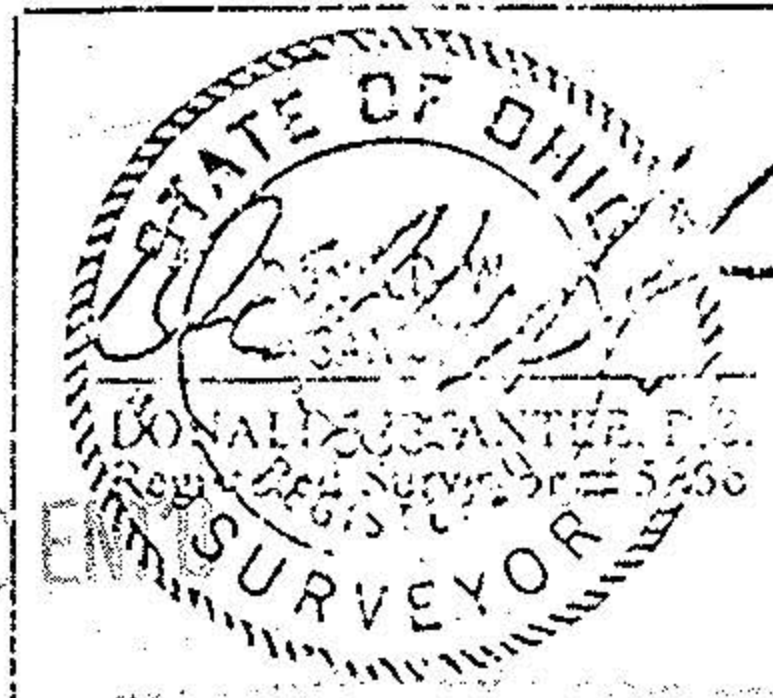

MAR 20