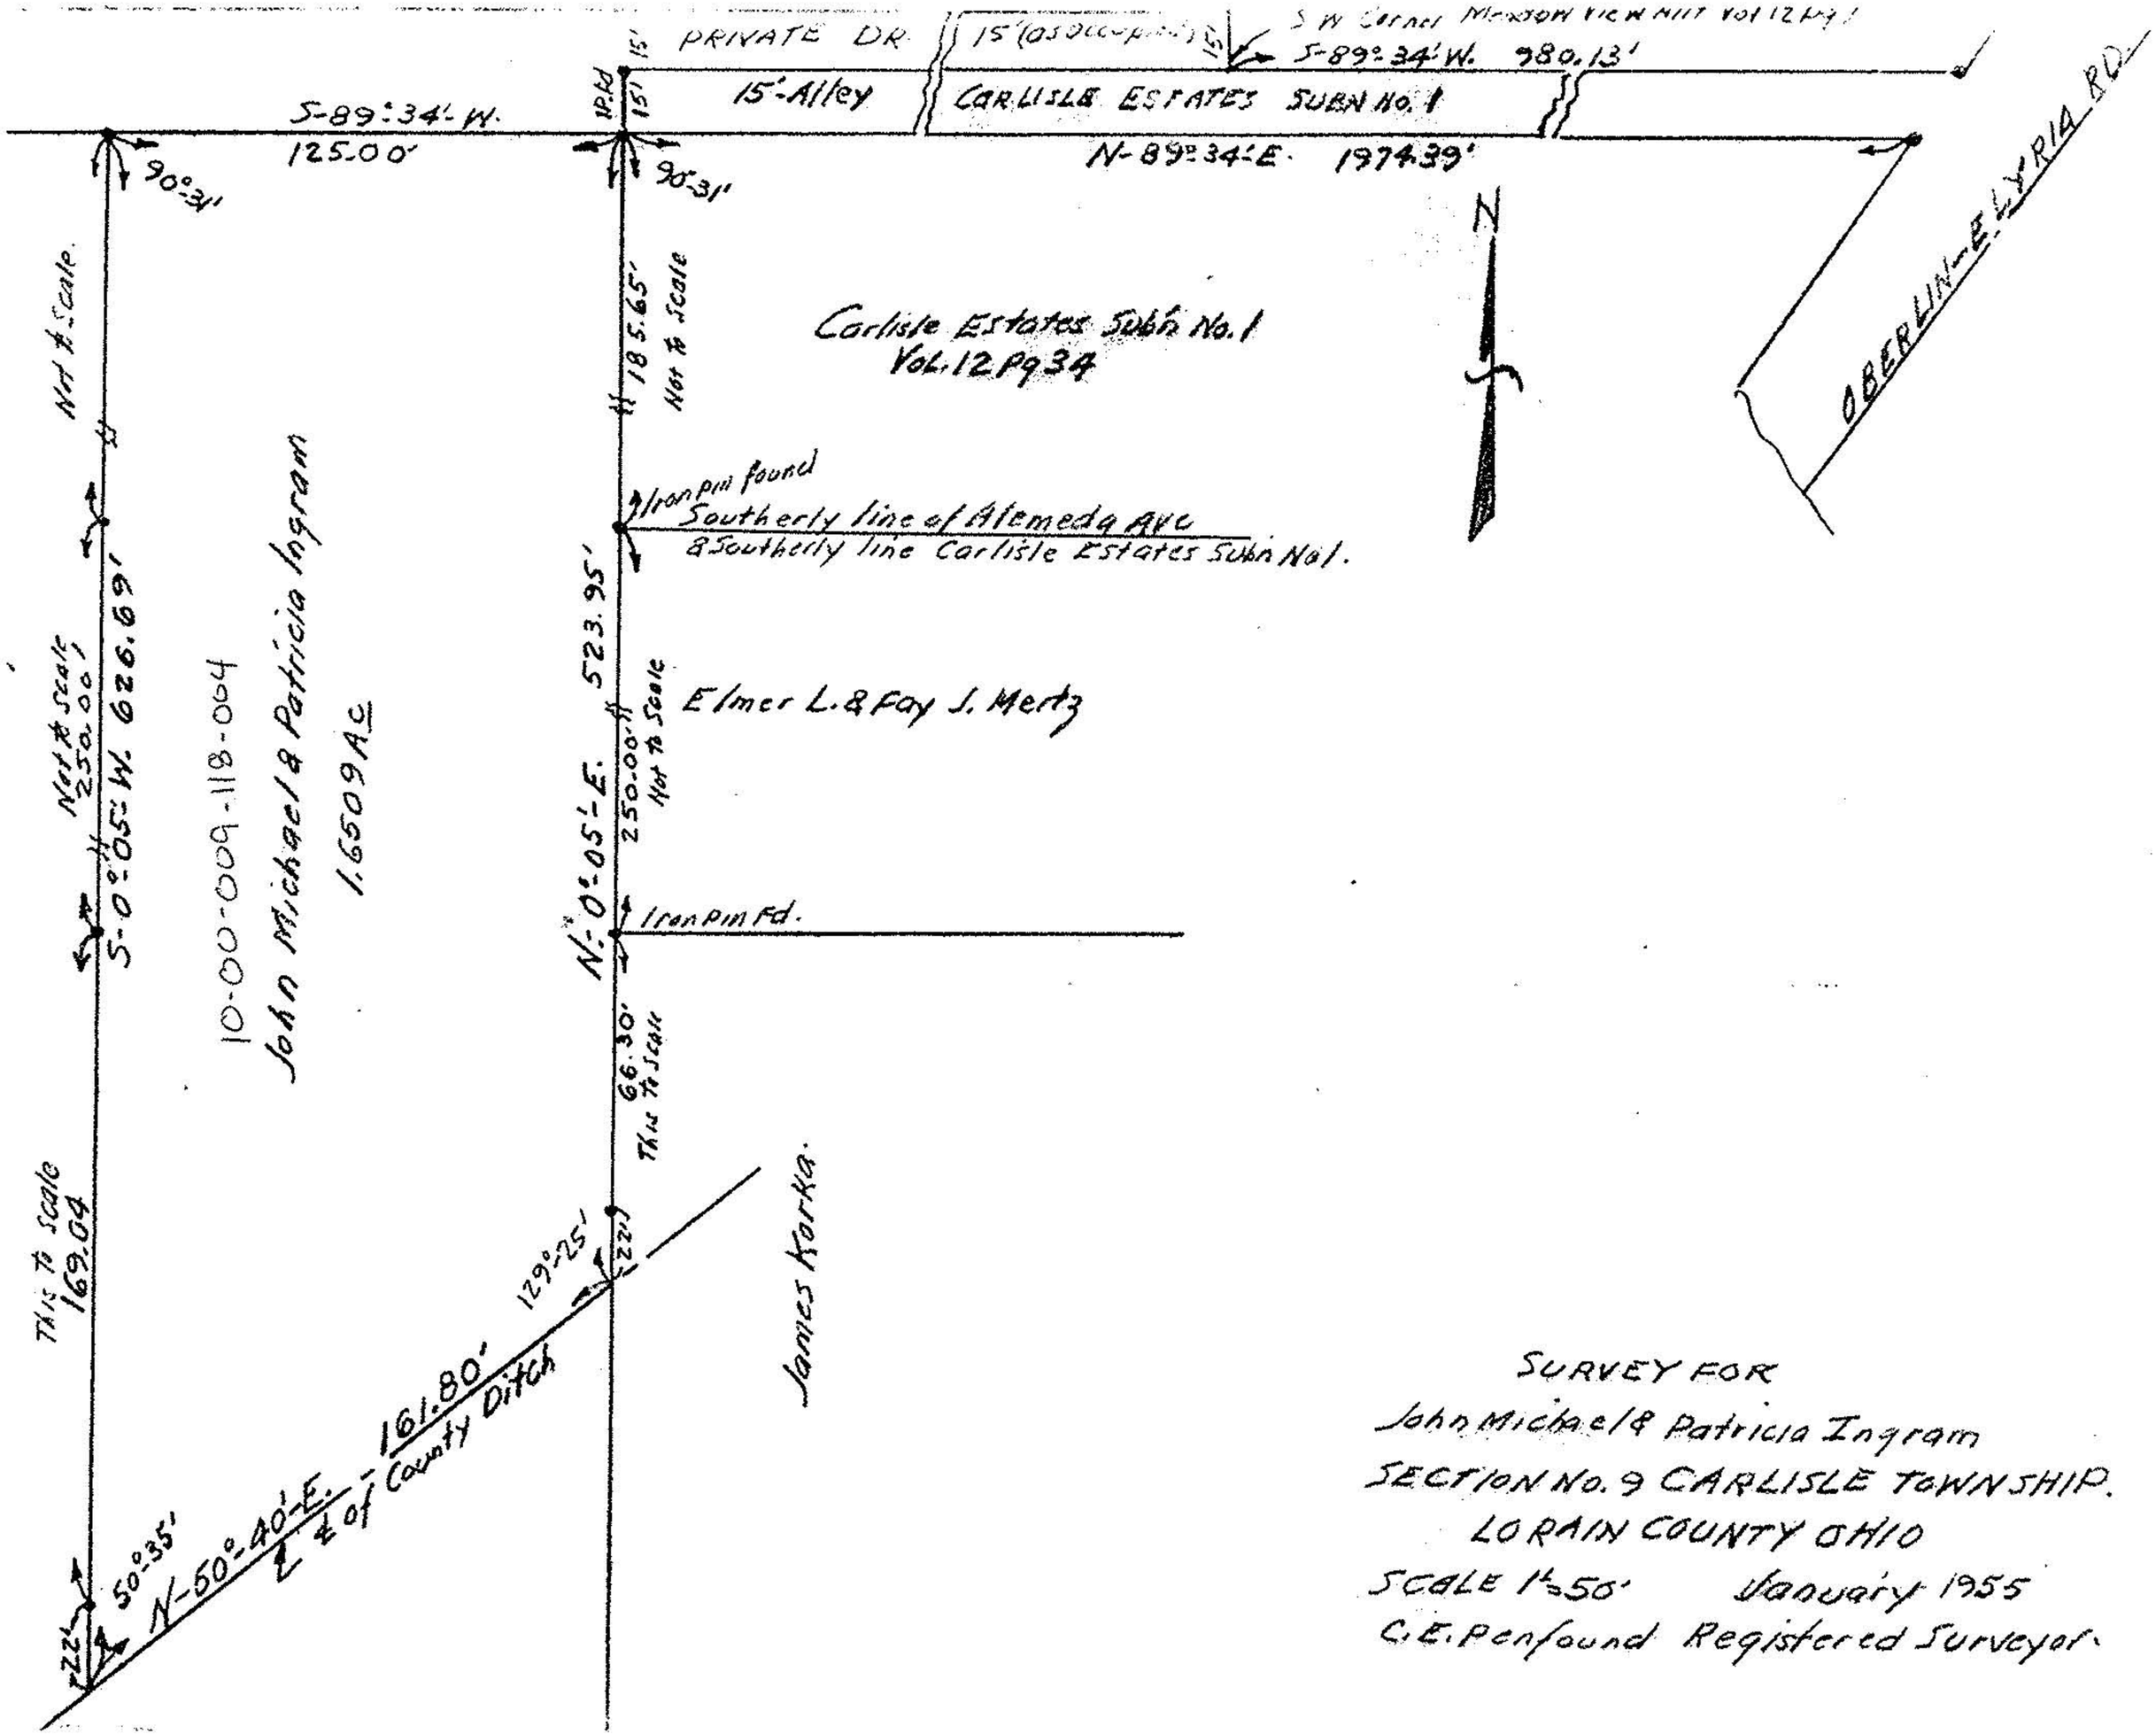


SURVEY FOR
John Michael & Patricia Ingram
SECTION No. 9 CARLISLE TOWNSHIP.
LORAIN COUNTY OHIO
SCALE 1"=50' January 1955
C.E. Penfound Registered Surveyor.