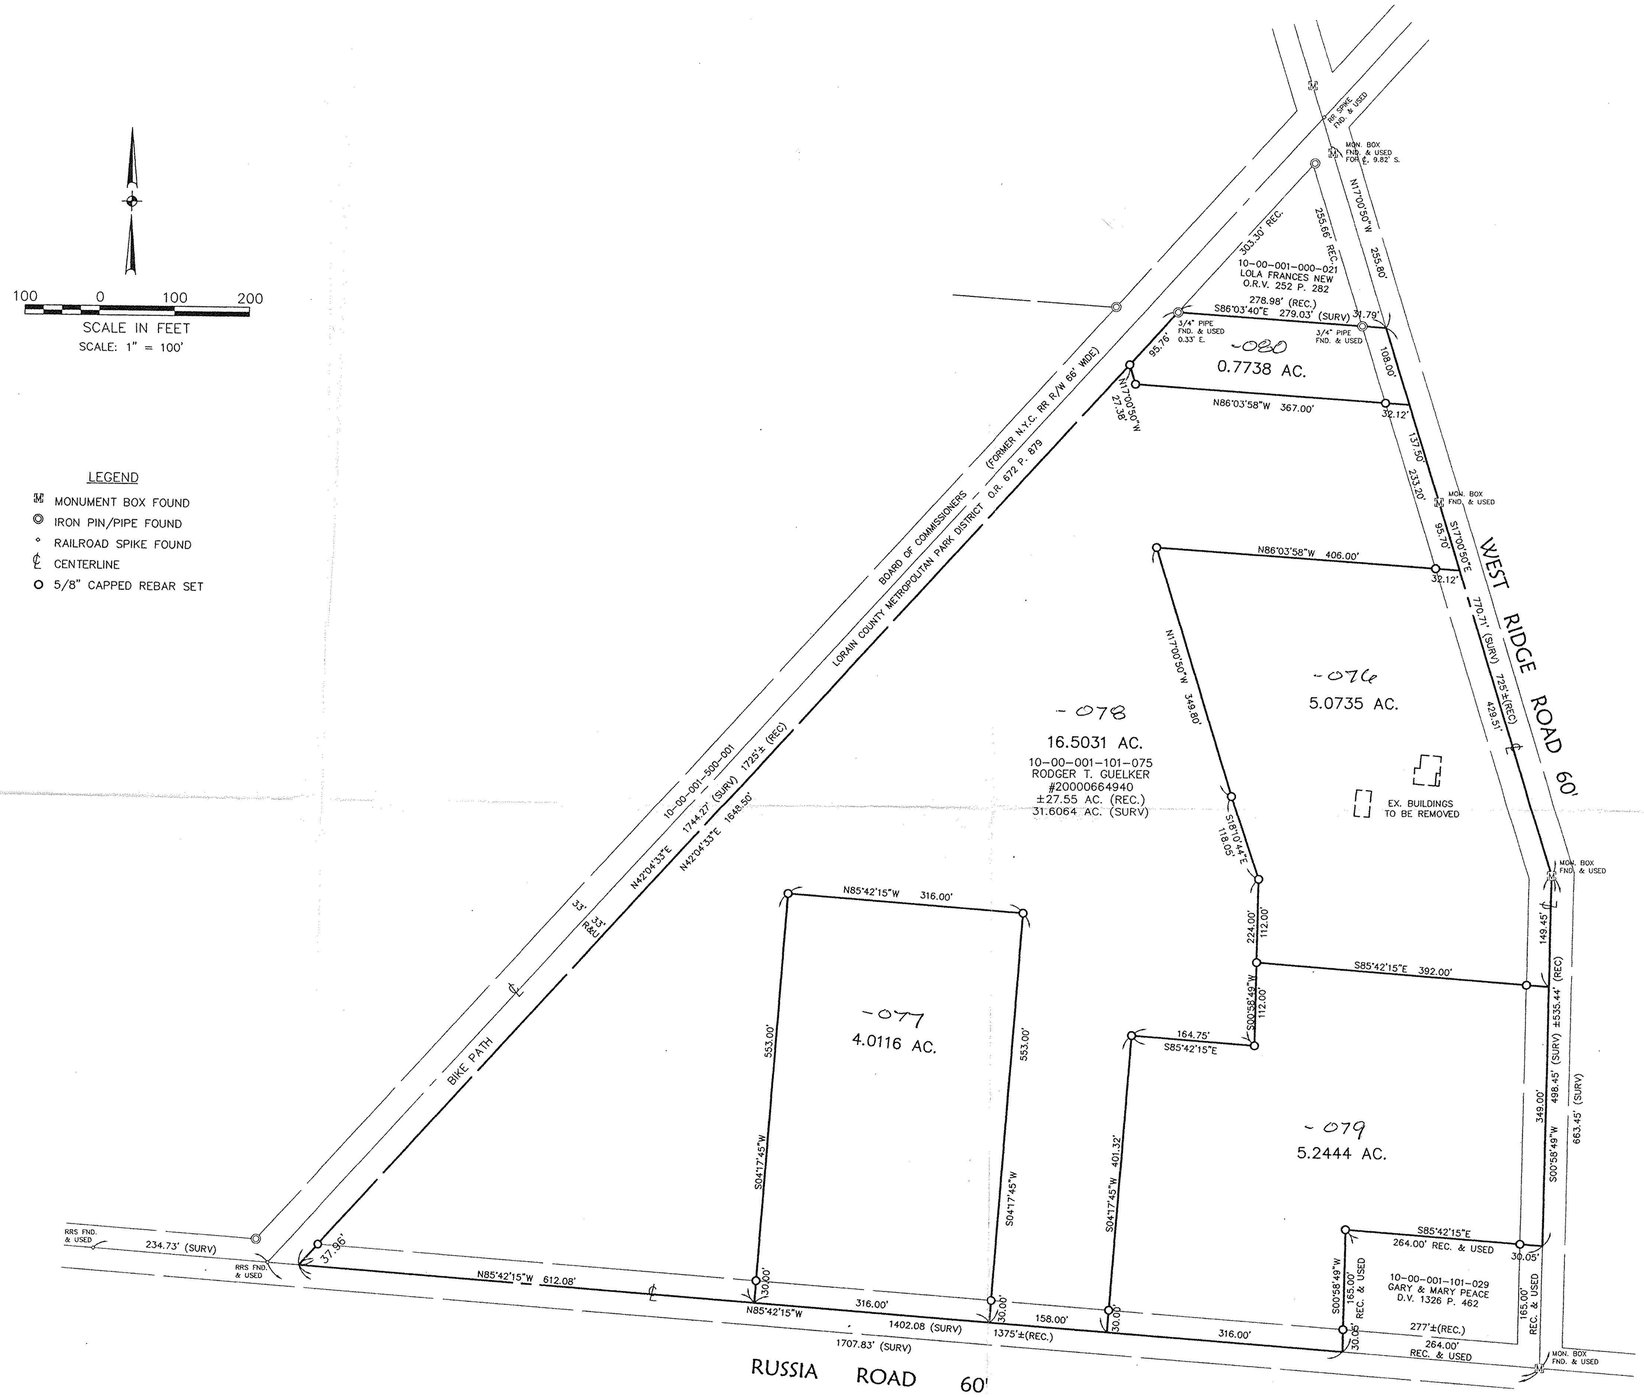

00591
APPROVED
LORAIN CO.
MAP DEPT
DATE 10-30-00
PAGE 10-00-001-G
BY JHatfield
00-00591

STATE OF OHIO
DAVID L. ELWELL
6333
REGISTERED SURVEYOR

David L. Elwell
DAVID L. ELWELL, REG. SURVEYOR NO. 6333

DATE: 8-22-00
DRAWN BY: AMK
CH'D BY:
DWG. NAME: 0-BASE01
PATH: R:\00180\LDDT\
F.B.

REVISIONS	DATE	DESCRIPTION	BY

KS ASSOCIATES
KS ASSOCIATES, INC.
260 Burns Road, Suite 100
P.O. Box 569
Elyria, Ohio 44036
Phone (440) 365-4730
Fax (440) 365-4790
mailroom@ksassoc.com
www.ksassoc.com

SURVEY MAP & LOT SPLIT

OF PART OF ORIGINAL CARLISLE TOWNSHIP SECTION NO. 1
TOWNSHIP OF CARLISLE COUNTY OF LORAIN
STATE OF OHIO

SHEET 1 OF 1

JOB NO. 00180