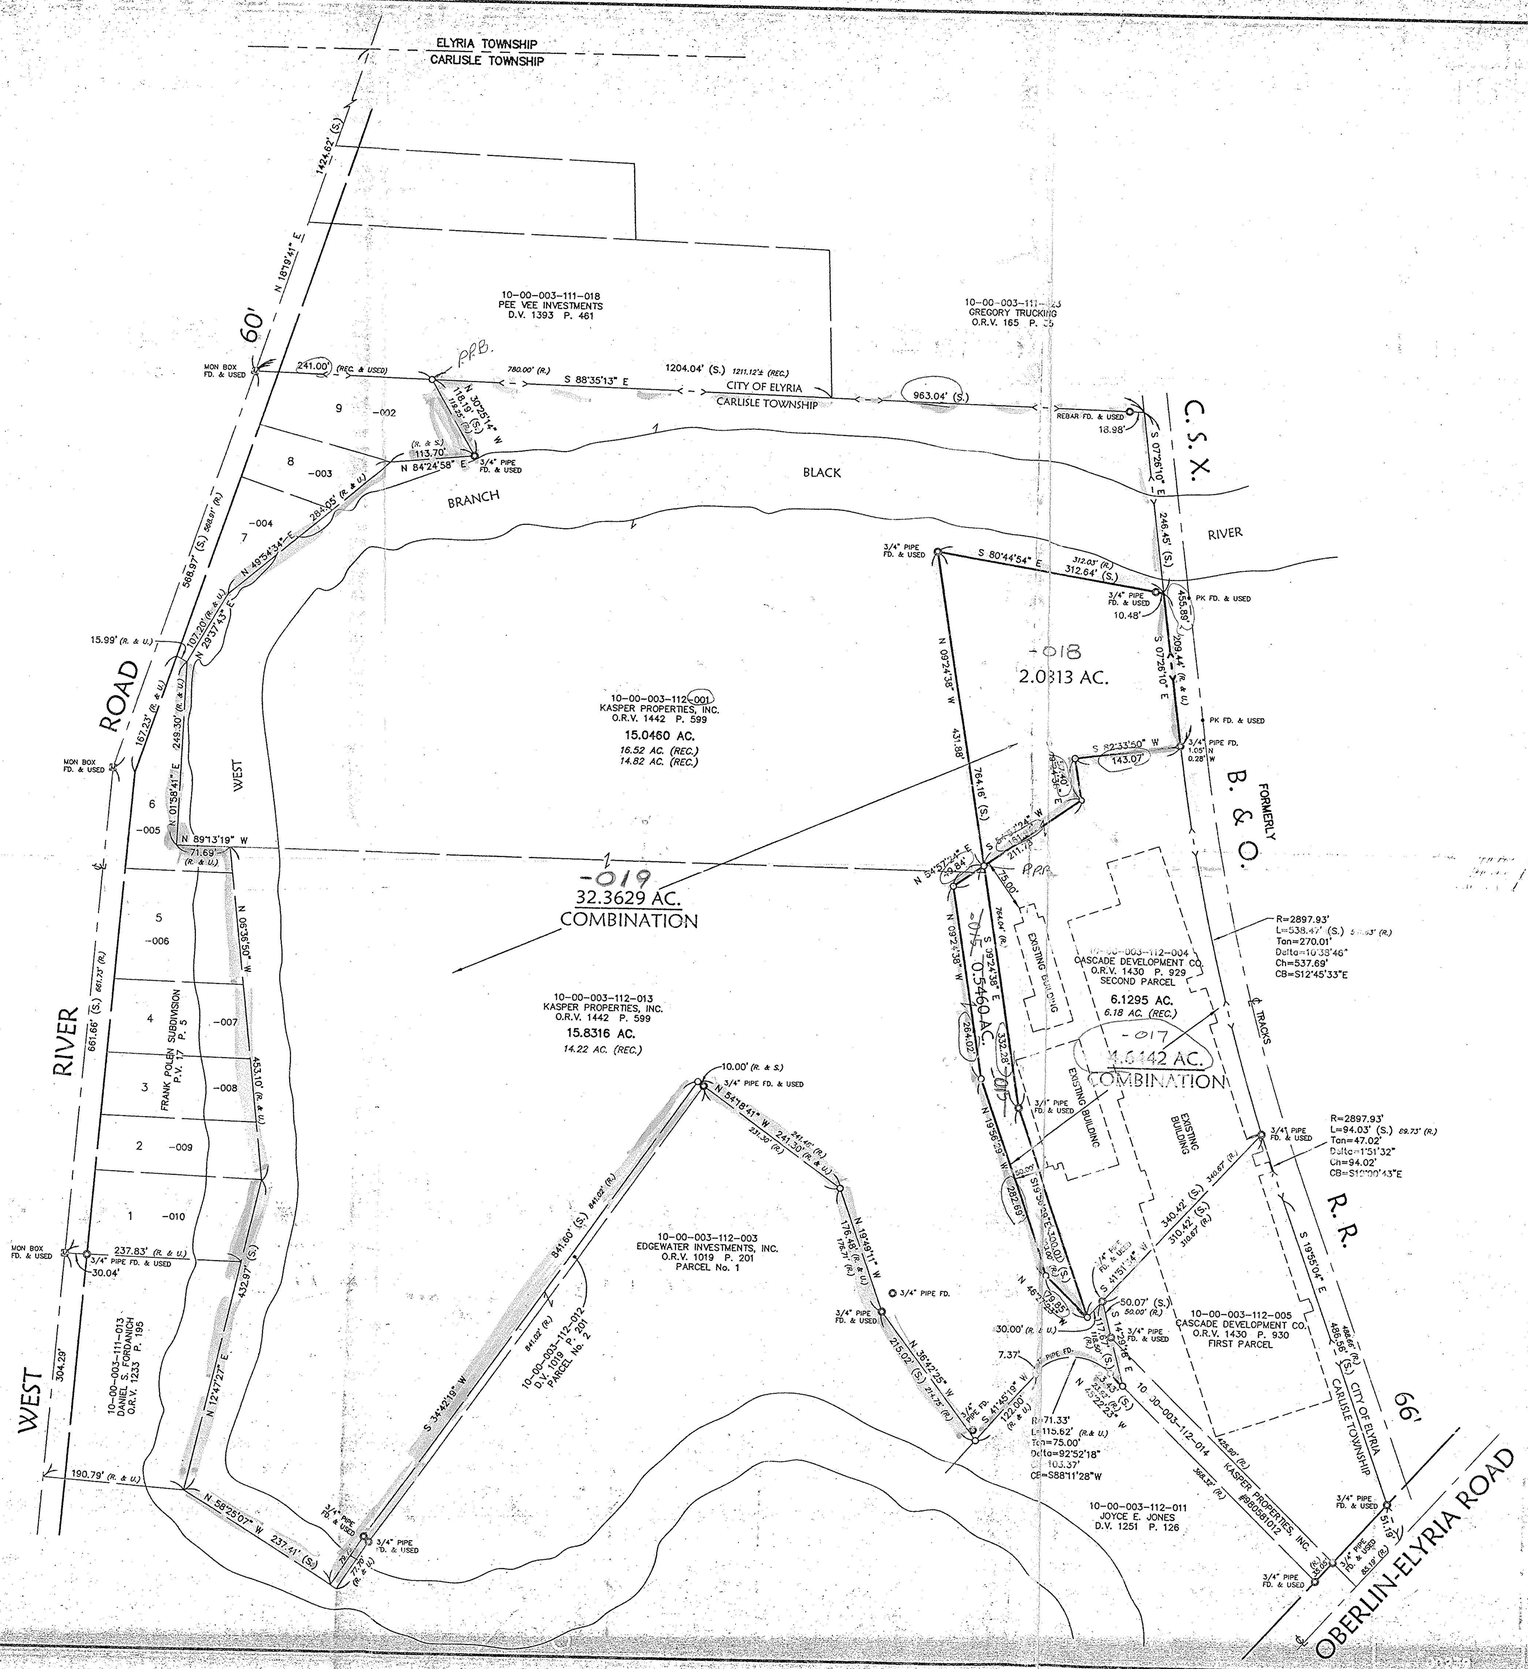

BEARINGS SHOWN HEREON ARE TO AN ASSUMED MERIDIAN AND ARE USED TO DENOTE ANGLES ONLY.

100 0 100 200

SCALE IN FEET
1"=100'

LEGEND

- ⊠ – MONUMENT BOX FOUND
- • – PK NAIL FOUND
- O – IRON PIN/PIPE FOUND
- ○ – 5/8" CAPPED REBAR SET

ABBREVIATIONS

R./REC.	–	RECORD
S.	–	SURVEYED
FD.	–	FOUND
U.	–	USED

00654
APPROVED
LORAIN CO.
MAP DEPT
DATE 1-30-01
PAGE 10-00-003-B
BY JHATFIELD
#01-00654

RECEIVED
JAN 12 2001
CASCADE PATTERN

STATE OF OHIO
MARK ALLEN YEAGER
7289
REGISTERED
PROFESSIONAL SURVEYOR

Mark A. Yeager 01/12/01
MARK A. YEAGER
REGISTERED SURVEYOR No. 7289

REVISIONS			
DATE	DESCRIPTION	BY:	
1-11-01	REVISED WEST BOUNDARY OF 0.5460 AC SPLIT PARCEL & SOUTHERN BOUNDARY OF 2.0313 AC PARCEL	RGR	
1-3-01	REVISED WEST BOUNDARY OF 0.7705 AC SPLIT PARCEL	RGR	

DATE: 11-02-00
DRAWN BY: ABR
CKD BY:
DWG. NAME: 0-SURVO1
PATH: 00239
F.B.

KS ASSOCIATES
KS ASSOCIATES, INC.
260 Burns Road, Suite 100
P.O. Box 569
Elyria, Ohio 44036
(440) 324-5477
Fax (440) 324-5730
mallison@ksassoc.com
www.ksassoc.com

SURVEY MAP

OF PART OF
ORIGINAL CARLISLE TOWNSHIP SECTION No. 3
TOWNSHIP OF CARLISLE COUNTY OF LORAIN STATE OF OHIO

SHEET 1 OF 1

JOB NO. 00239