SURVEY & LOT SPLIT
FOR

GWEN & LORNE ELBERT III

CITY OF ELYRIA
ORIGINAL SECTION 8 CARLISLE TWP.
COUNTY OF LORAIN STATE OF OHIO

LAUNDON · SIMON · CAHL & ASSOCIATES
ENGINEERS SURVEYORS

MAY 1994
SCALE: 1" = 50'

0 25 50 100 150 200

JOB NO. 94-2561
FB. 232 P. 73 & 74

STATE OF OHIO
RODGER G. SIMON
5101
REGISTERED SURVEYOR

REVISED 9/28/95 Combine Pcls. 2, 3, +4 into 1 parcel
Refered to as Pcl. 2 8.1521 Ac.

21539
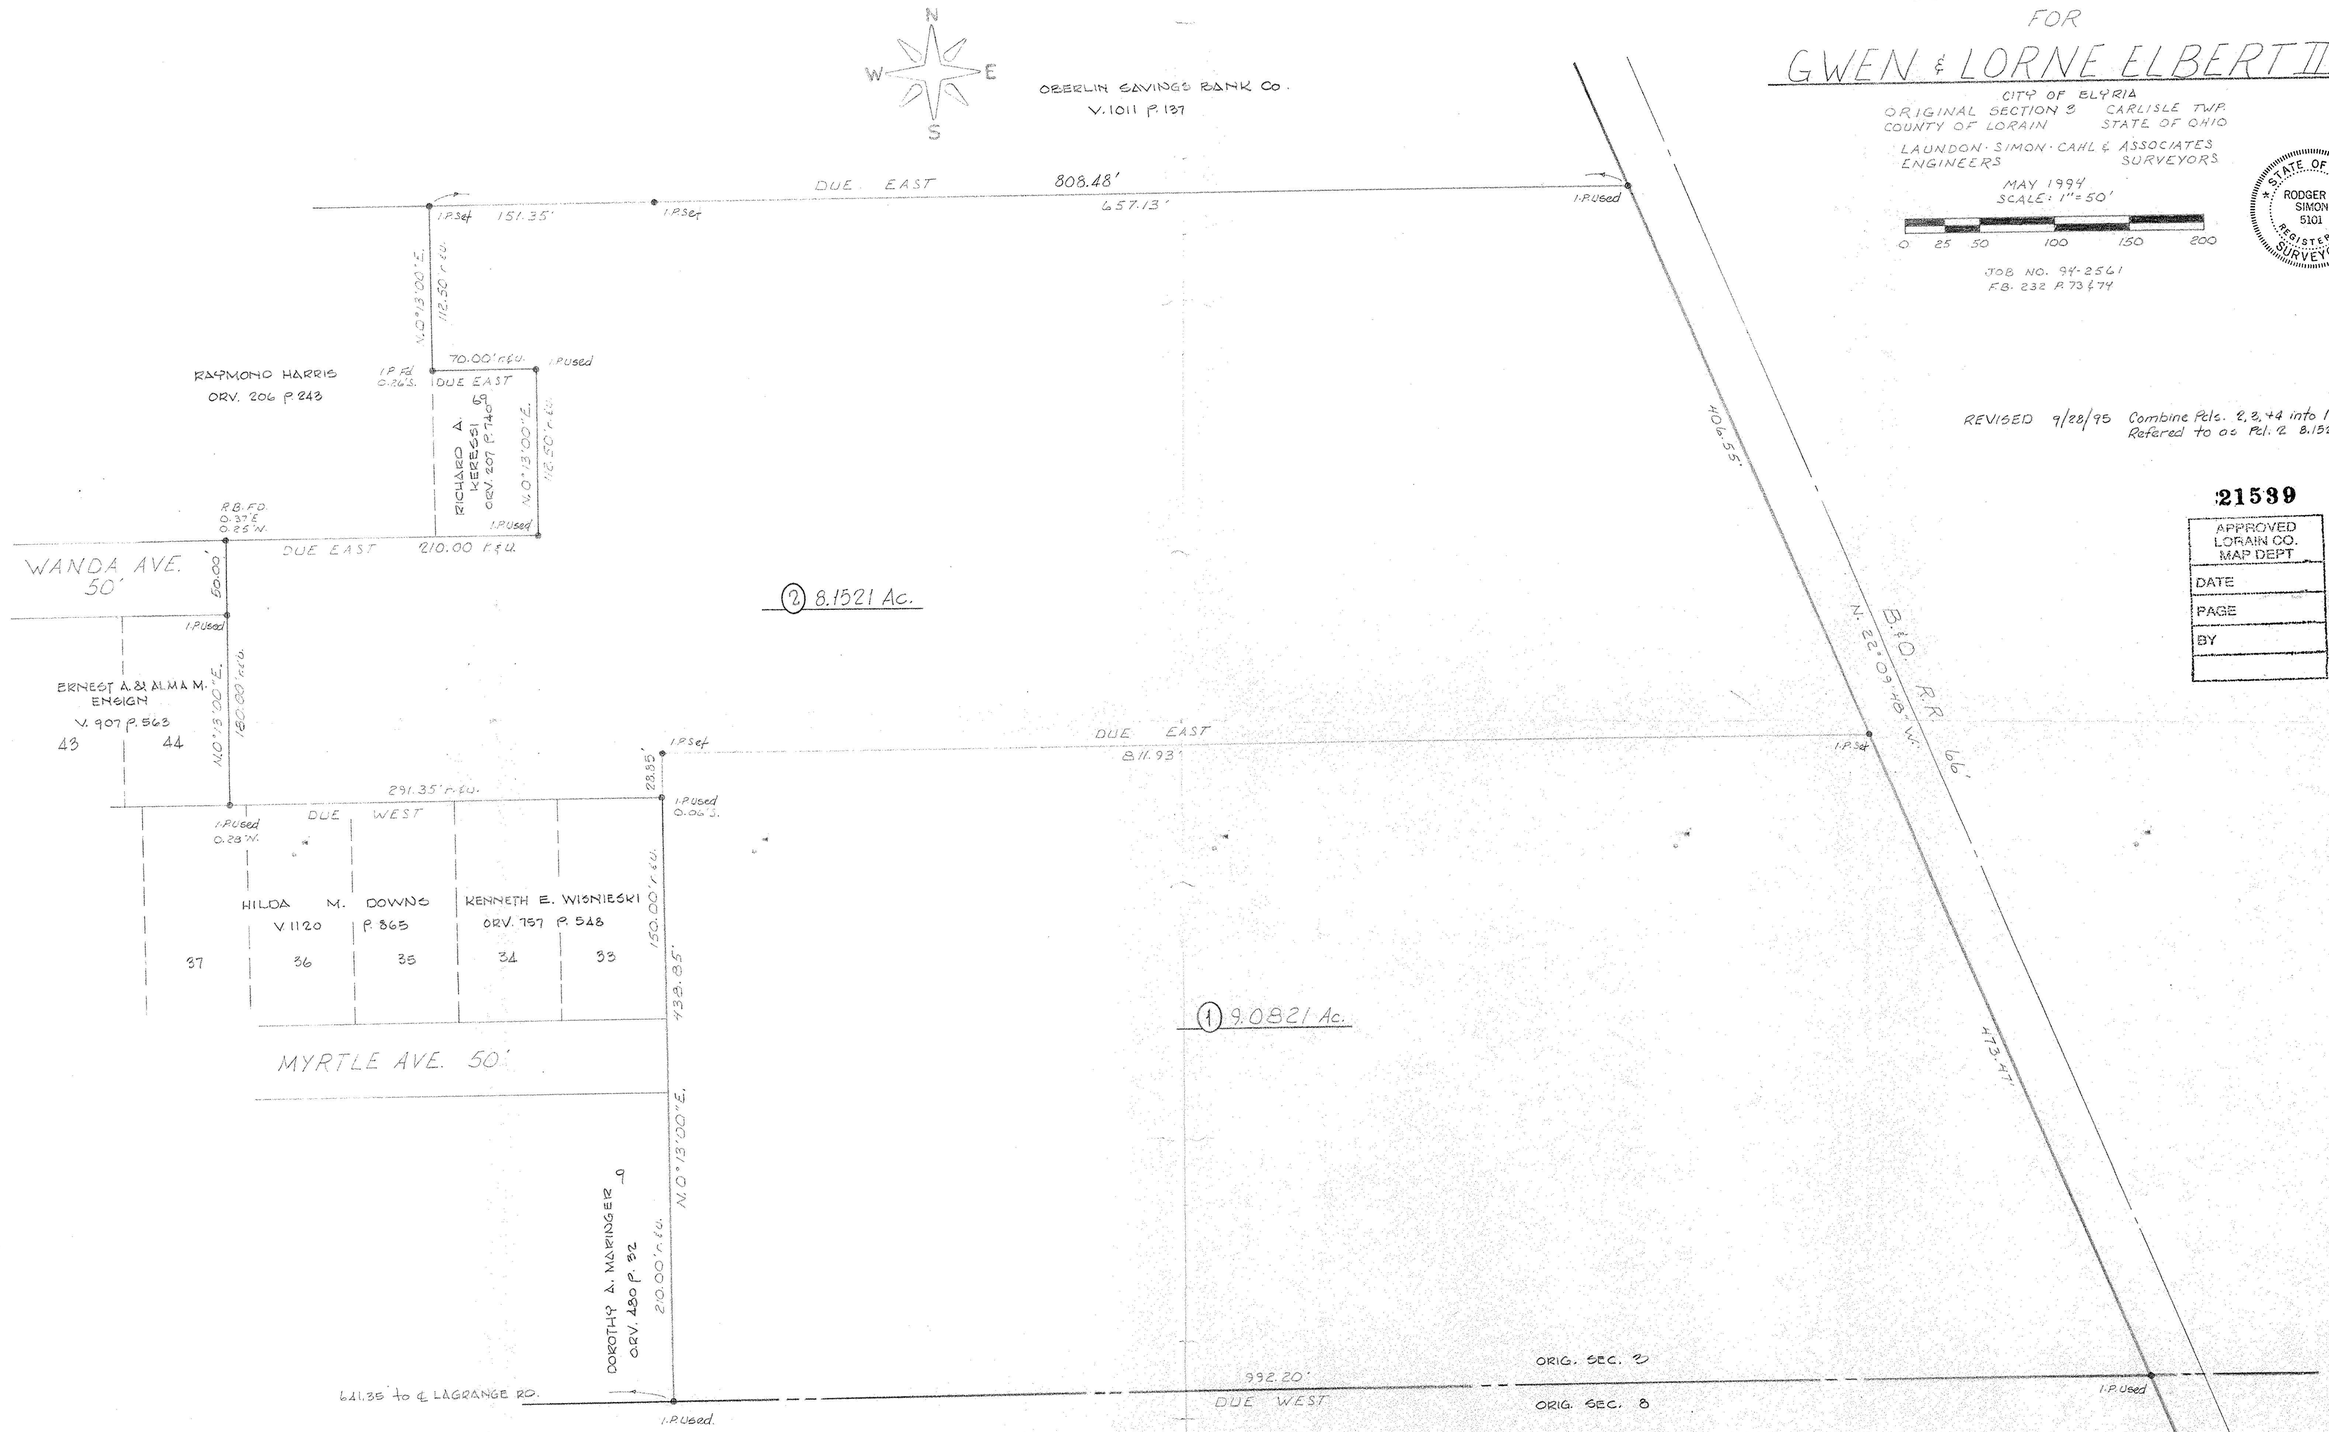
APPROVED LORAIN CO. MAP DEPT.
DATE
PAGE
BY