KLEINOEDER · SCHMIDT and ASSOCIATES

ENGINEERS — SURVEYORS — CONSULTANTS in LAND PLANNING

ELYRIA · NORWALK · MEDINA OHIO

SURVEY

Sublot(s) _____

Subd'n _____

Township CARLISLE Tract _____

Orig. Lot(s) _____ Sec. 3

County of LORAIN State of Ohio

Corporation CITY OF ELYRIA

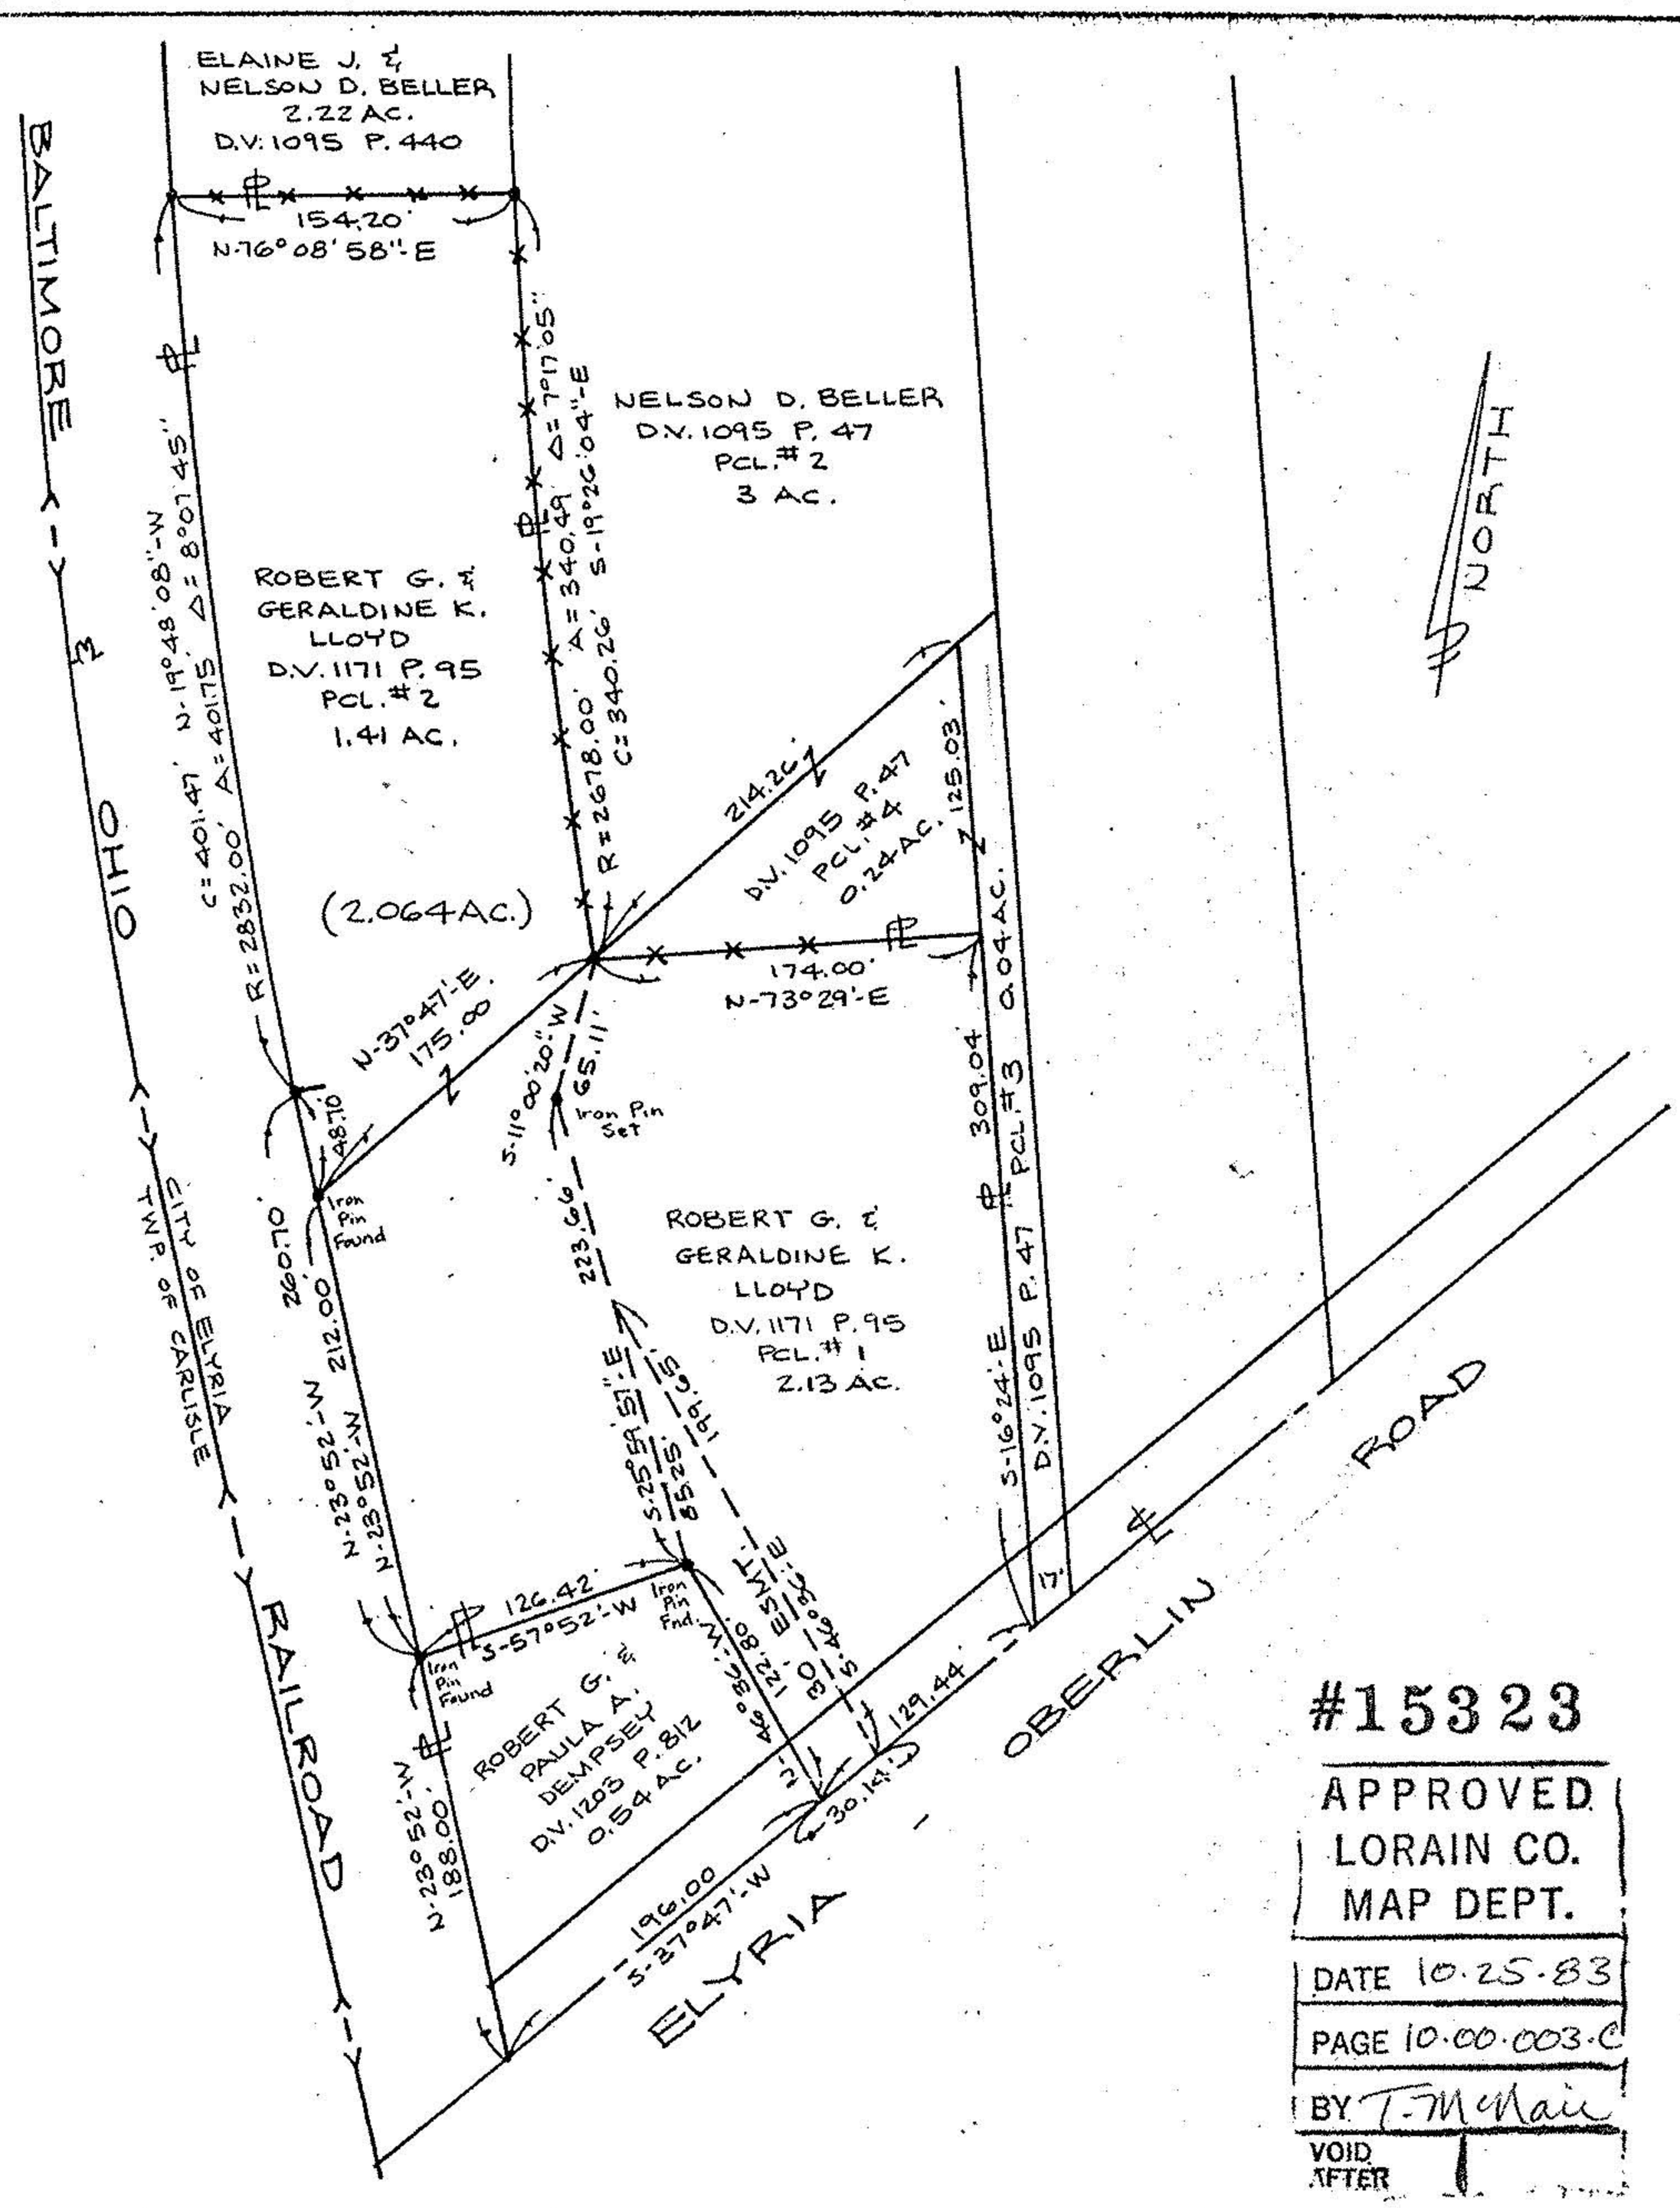

#15323

APPROVED
LORAIN CO.
MAP DEPT.

DATE 10-25-83

PAGE 10-00-003-C

BY T. McNair

VOID AFTER

Prepared for: ROBERT G. LLOYD

Scale: 1"=100'	Date: JULY 8, 1983	Dr. by: DZ	Job № 83-82

10-00-003-C #15323 -115-