


#17644

APPROVED  
LORAIN CO  
MAP DEPT.  
DATE 9.4.87  
PAGE 10-00-005.B  
BY T. McMan  
VOID  
AFTER

10-00-005-13


#17644

10-00-005-11

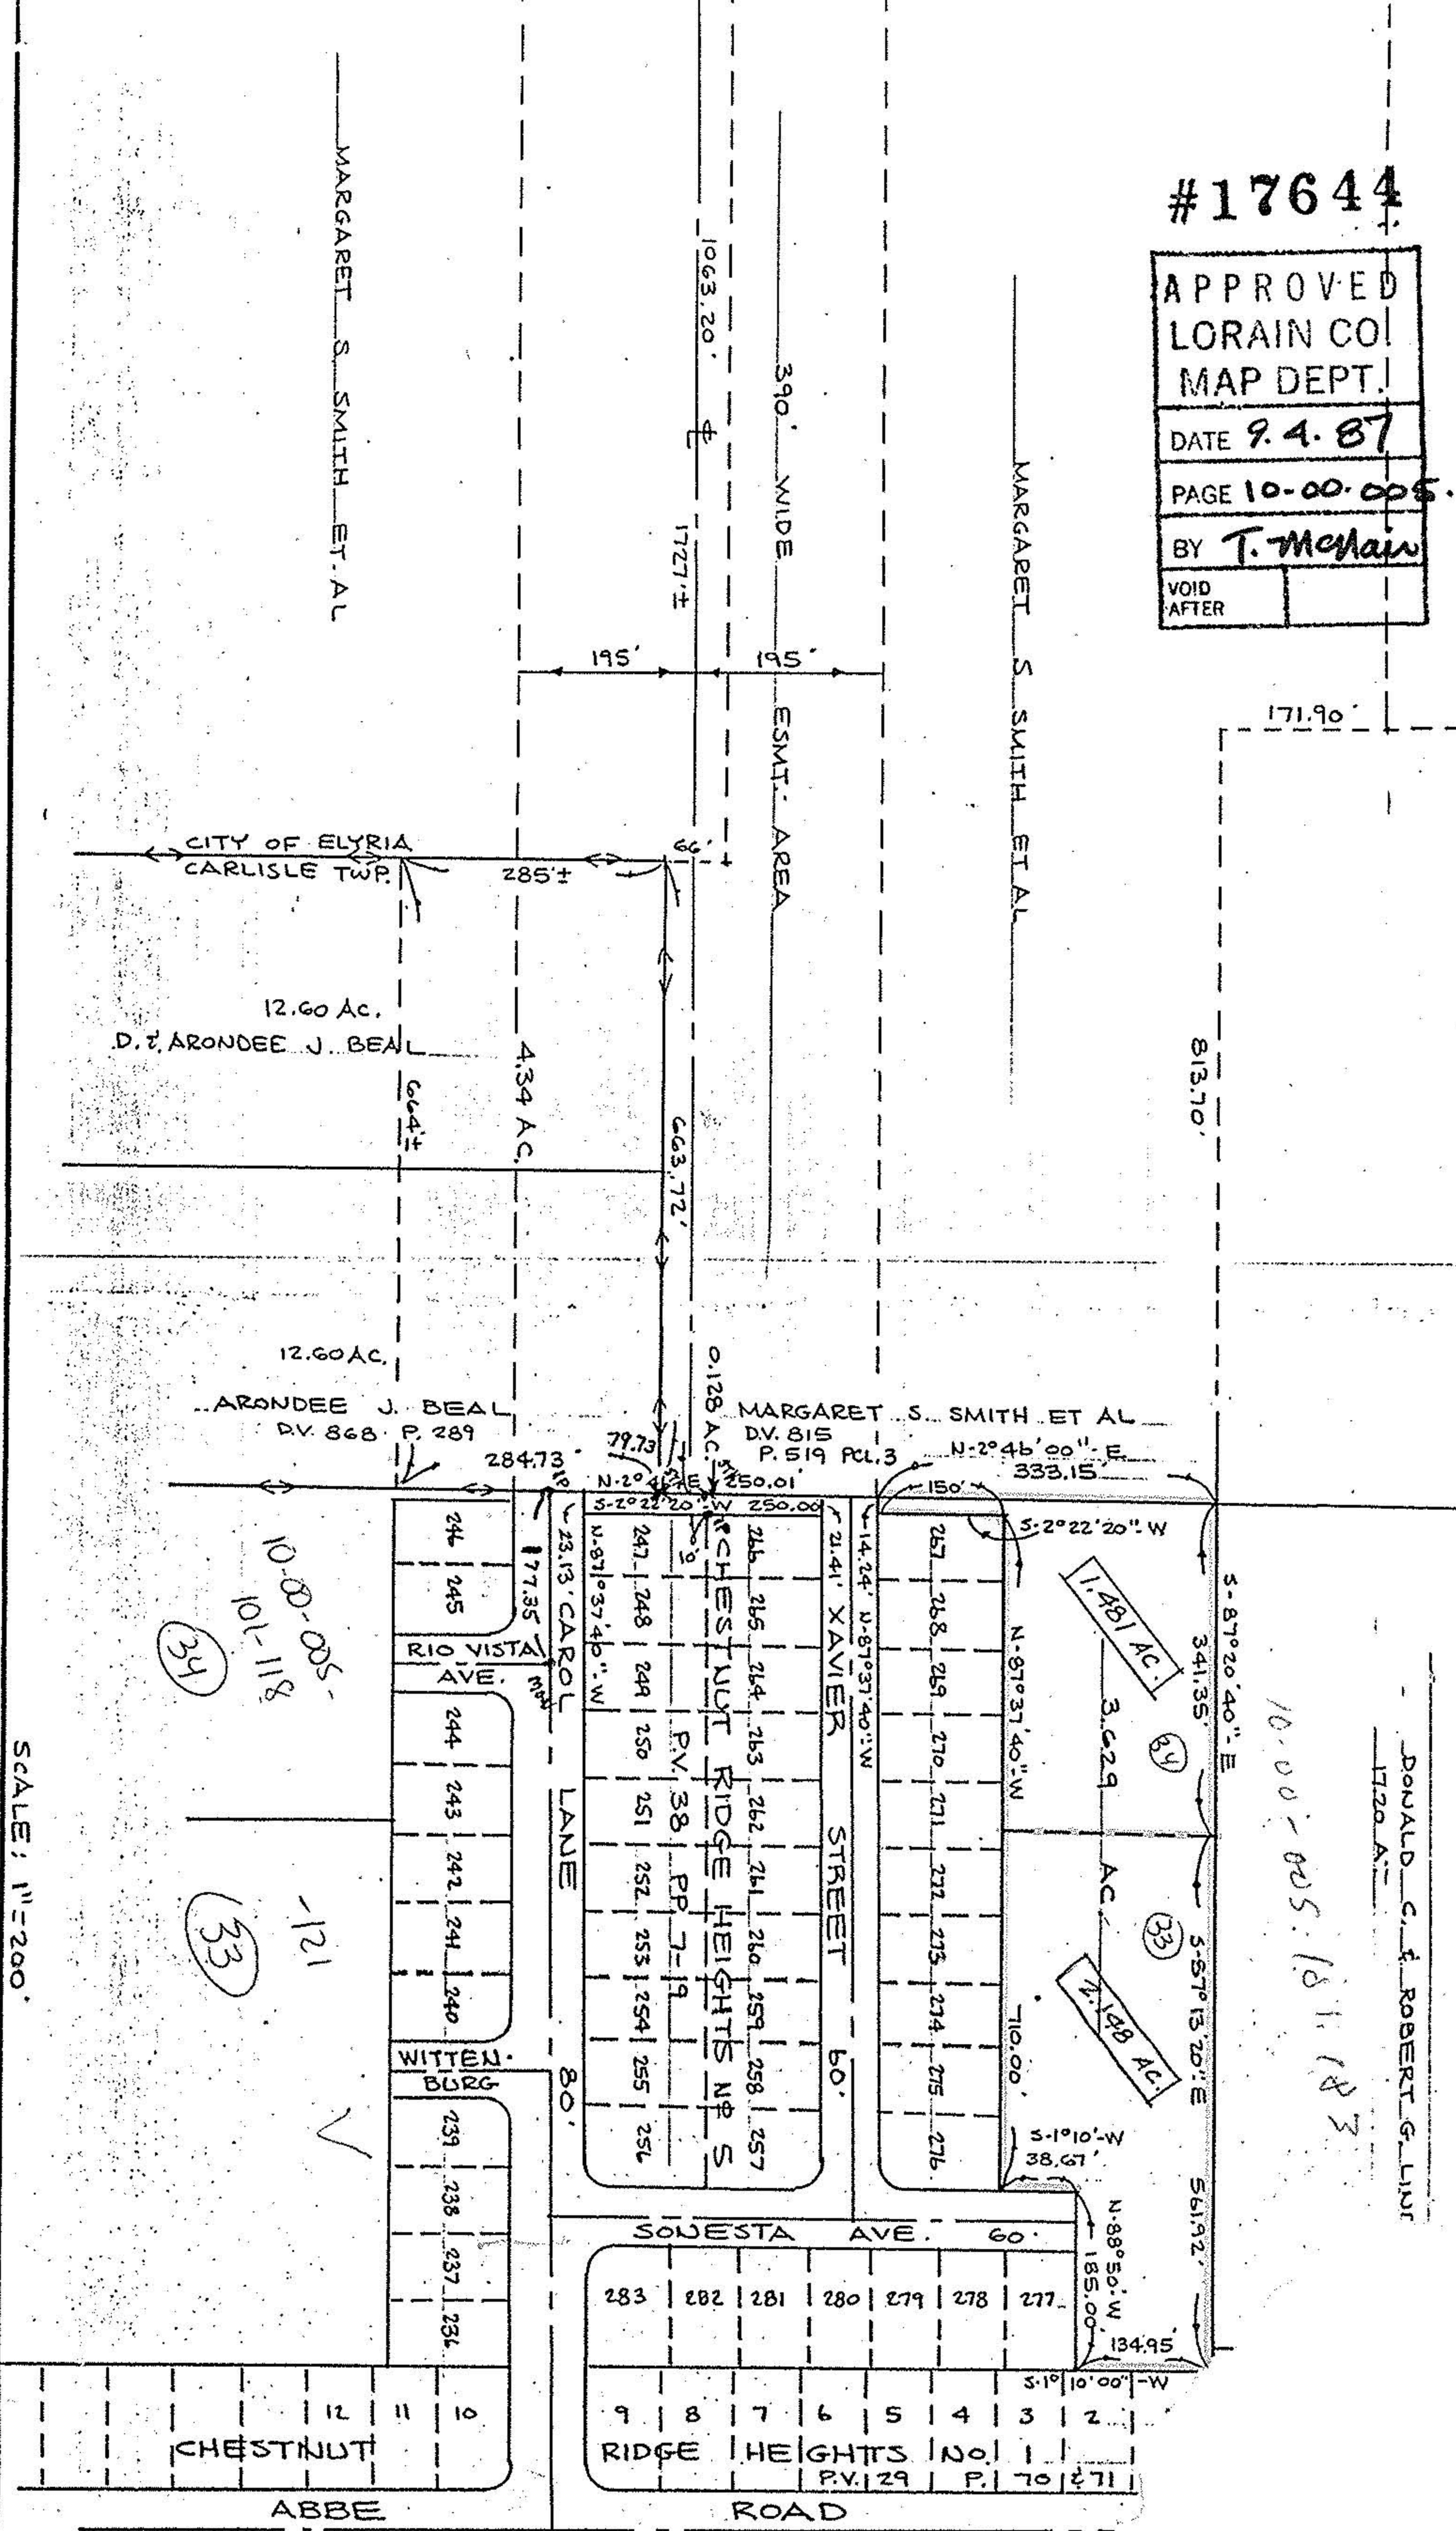

SCALE: 1"=200'

MARGARET S. SMITH ET AL

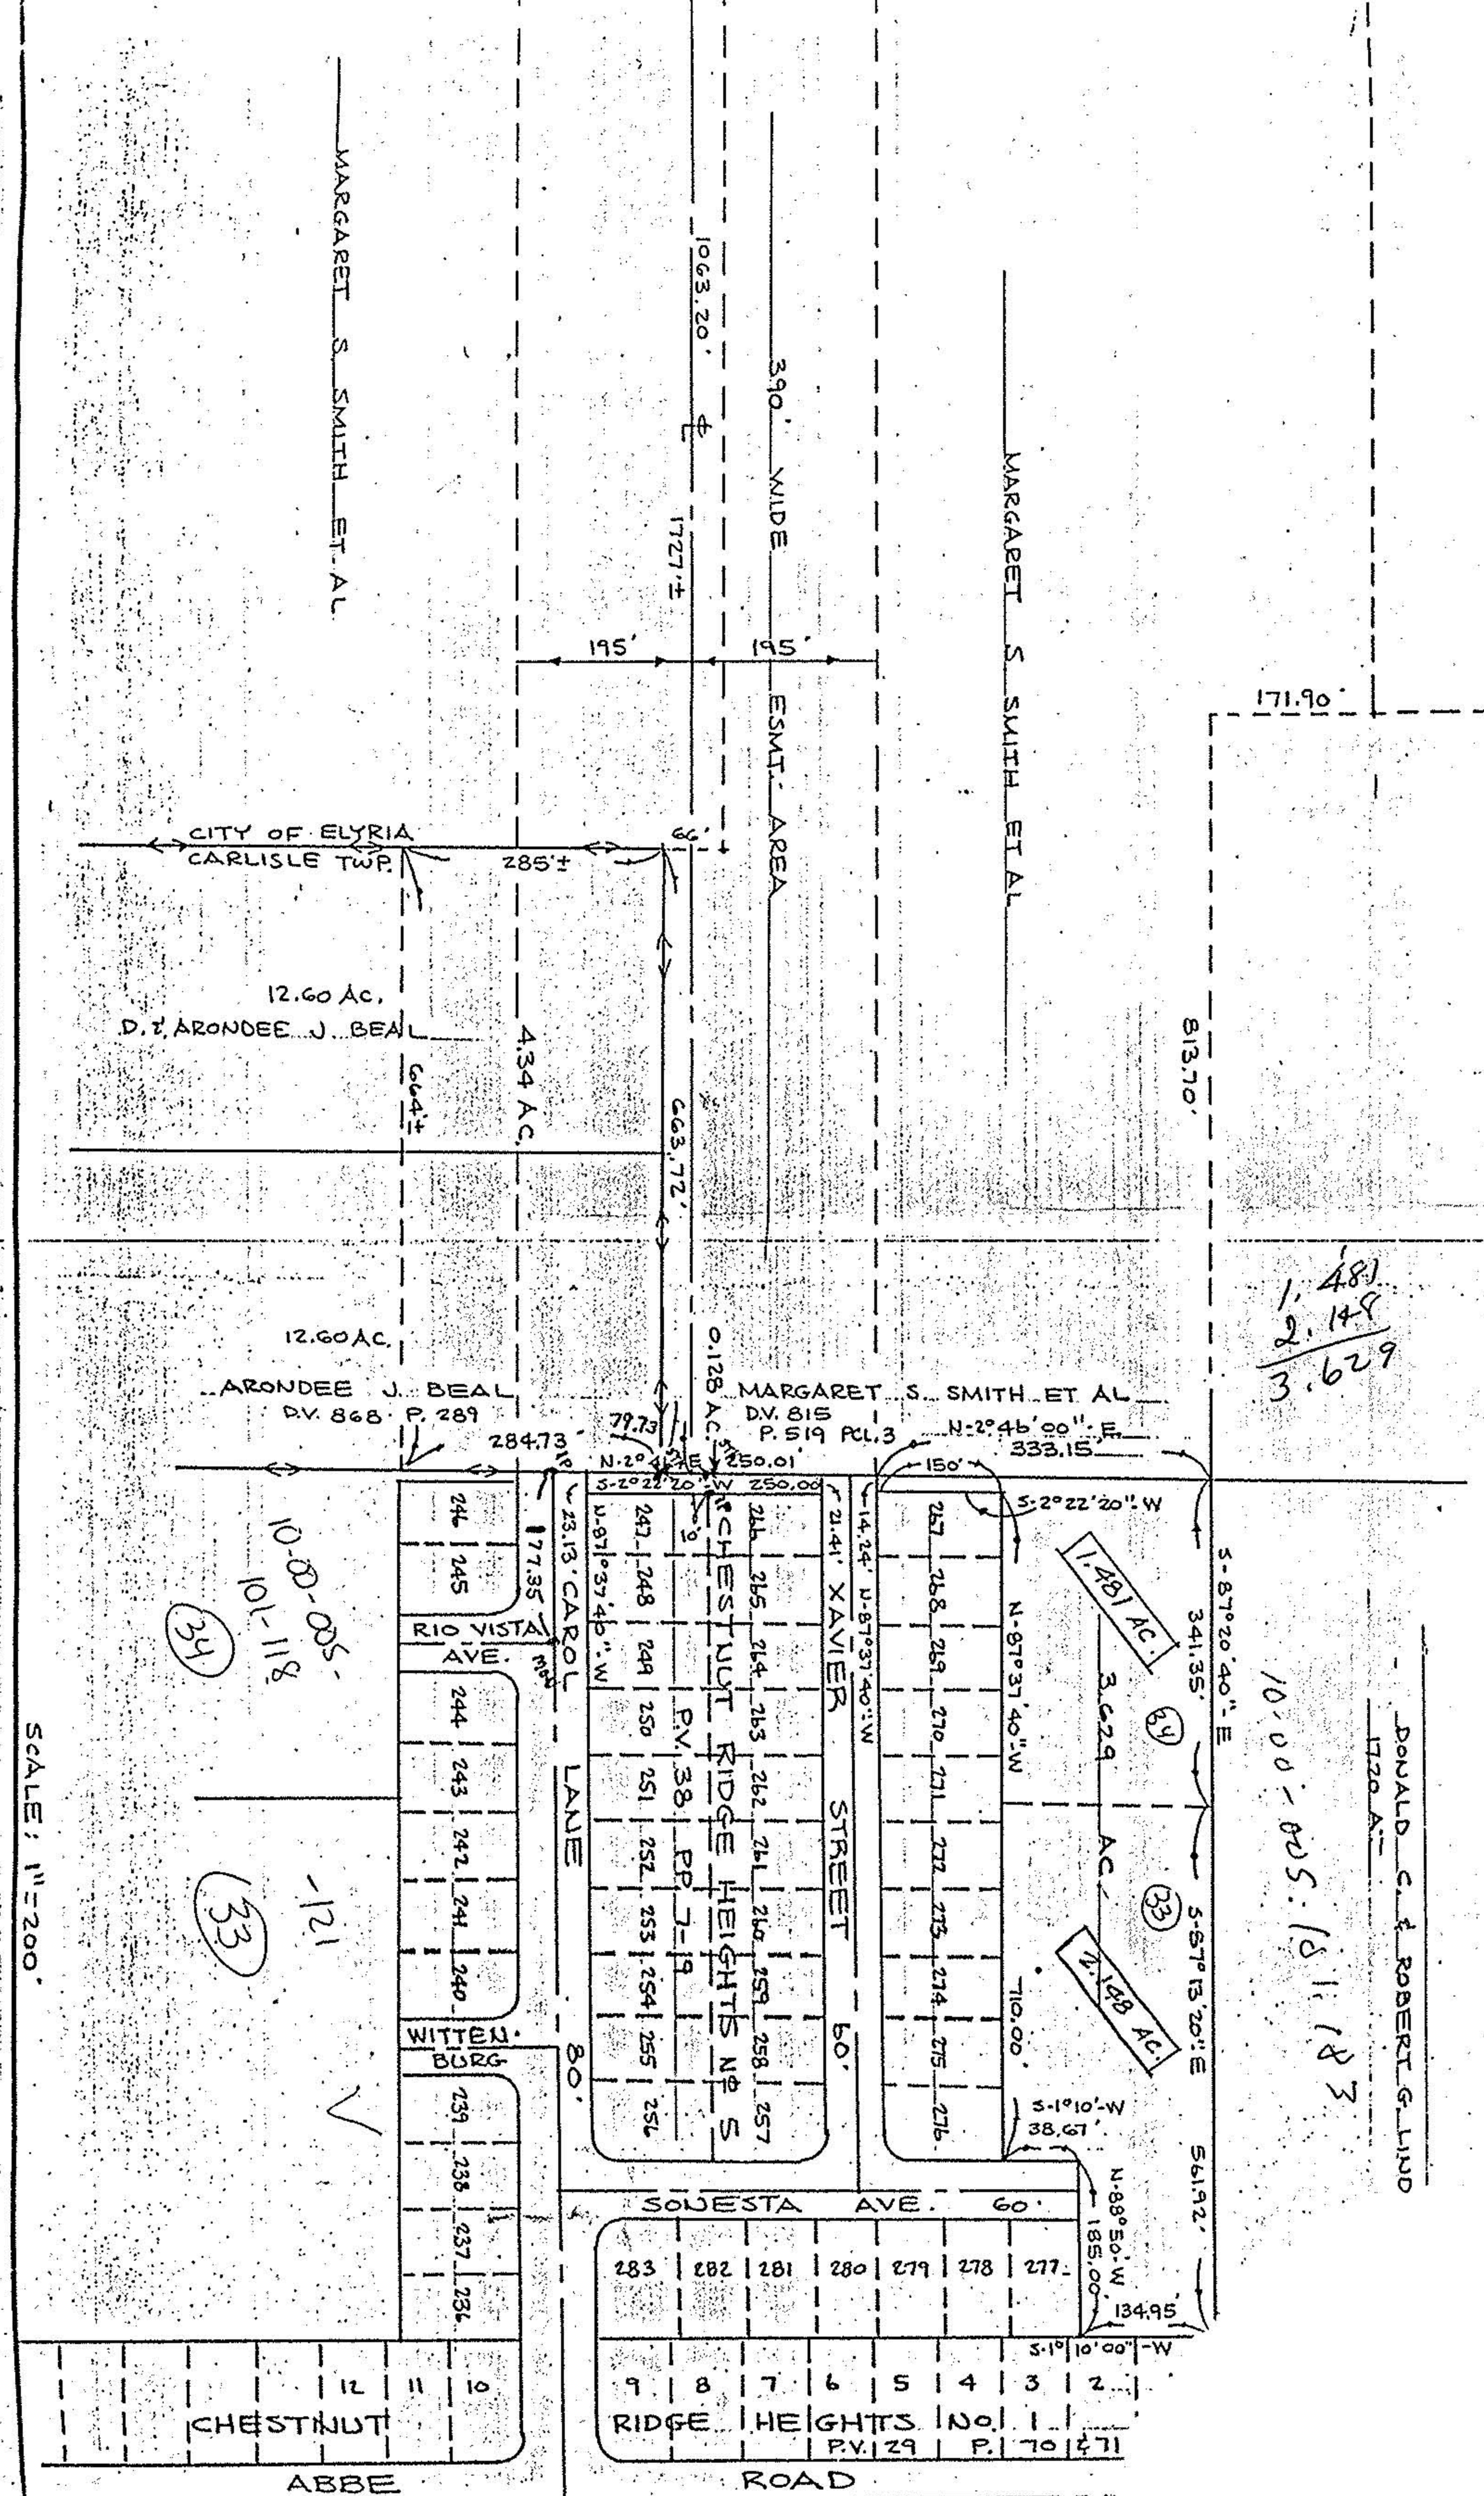

SCALE: 1"=200'

DONALD C. & ROBERT G. LIND