


#18489

10-00-005-B

10-00-005-10

HAMPTON DRIVE 80'
S-89°18'00"-E 328.33'
S-89°18'00"-E 368.12'

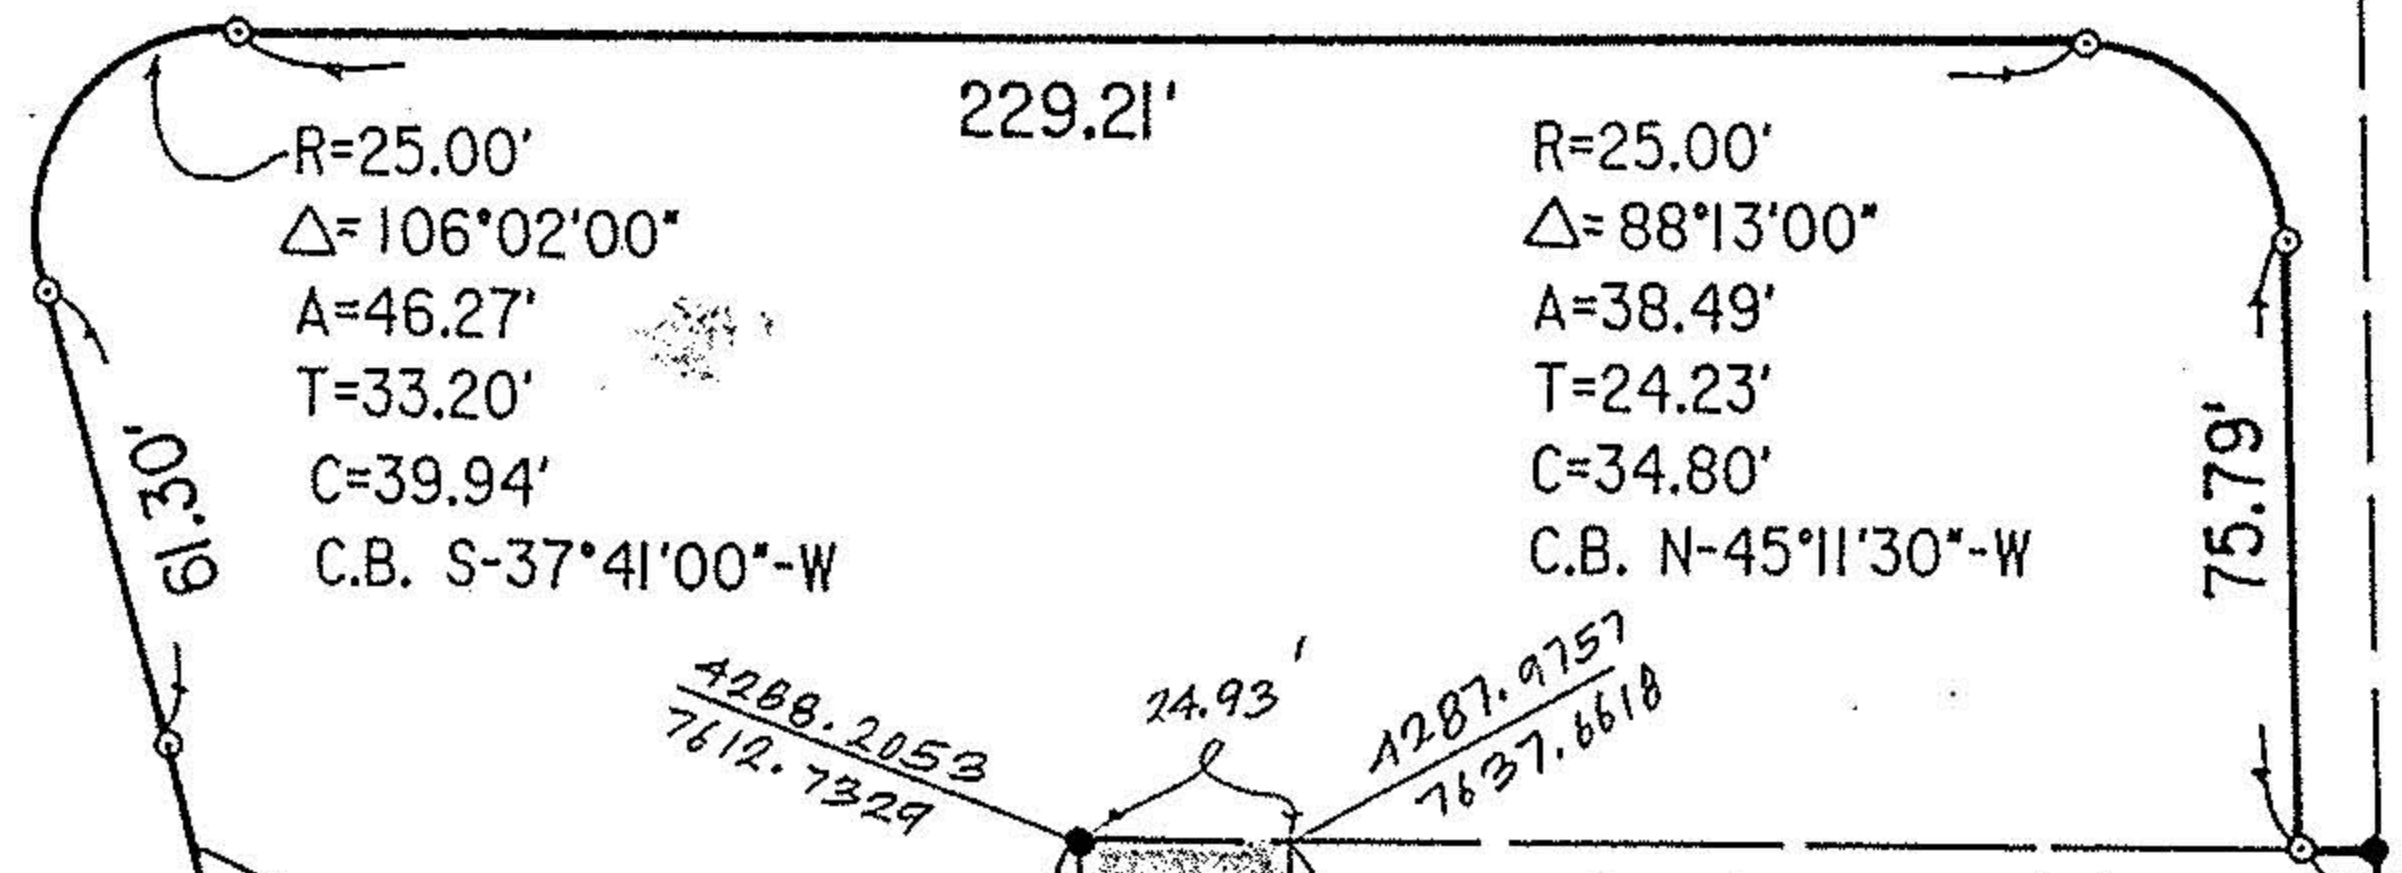



R=25.00'
 $\Delta=106^{\circ}02'00''$
 A=46.27'
 T=33.20'
 C=39.94'
 C.B. S-37°41'00"-W

R=25.00'
 $\Delta=88^{\circ}13'00''$
 A=38.49'
 T=24.23'
 C=34.80'
 C.B. N-45°11'30"-W

R=430.00'
 $\Delta=14^{\circ}15'00''$
 A=106.95'
 T=53.75'
 C=106.67'
 C.B. S-8°12'30"-E


ROBERT C. & ERSIE B. MILNER

D.V. 1369 P. 63
 SURVEYOR ?
 NAME -

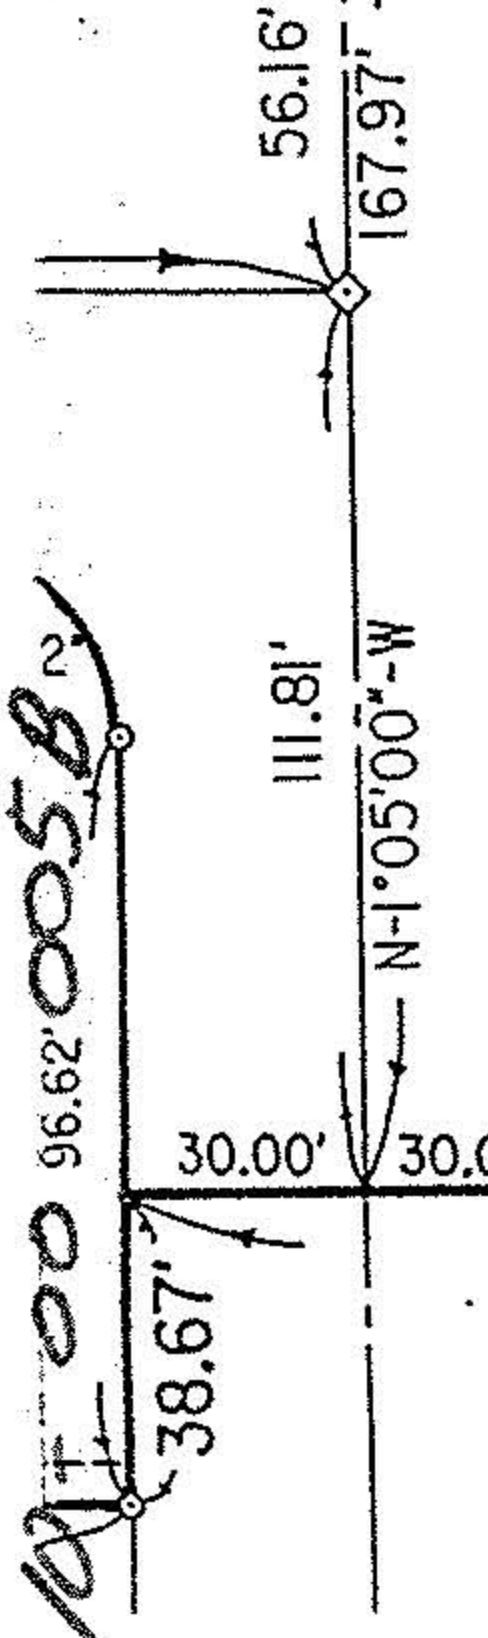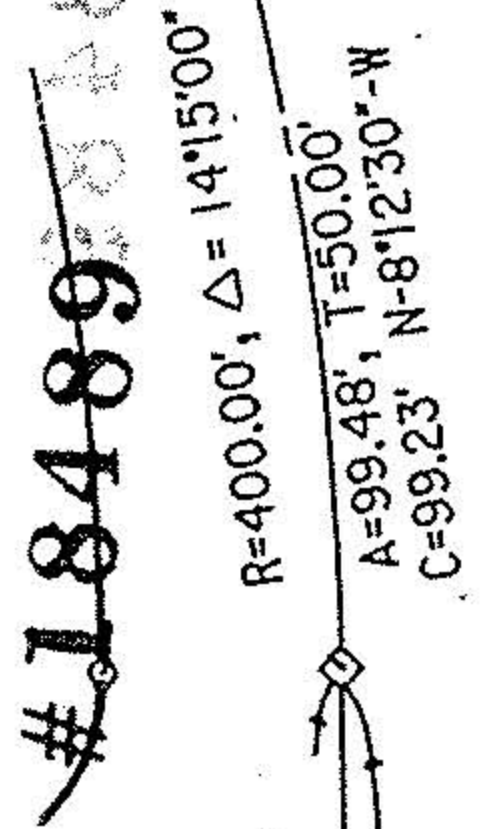

N-88°55'00"-E
 100.08'

S-89°28'20"-E
 24.93'

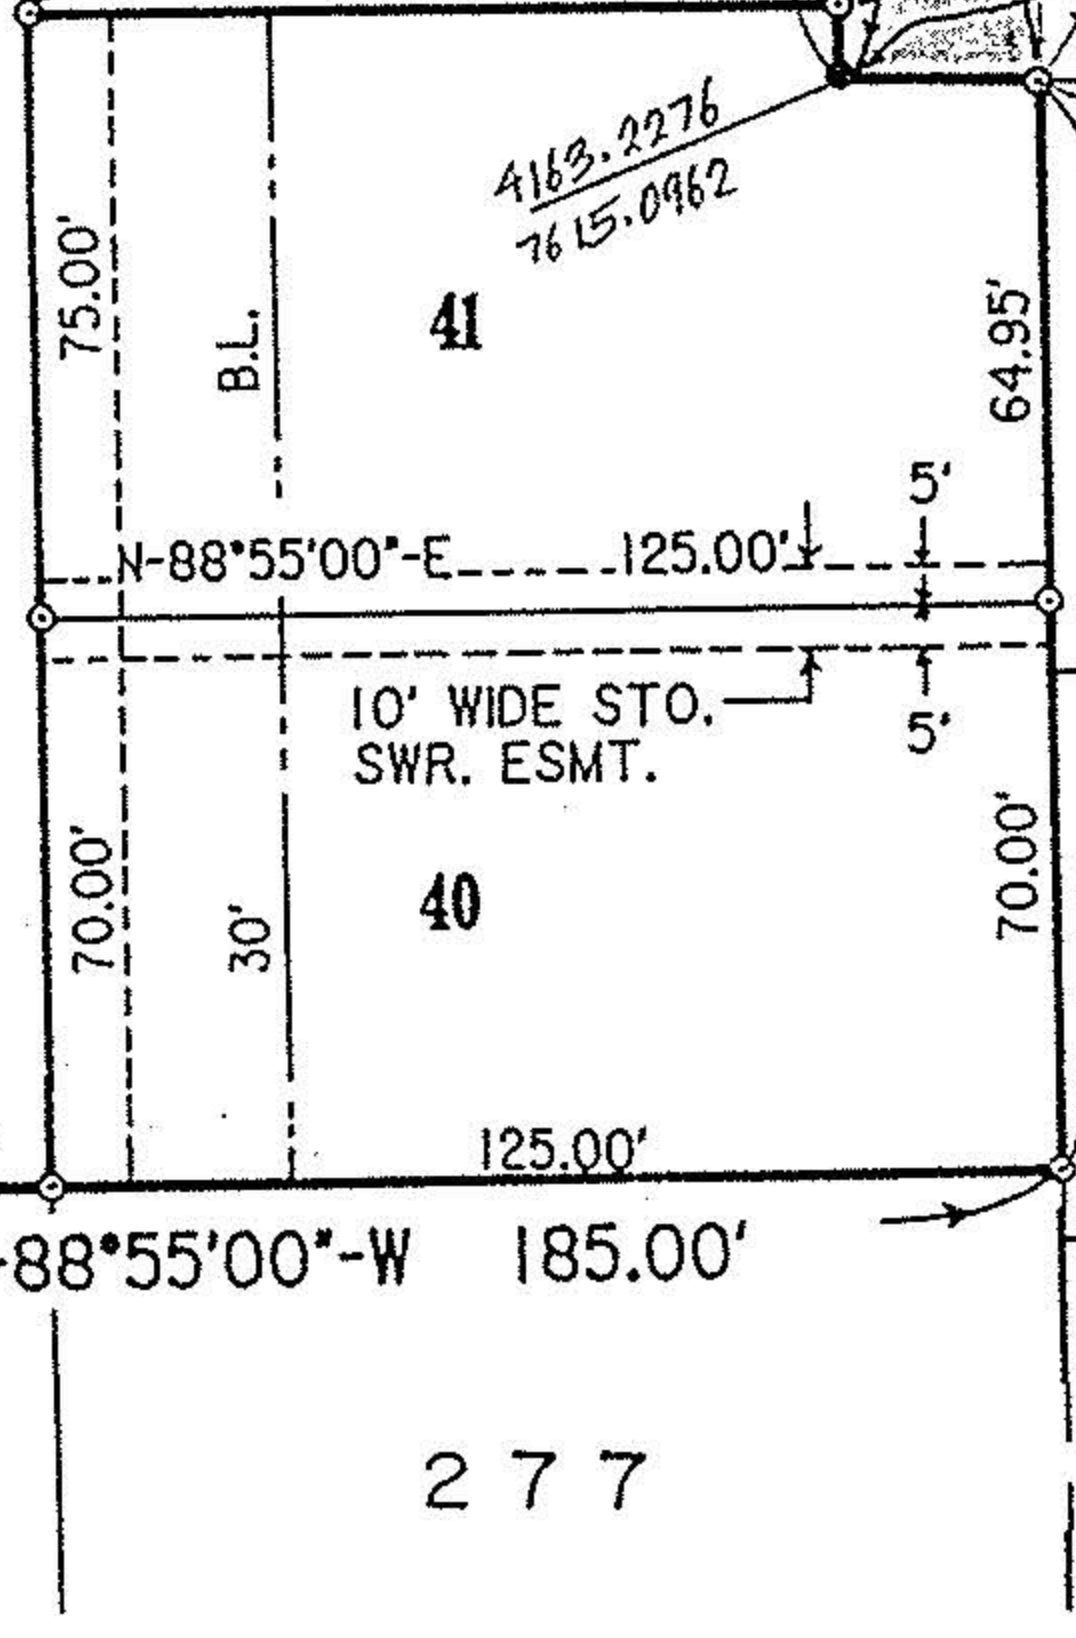

10' WIDE STO. SWR. ESMT.

S-1°05'00"-E 134.95'

SUBDIVISION No. 1

P. 70 & 71

2
3

#18489

APPROVED
 LORAIN CO.
 MAP DEPT.

DATE 6-20-89

PAGE 10-00-005-B

BY Carolyn FRANKS

VOID AFTER #18489

ABBE

40.02'

S-1°05'00"-E 179.94'

$\frac{4288.2053}{7612.7329}$

$\frac{4287.9757}{7637.6618}$

$\frac{4163.2276}{7615.0962}$

$\frac{4162.9980}{7640.0251}$

41

40

277