PLAT OF SURVEY FOR RICHARD C. & SHEILA M. FISHBURN
PART OF O.L. Nº 66 EATON TOWNSHIP
LORAIN COUNTY, OHIO

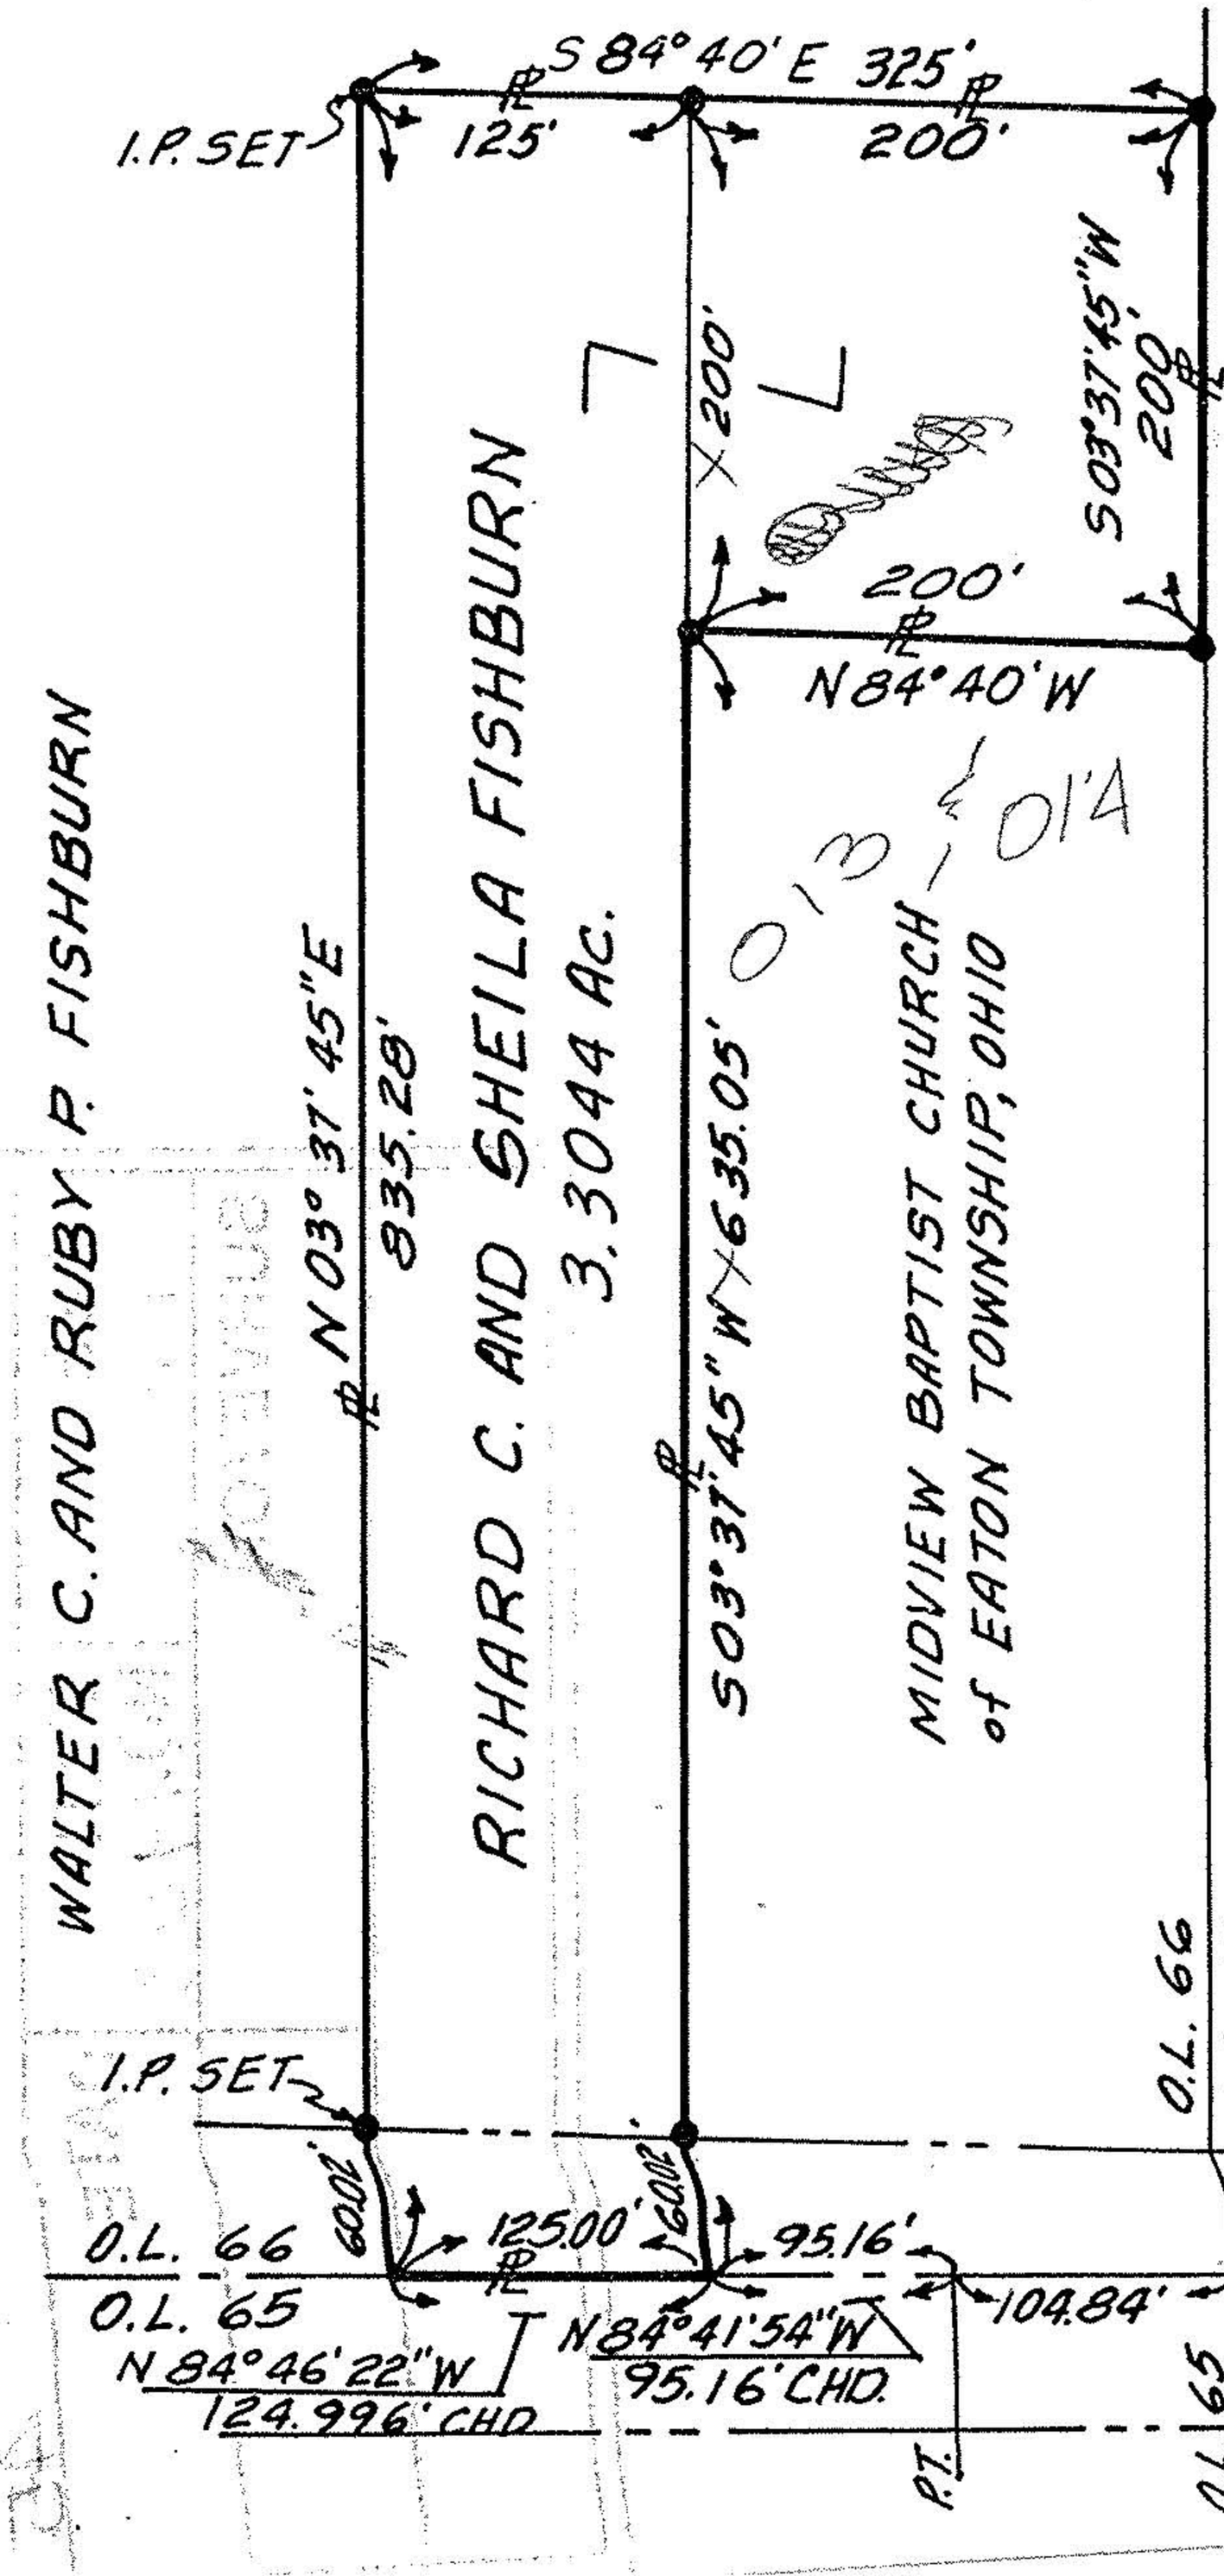

0.12 & 0.14

#19228
APPROVED
LORAIN CO.
MAP DEPT.
DATE 12-21-90
PAGE 11-B
BY Carolyn Francis

SCALE 1" = 100'
AFTER # 19228

IRON PINS WERE SET OR FOUND AT ALL POINTS INDICATED BY A "•". DIMENSIONS ARE EXPRESSED IN FEET AND DECIMAL PARTS THEREOF, ALL OF WHICH I CERTIFY TO BE CORRECT.

Raymond W Hass
S-5152

DATE: OCT. 19, 1990

STATE OF OHIO
RAYMOND W. HASS
S-5152
REGISTERED SURVEYOR

11-B

FILED FOR RECORD
OCT 22 1990