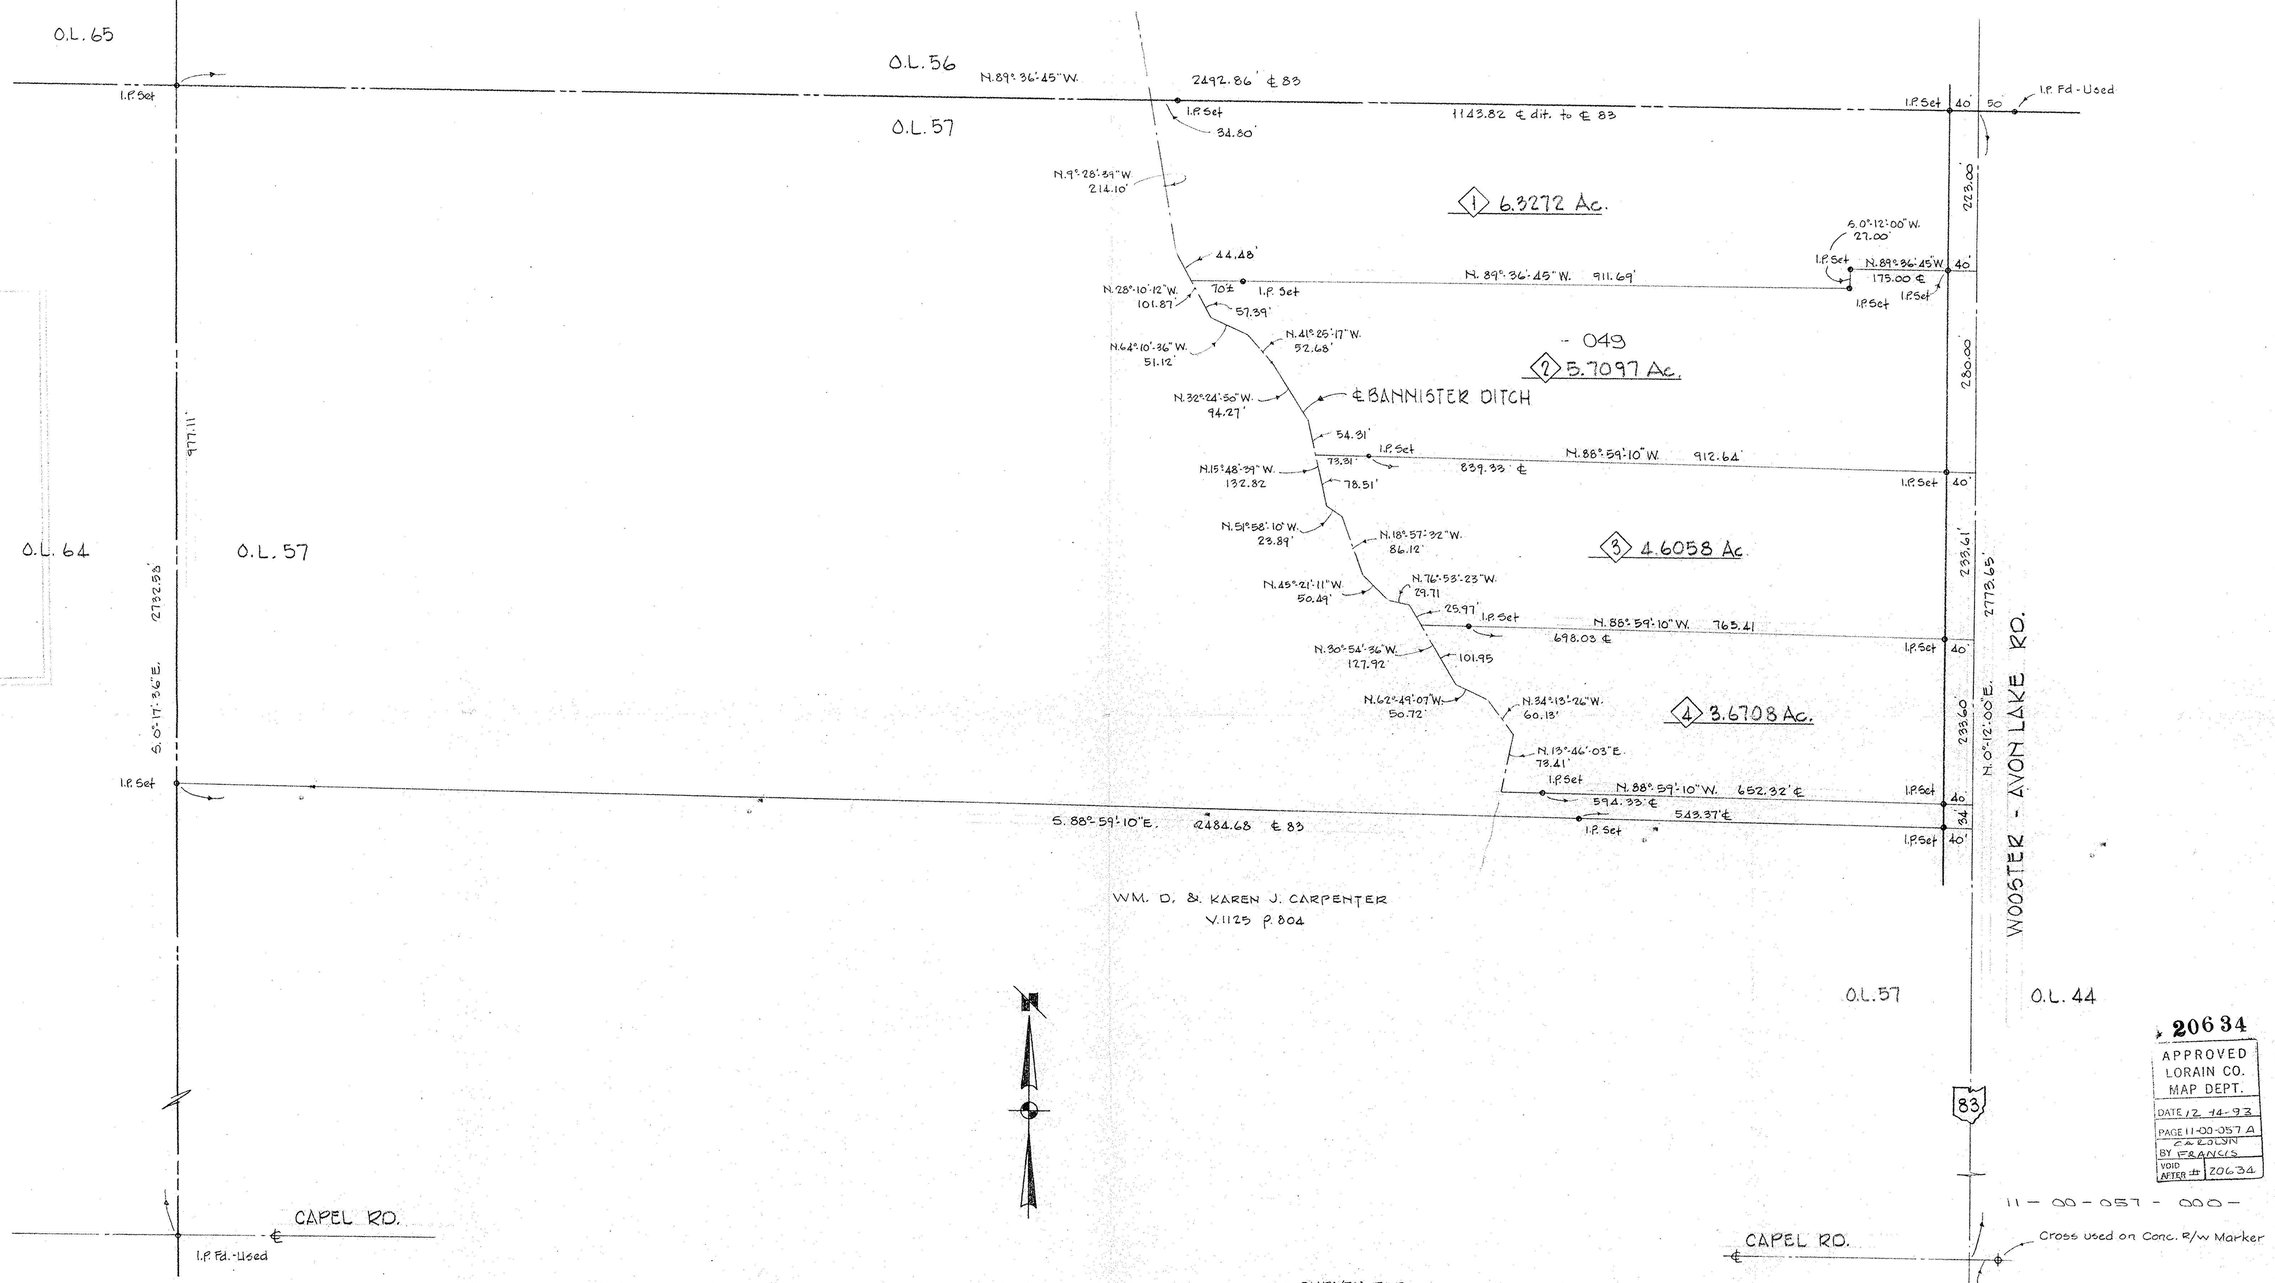

SURVEY FOR

MARIE K. CROWELL

PART OF O.L. 57 TOWNSHIP OF EATON

COUNTY OF LORAIN STATE OF OHIO

SCALE 1"=100' OCT. 1993

LAUNDON • SIMON • CAHL & ASSOC.

ENGINEERS SURVEYORS

JOB 93-2484 FB. 232 P. 1, 3 & 8