

NORTH


LINDA HAZLETT
D.V. 1263, Pg. 44

N 89° 35' 43" E 535.00'

I.P. SET

Last week / 2
(KORVATICH INC.)
O.R. VOL. 324, Pg. 16

- 036
5.0110 ACRES

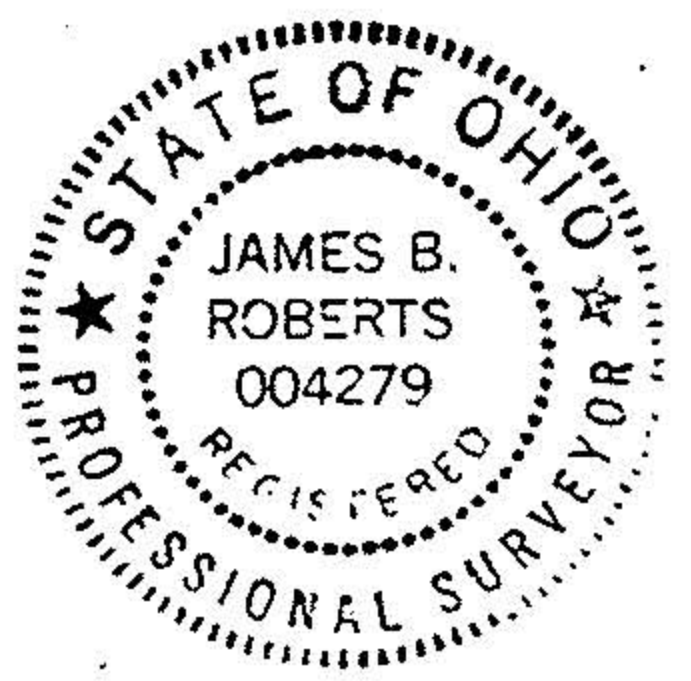

S 89° 35' 43" W 535.00'

I.P. SET

DARLENE J. CORP
D.V. 21608

APPROVED
LORAIN CO.
MAP DEPT

MAP OF PARCEL SPLIT SURVEY
PREPARED FOR JIM KNECHTES
PART OF ORIGINAL EATON TWP LOT No. 73
TOWNSHIP OF EATON, LORAIN COUNTY, OHIO

DATE 12-15-95

PAGE 11-B

K.E. MCCARTNEY & ASSOCIATES INC.
ENGINEERS - SURVEYORS
ELYRIA, OHIO
NOVEMBER, 1995 #955677s

BY CAROLYN
FRANCIS

21608

DURKEE ROAD - 60'
 400° 30' W 408.00'
 300.00'
 MON. 200'

O.L. 73
O.L. 74

O.L. 88
O.L. 73

P.K. SET

P.K. SET

I.P. SET