LAUNDON · SIMON · CAHL & ASSOC. INC.
CONSULTING ENGINEERS & SURVEYORS
ELYRIA, OHIO 44035

SURVEY FOR
# MELVIN H. TERNES

| | | |
|---|---|---|
| Orig. Lot 71 | City of | Date FEB. '85 Scale 1"=150' |
| Orig. Sec | Village of | Dwn. by R.G.S. Chkd. by |
| Tract | County of LORAIN | Job No. 85-1353 F.B. |
| Township of EATON | State of OHIO | Printed FEB 27 1985 |

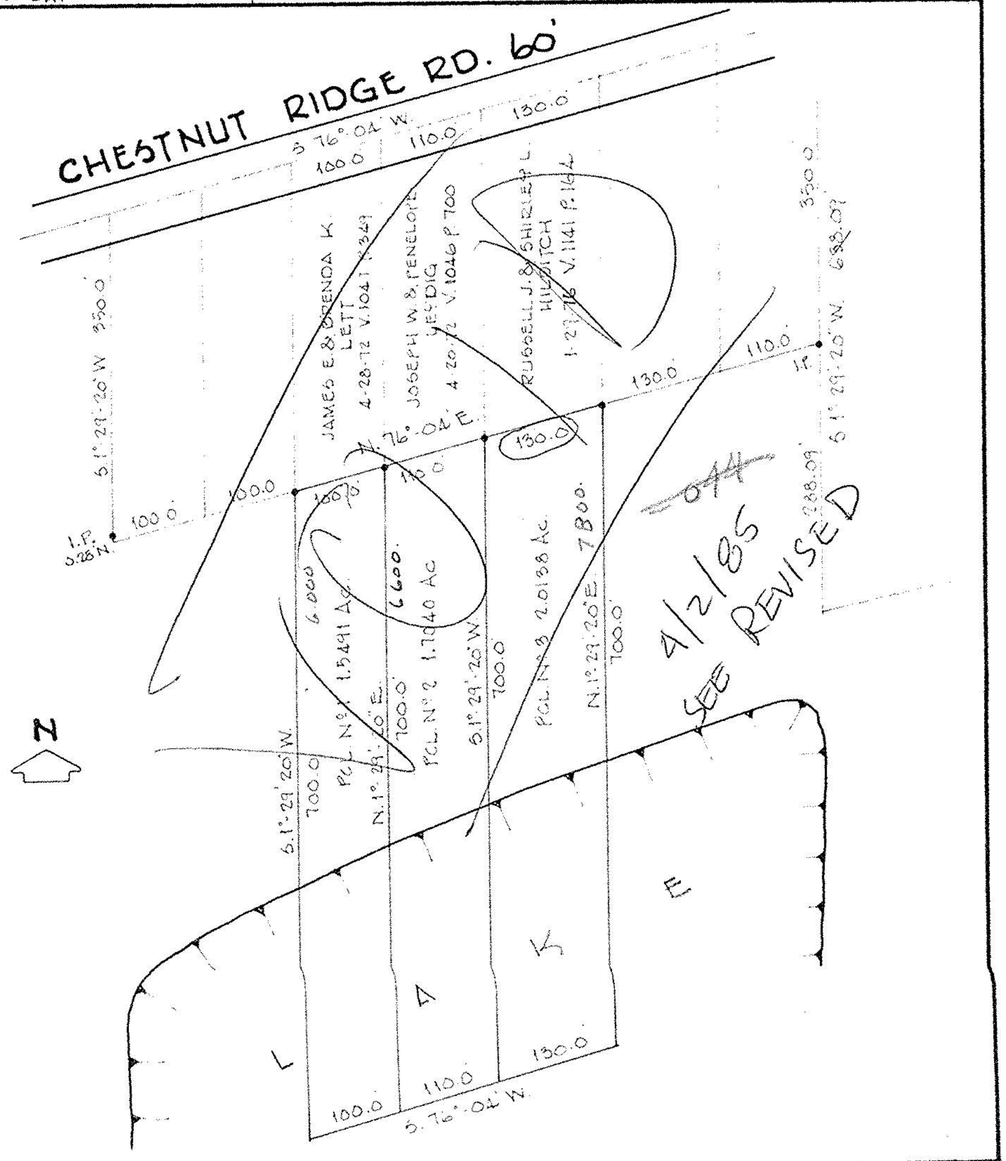


11-00-071-A
#16107

LAUNDON · SIMON · CAHL & ASSOC. INC.
CONSULTING ENGINEERS & SURVEYORS
ELYRIA, OHIO 44035

SURVEY FOR
MELVIN H. TERNES

| | | |
|---|---|---|
| Orig. Lot 71 | City of | Date FEB. '85 Scale 1"=150' |
| Orig. Sec | Village of | Dwn. by R.G.S. Chkd. by |
| Tract | County of LORAIN | Job No. 85-1353 F.B. |
| Township of EATON | State of OHIO | Printed APR 02 1985 |

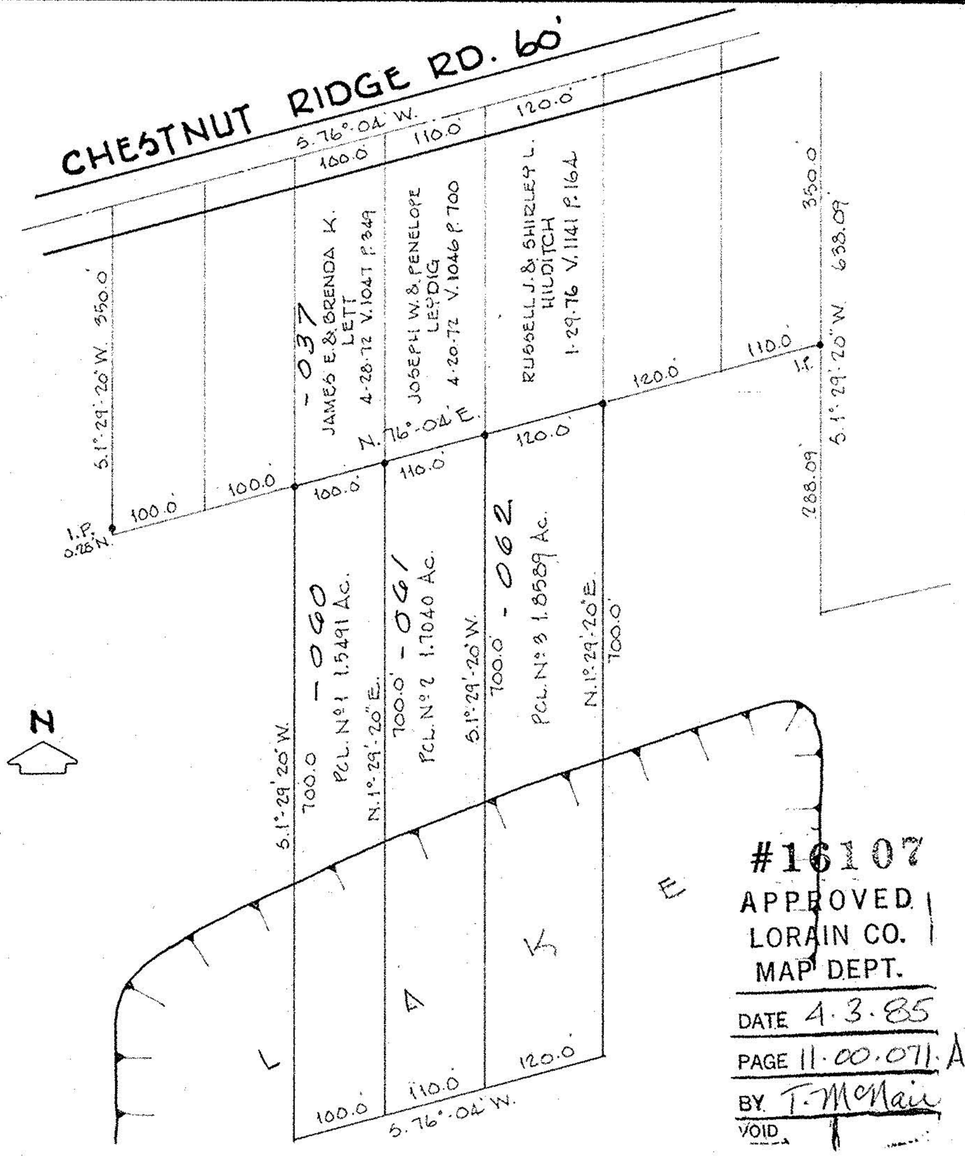


11-00-071-A
#16107

#16107
APPROVED
LORAIN CO.
MAP DEPT.
DATE 4-3-85
PAGE 11-00-071-A
BY T. McNair
VOID