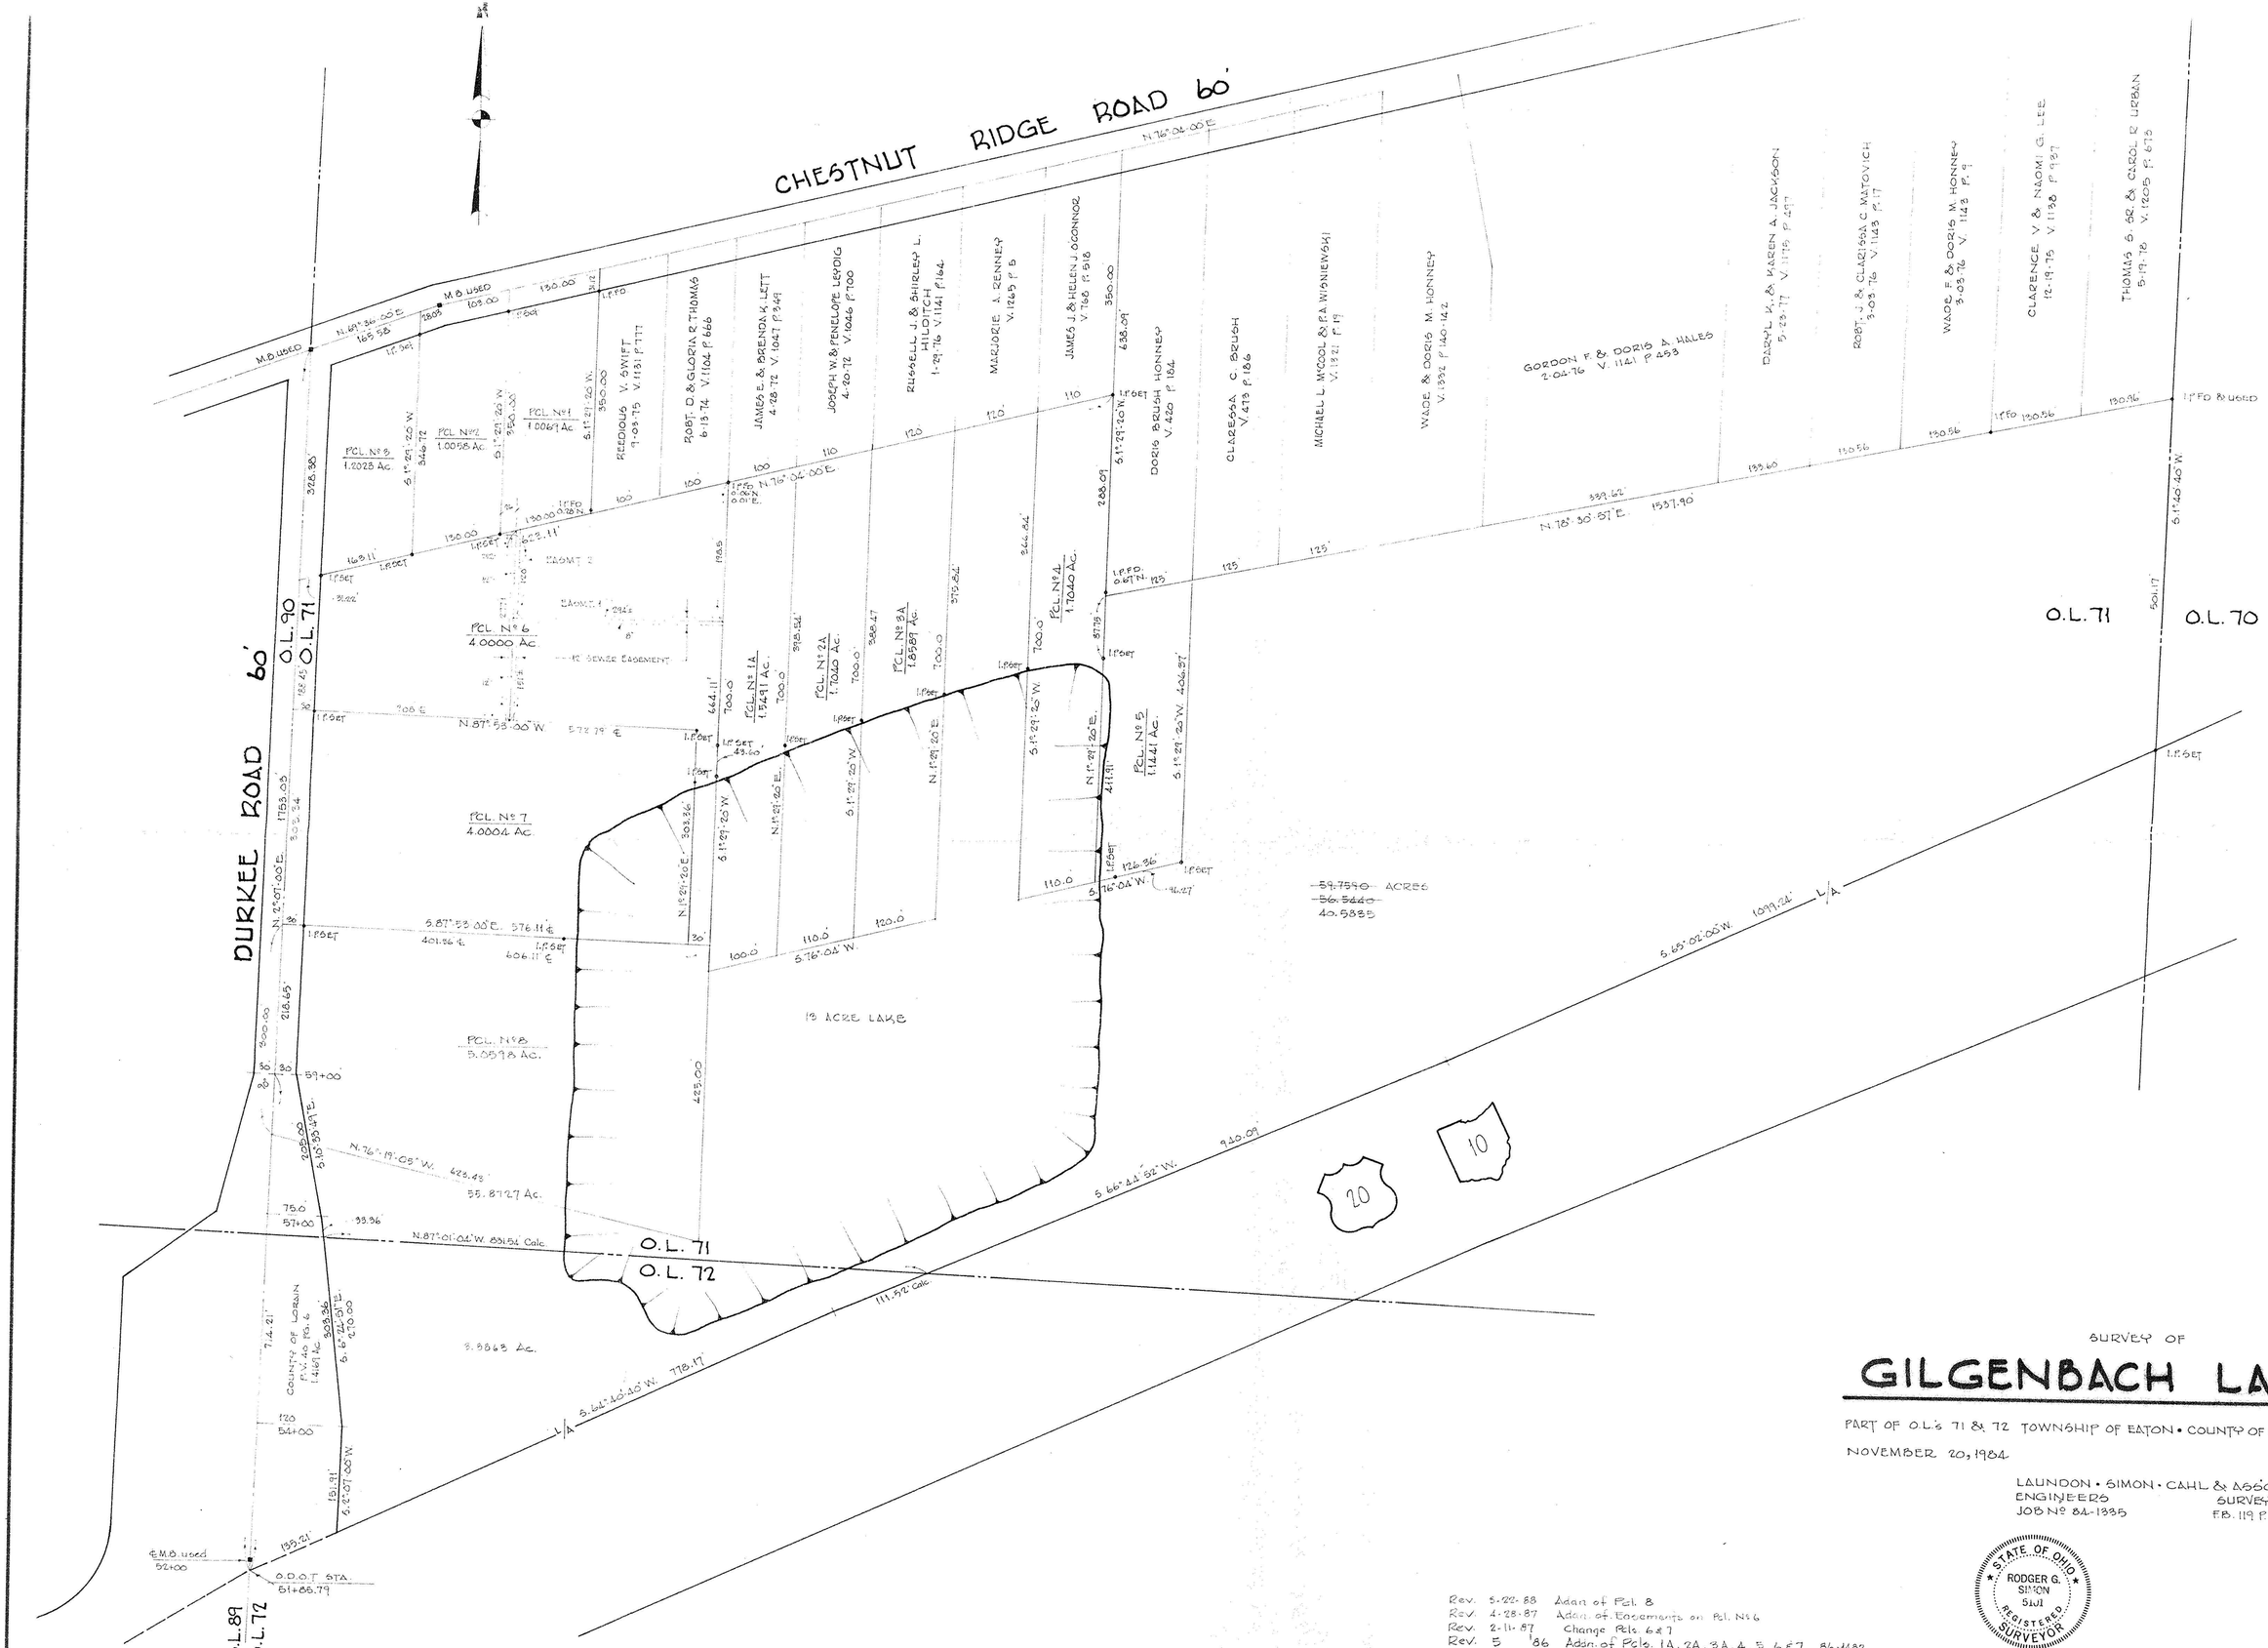

SURVEY OF

GILGENBACH LANDS

PART OF O.L.'s 71 & 72 TOWNSHIP OF EATON • COUNTY OF LORAIN • STATE OF OHIO

NOVEMBER 20, 1984

SCALE 1" = 100'

11-00-071-000 —

LAUNDON • SIMON • CAHL & ASSOC.
ENGINEERS SURVEYORS
JOB Nº 84-1335 F.B. 119 P. 64

STATE OF OHIO
RODGER G. SIMON
5101
REGISTERED SURVEYOR

#17929

APPROVED
LORAIN CO.
MAP DEPT.

DATE 5-3-88
PAGE 11-00-071-A
BY CAROL-FRANKS
SUB AFTER # 17929

Rev. 5-22-88 Addn of Pcl. 8
Rev. 4-28-87 Addn. of Easements on Pcl. Nº 6
Rev. 2-11-87 Change Pcls. 6 & 7
Rev. 5 '86 Addn. of Pcls. 1A, 2A, 3A, 4, 5, 6 & 7 86-1482
Rev. 10-24-85 - 85-1427
Rev. 12-29-84