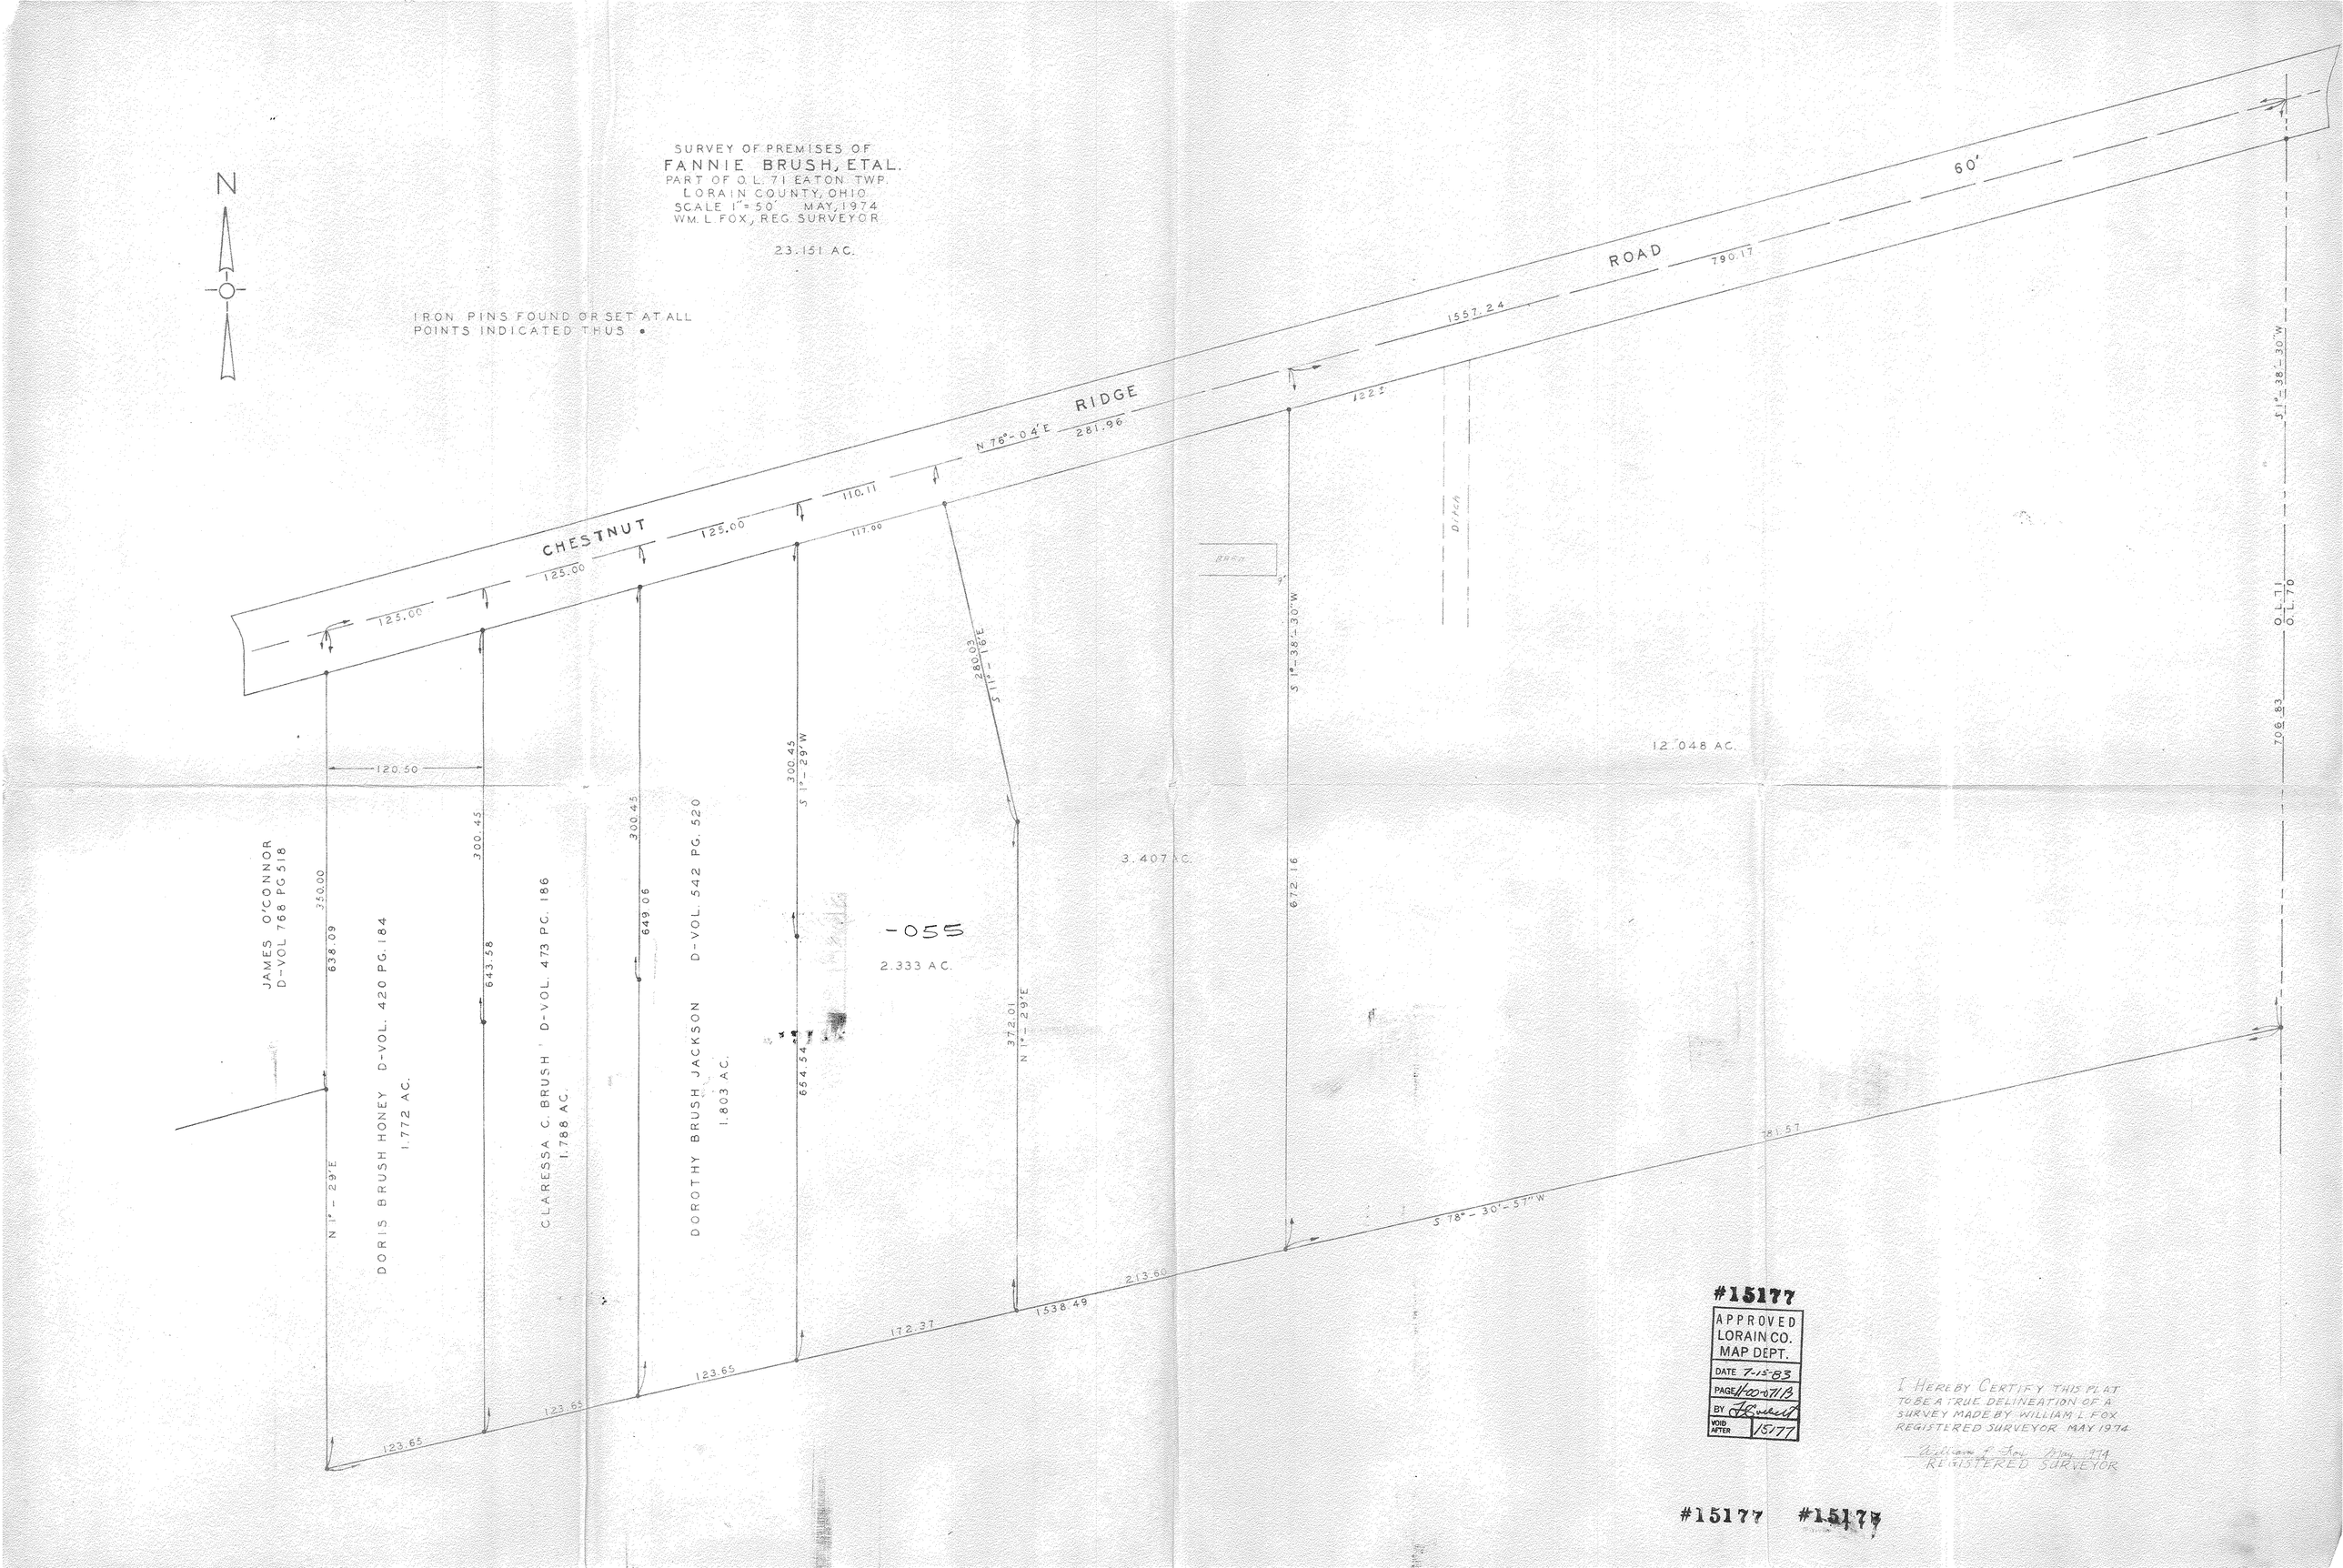
SURVEY OF PREMISES OF
FANNIE BRUSH, ETAL.
PART OF O.L. 71 EATON TWP.
LORAIN COUNTY, OHIO
SCALE 1" = 50' MAY, 1974
WM. L. FOX, REG. SURVEYOR
23.151 AC.
IRON PINS FOUND OR SET AT ALL POINTS INDICATED THUS •
N
CHESTNUT RIDGE ROAD
60'
N 76°-04'E
281.96
1557.24
790.17
125.00
110.11
117.00
122±
Ditch
BARN
S 1°-38'-30"W
S 11°-16'E
280.03
S 1°-38'-30"W
12.048 AC.
706.83
O.L. 71
O.L. 70
120.50
300.45
S 1°-29'W
300.45
3.407 AC.
672.16
JAMES O'CONNOR
D-VOL 768 PG 518
350.00
638.09
DORIS BRUSH HONEY D-VOL. 420 PG. 184
1.772 AC.
643.58
CLARESSA C. BRUSH D-VOL. 473 PG. 186
1.788 AC.
649.06
DOROTHY BRUSH JACKSON D-VOL. 542 PG. 520
1.803 AC.
654.54
-055
2.333 AC.
372.01
N 1°-29'E
N 1°-29'E
781.57
S 78°-30'-57"W
213.60
1538.49
172.37
123.65
123.65
123.65
#15177
APPROVED
LORAIN CO.
MAP DEPT.
DATE 7-15-83
PAGE 11-00-071B
BY
VOID AFTER 15177
I HEREBY CERTIFY THIS PLAT TO BE A TRUE DELINEATION OF A SURVEY MADE BY WILLIAM L. FOX REGISTERED SURVEYOR MAY 1974
William L. Fox May 1974
REGISTERED SURVEYOR
#15177 #15177