#18493

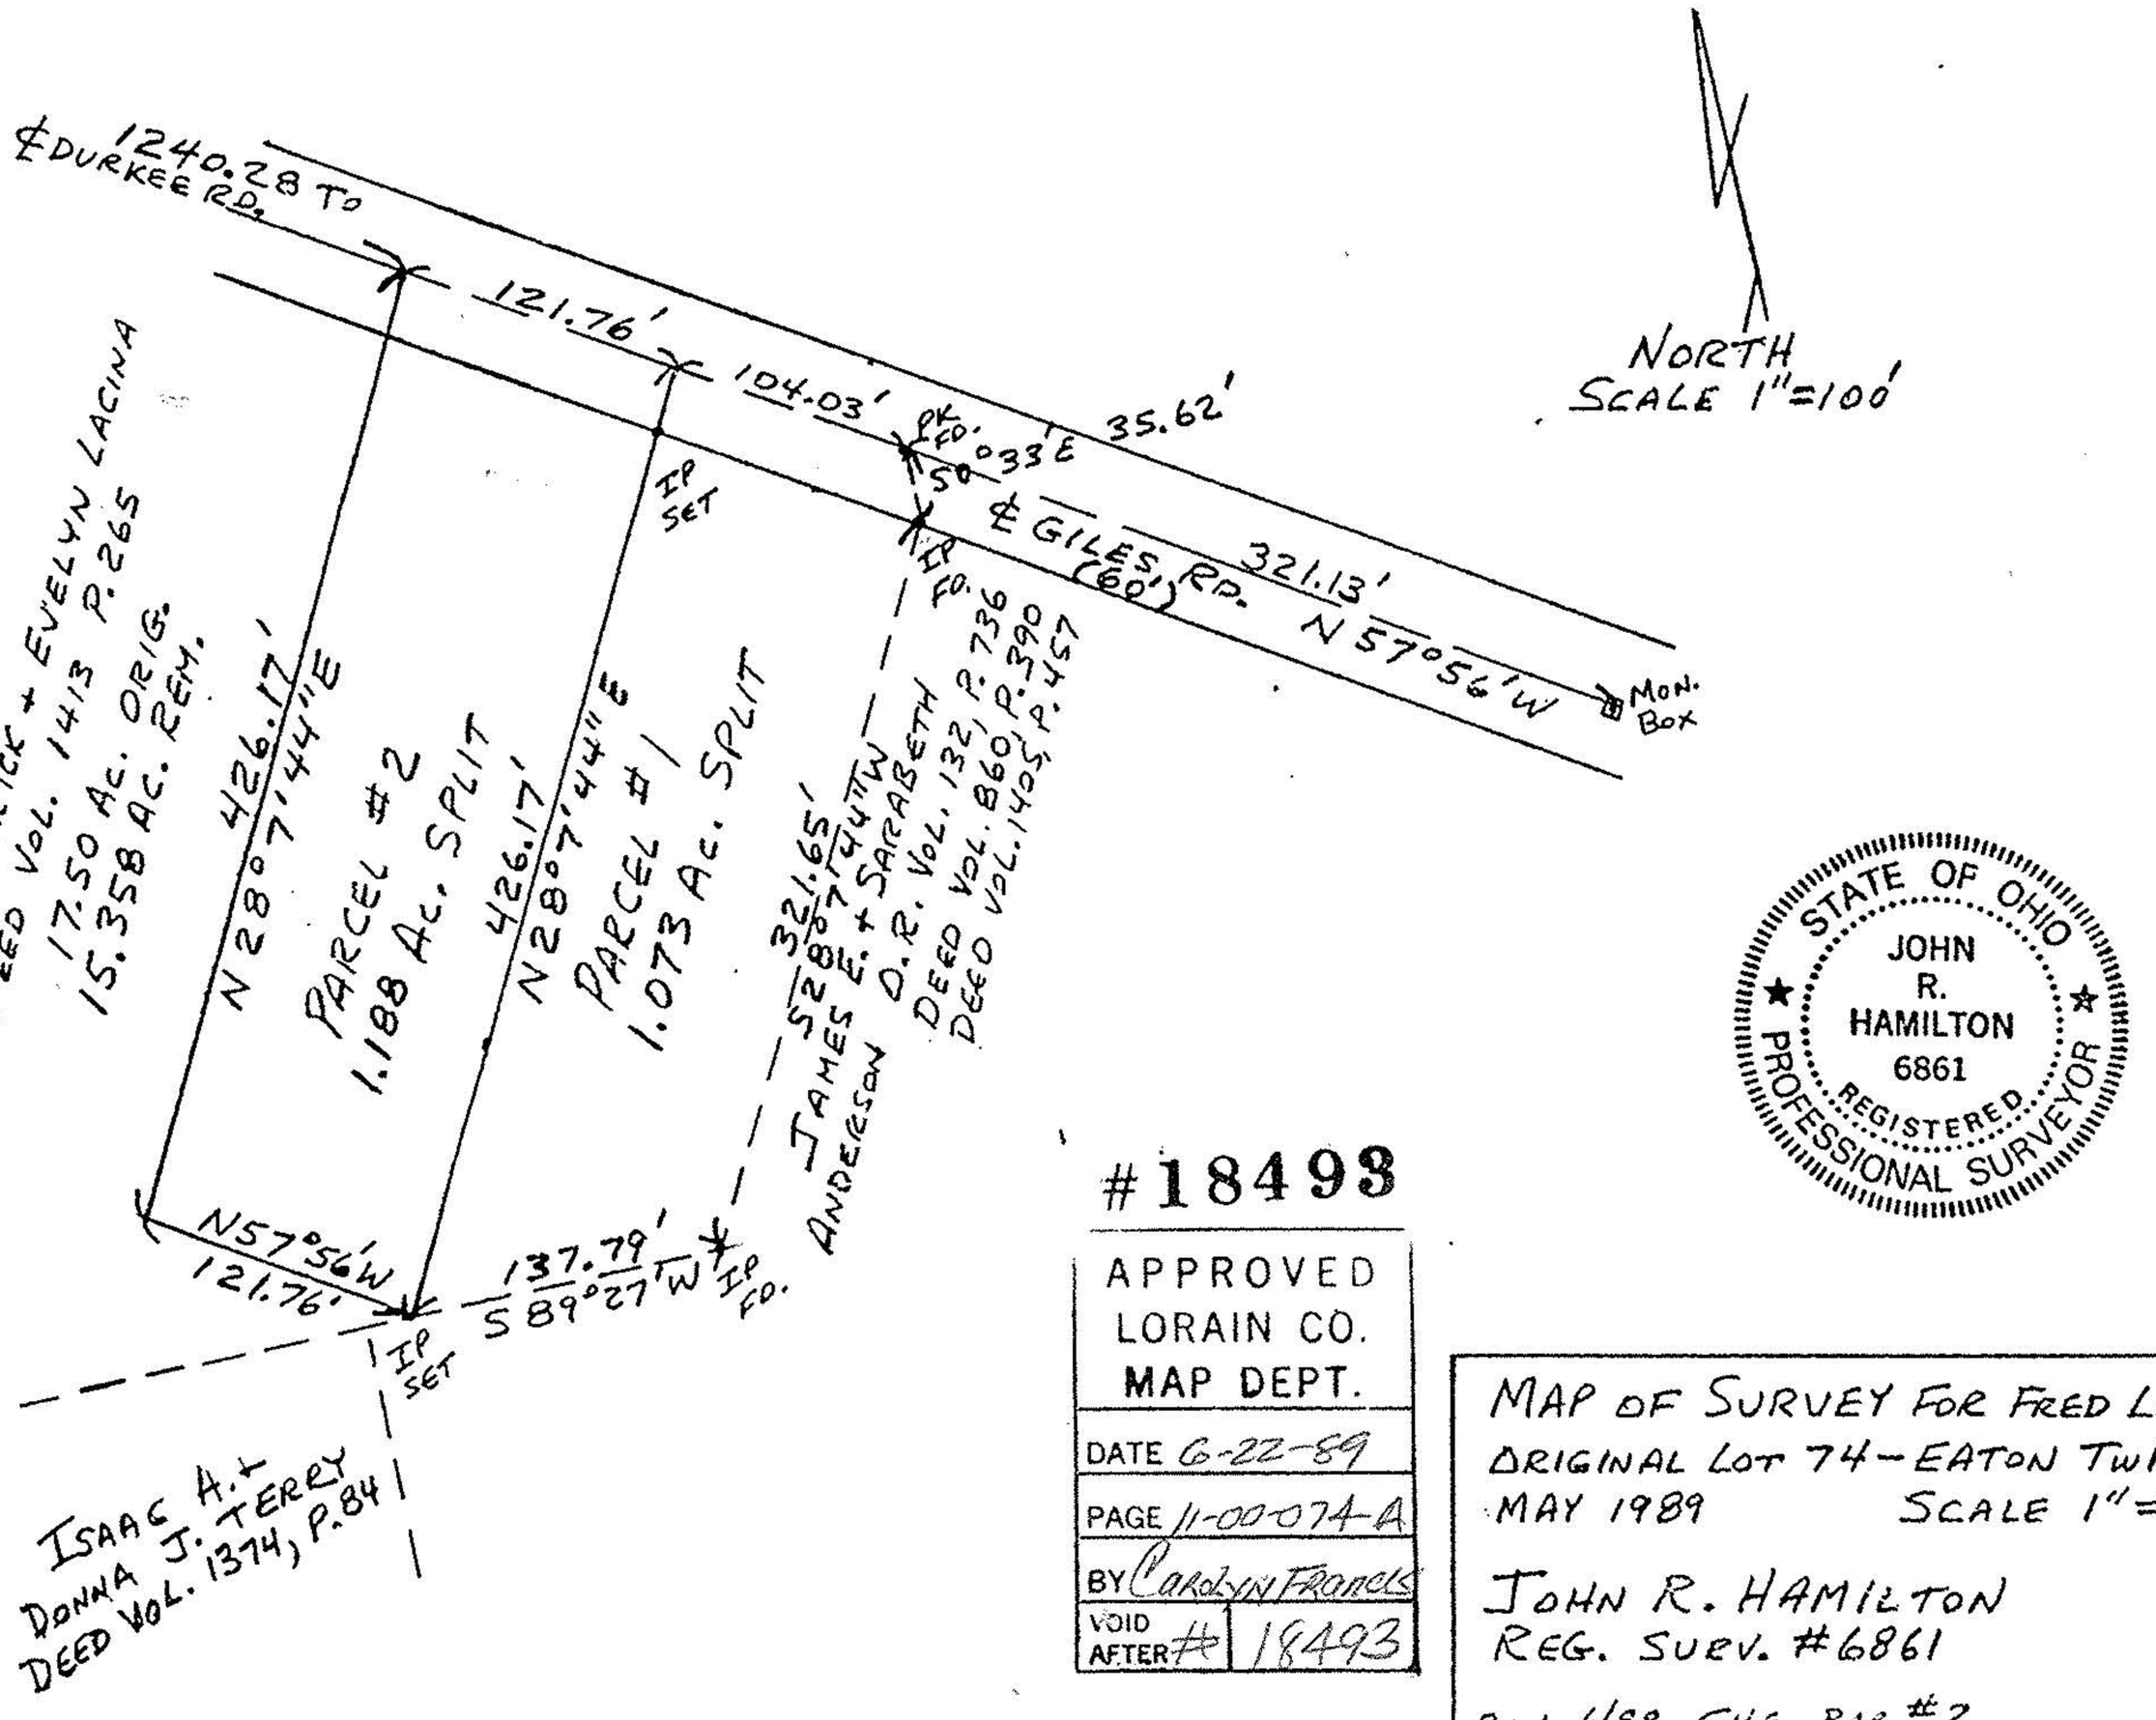

#18493

APPROVED LORAIN CO. MAP DEPT.
DATE 6-22-89
PAGE 11-00-074-A
BY Carolyn Francis
VOID AFTER # 18493

STATE OF OHIO
JOHN R. HAMILTON
6861
REGISTERED PROFESSIONAL SURVEYOR

MAP OF SURVEY FOR FRED LACINA
ORIGINAL LOT 74 - EATON TWP.
MAY 1989 SCALE 1" = 100'

JOHN R. HAMILTON
REG. SURV. #6861

REV. 6/89 CHG. PAR #2.