MAP OF SURVEY FOR DON ANDERSON
O.L. 74 - EATON TWP. - LORAIN CO.
NOV. 1988 SCALE 1" = 100'
JOHN R. HAMILTON REG. SURV. #6861

#18224

APPROVED
LORAIN CO.
MAP DEPT.
DATE 11-21-88
PAGE 11-B 11-00-074-A
BY T. McNair
VOID AFTER

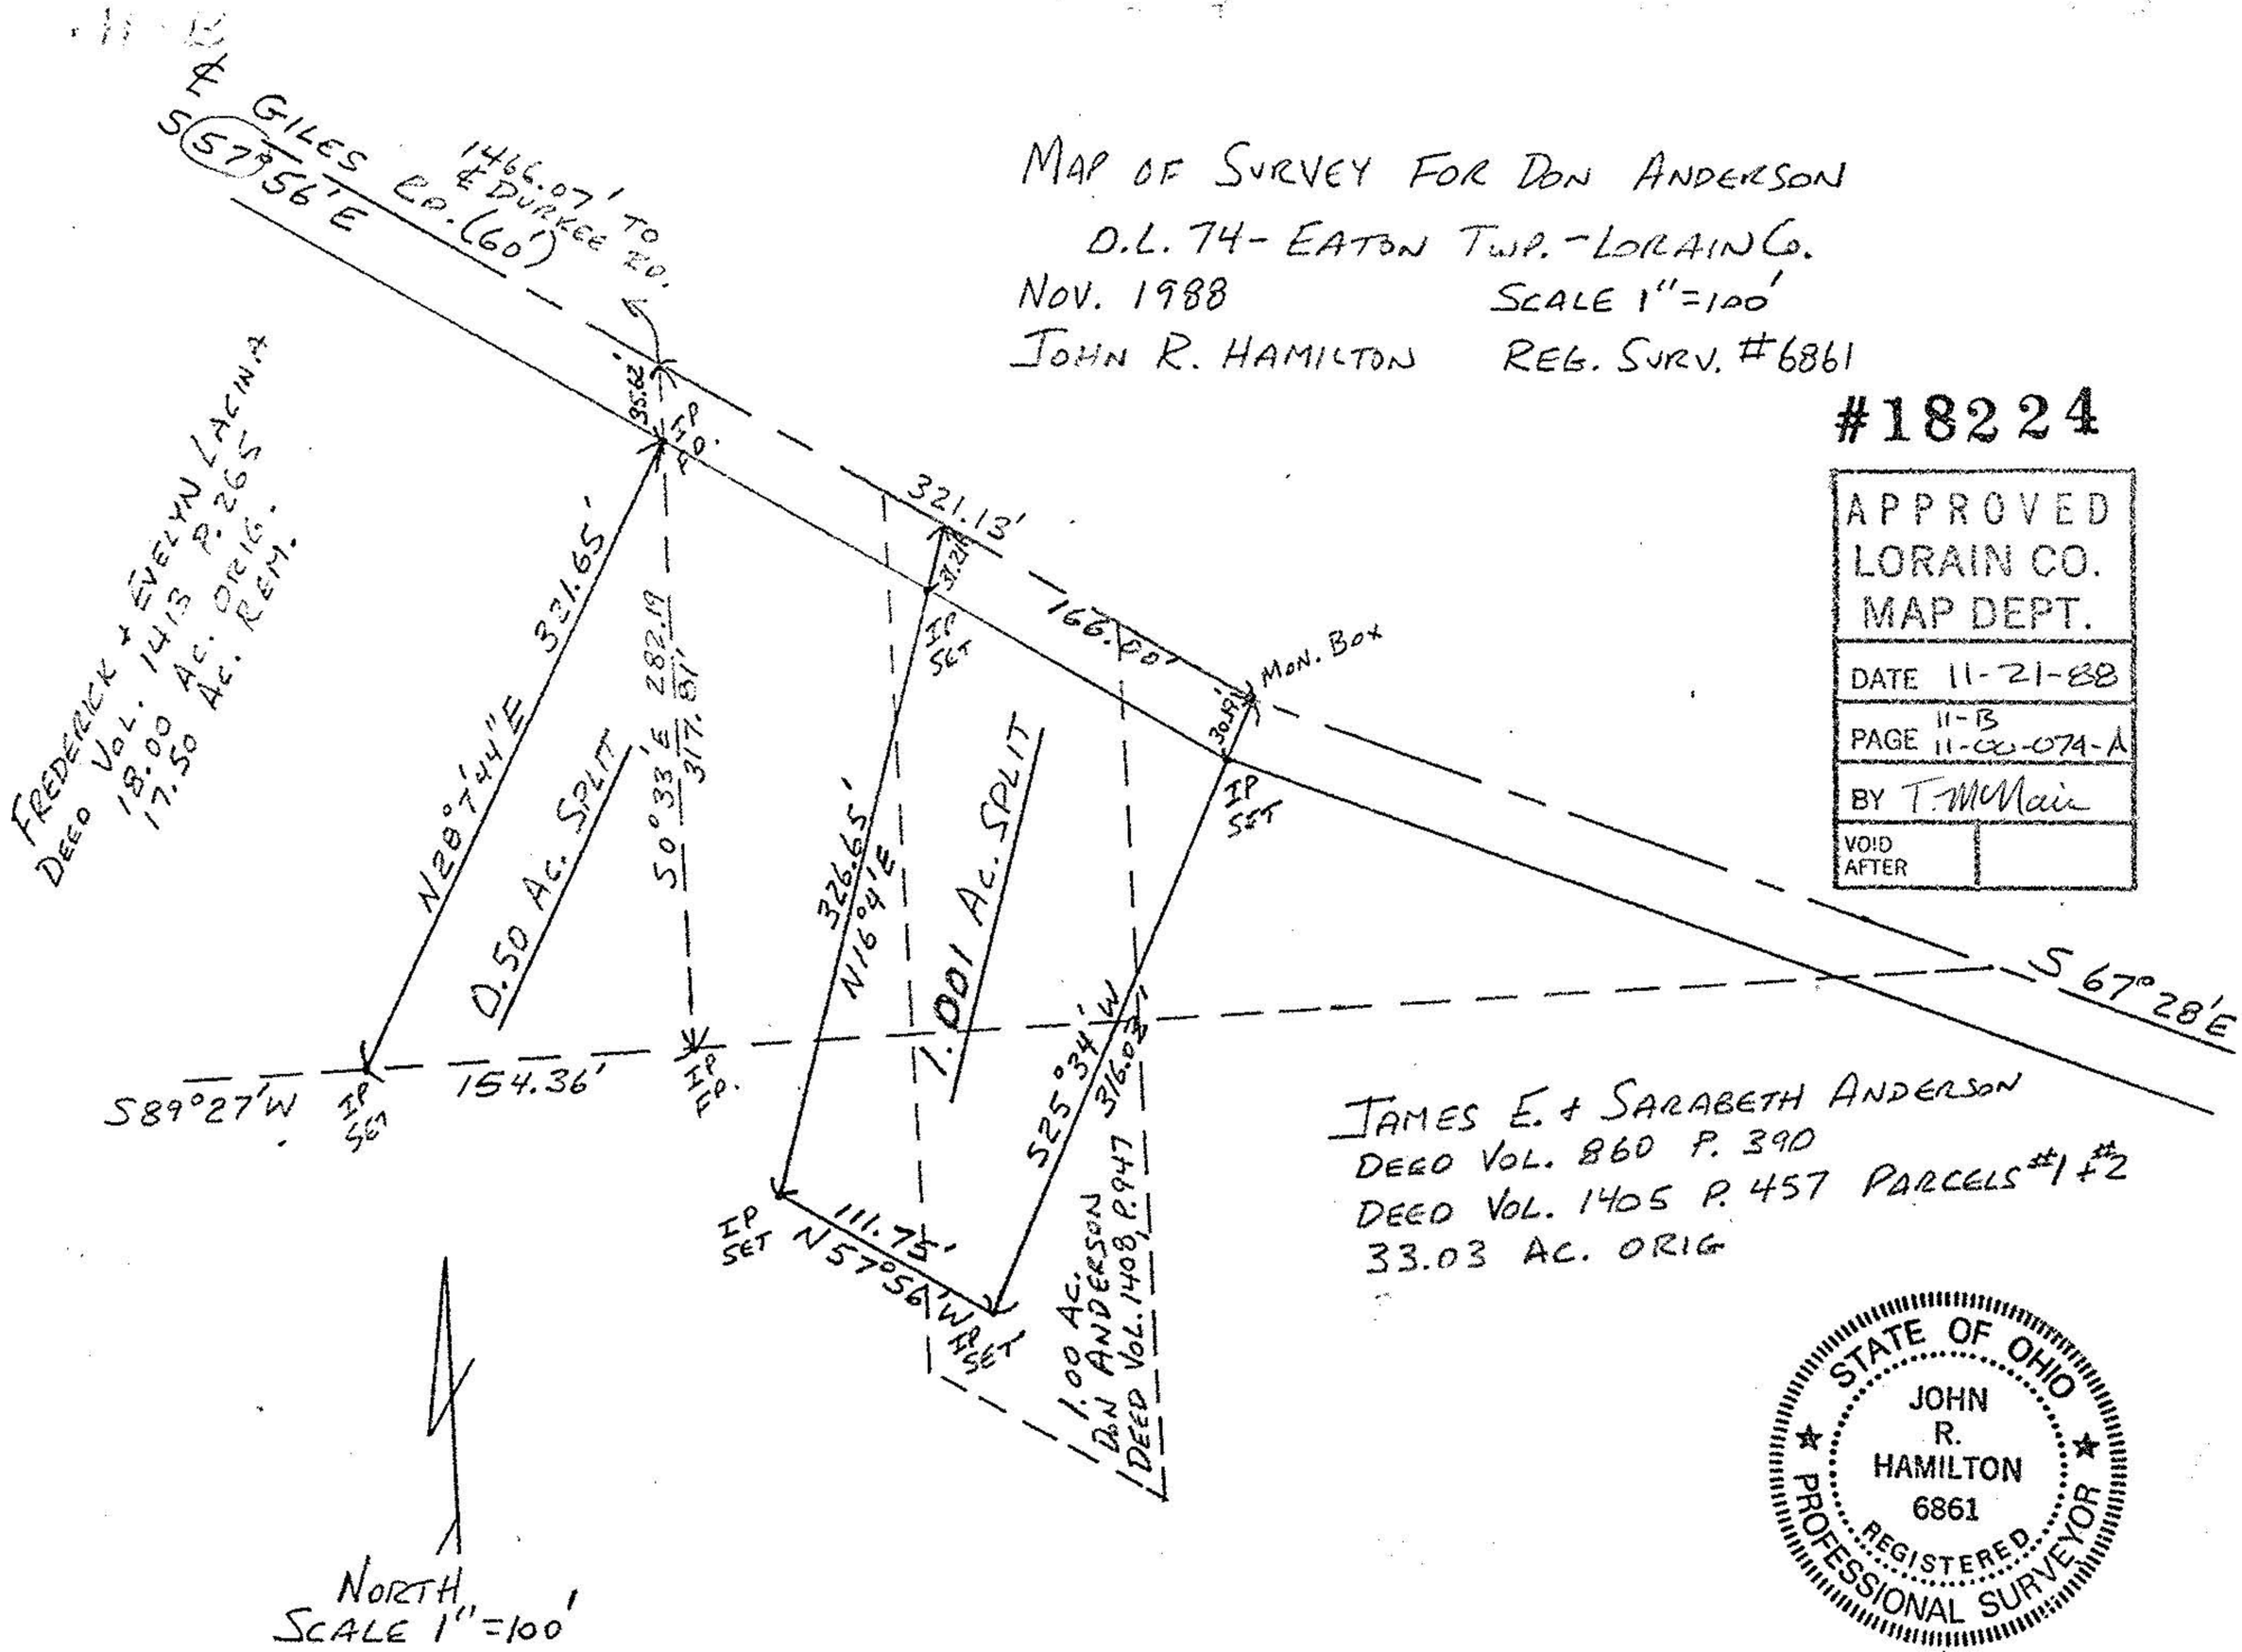

JAMES E. + SARABETH ANDERSON
DEED VOL. 860 P. 390
DEED VOL. 1405 P. 457 PARCELS #1 + #2
33.03 AC. ORIG

STATE OF OHIO
JOHN R. HAMILTON
6861
REGISTERED
PROFESSIONAL SURVEYOR