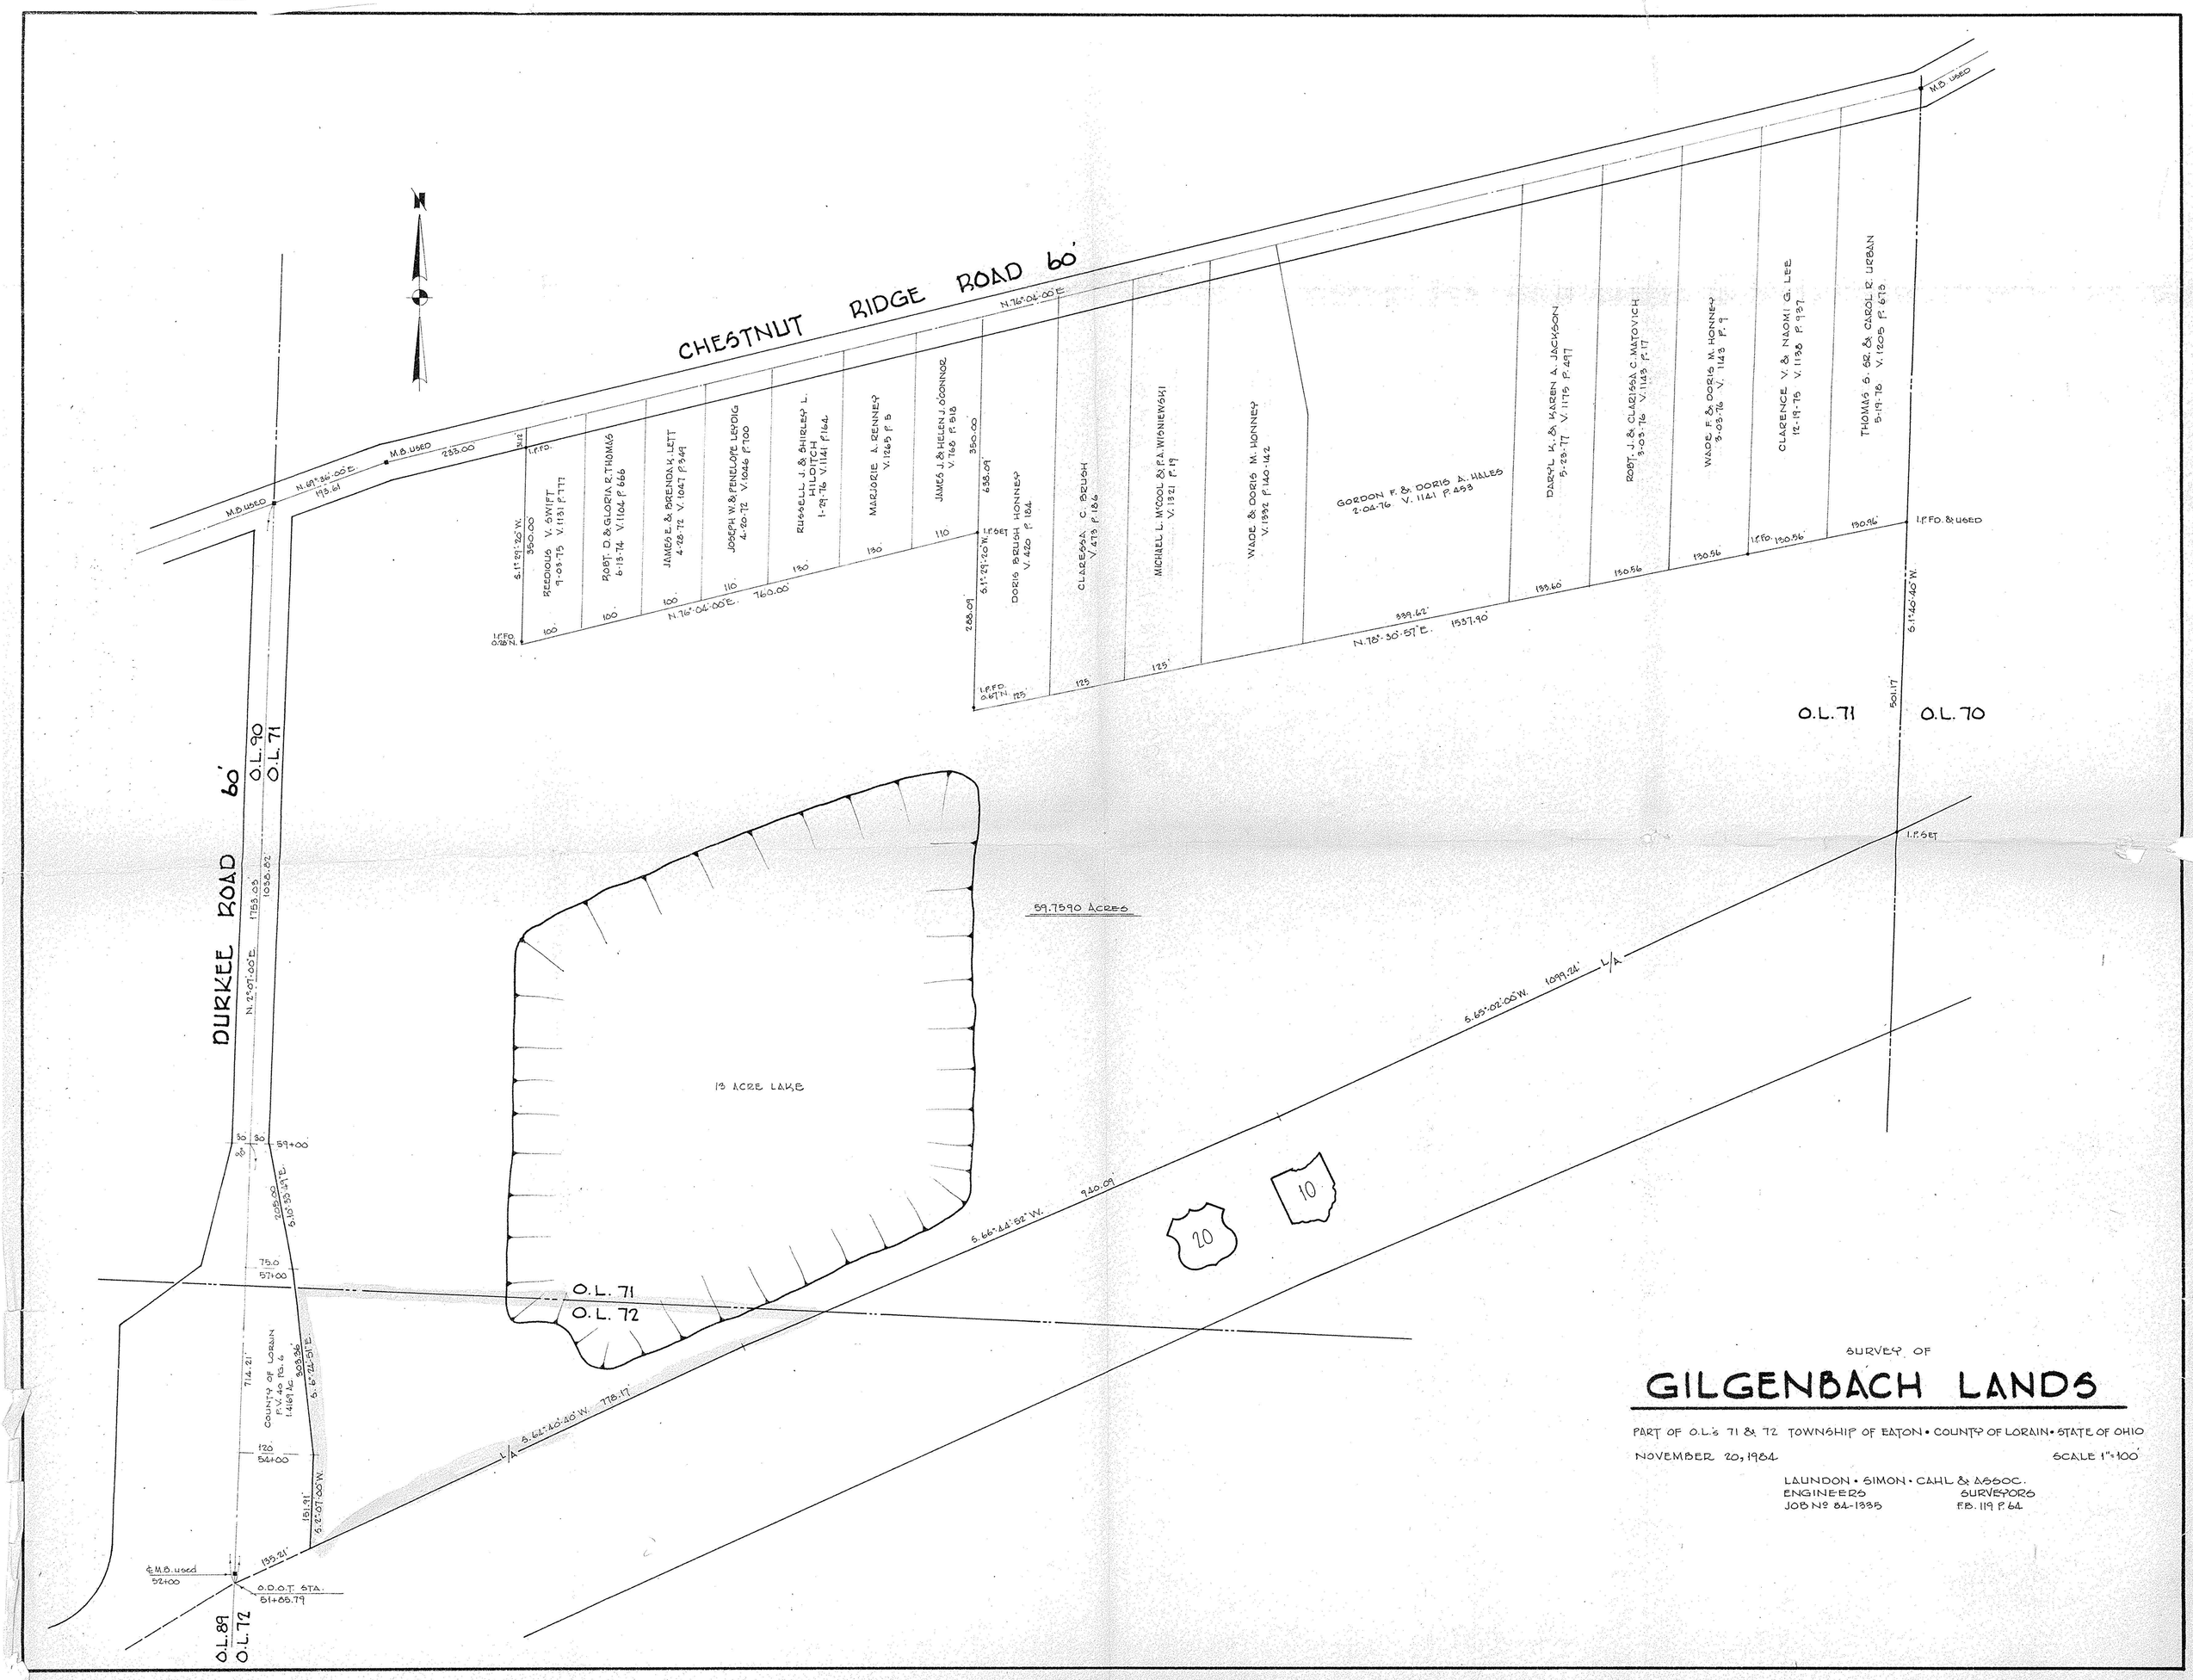

SURVEY OF

GILGENBACH LANDS

PART OF O.L.'s 71 & 72 TOWNSHIP OF EATON • COUNTY OF LORAIN • STATE OF OHIO

NOVEMBER 20, 1981 SCALE 1" = 100'

LAUNDON • SIMON • CAHL & ASSOC.
ENGINEERS SURVEYORS
JOB Nº 81-1335 F.B. 119 P. 64