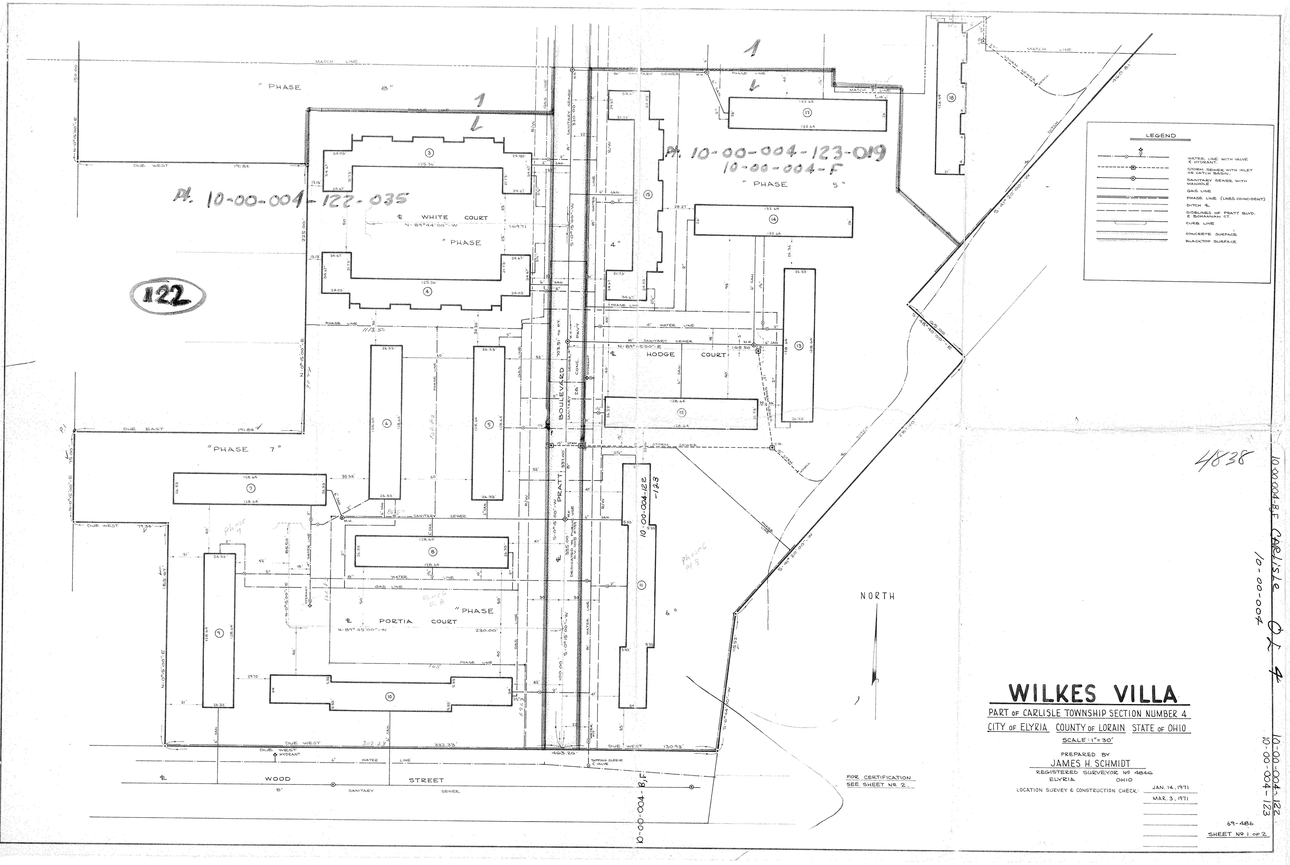


# WILKES VILLA

PART OF CARLISLE TOWNSHIP SECTION NUMBER 4
CITY OF ELYRIA COUNTY OF LORAIN STATE OF OHIO

SCALE 1" = 30'

PREPARED BY
JAMES H. SCHMIDT
REGISTERED SURVEYOR Nº 4846
ELYRIA OHIO

LOCATION SURVEY & CONSTRUCTION CHECK JAN. 14, 1971
MAR. 3, 1971

69-486
SHEET Nº 1 OF 2.

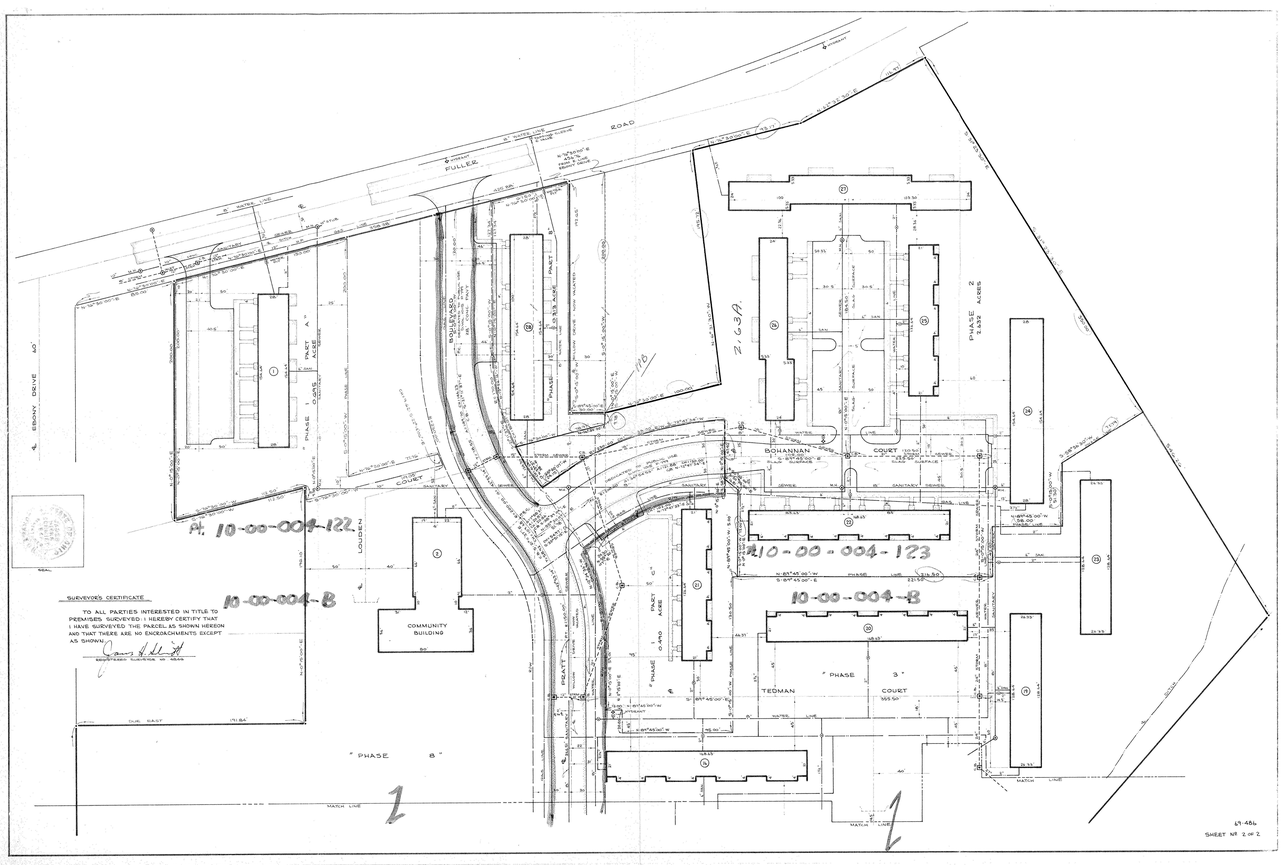


69-486
SHEET Nº 2 OF 2.