LAUNDON · SIMON · CAHL & ASSOC. INC.
CONSULTING ENGINEERS & SURVEYORS
219 COURT ST. ELYRIA, OHIO 44035

SURVEY FOR:

PHILIP K. & ROSELLA P. NORTON
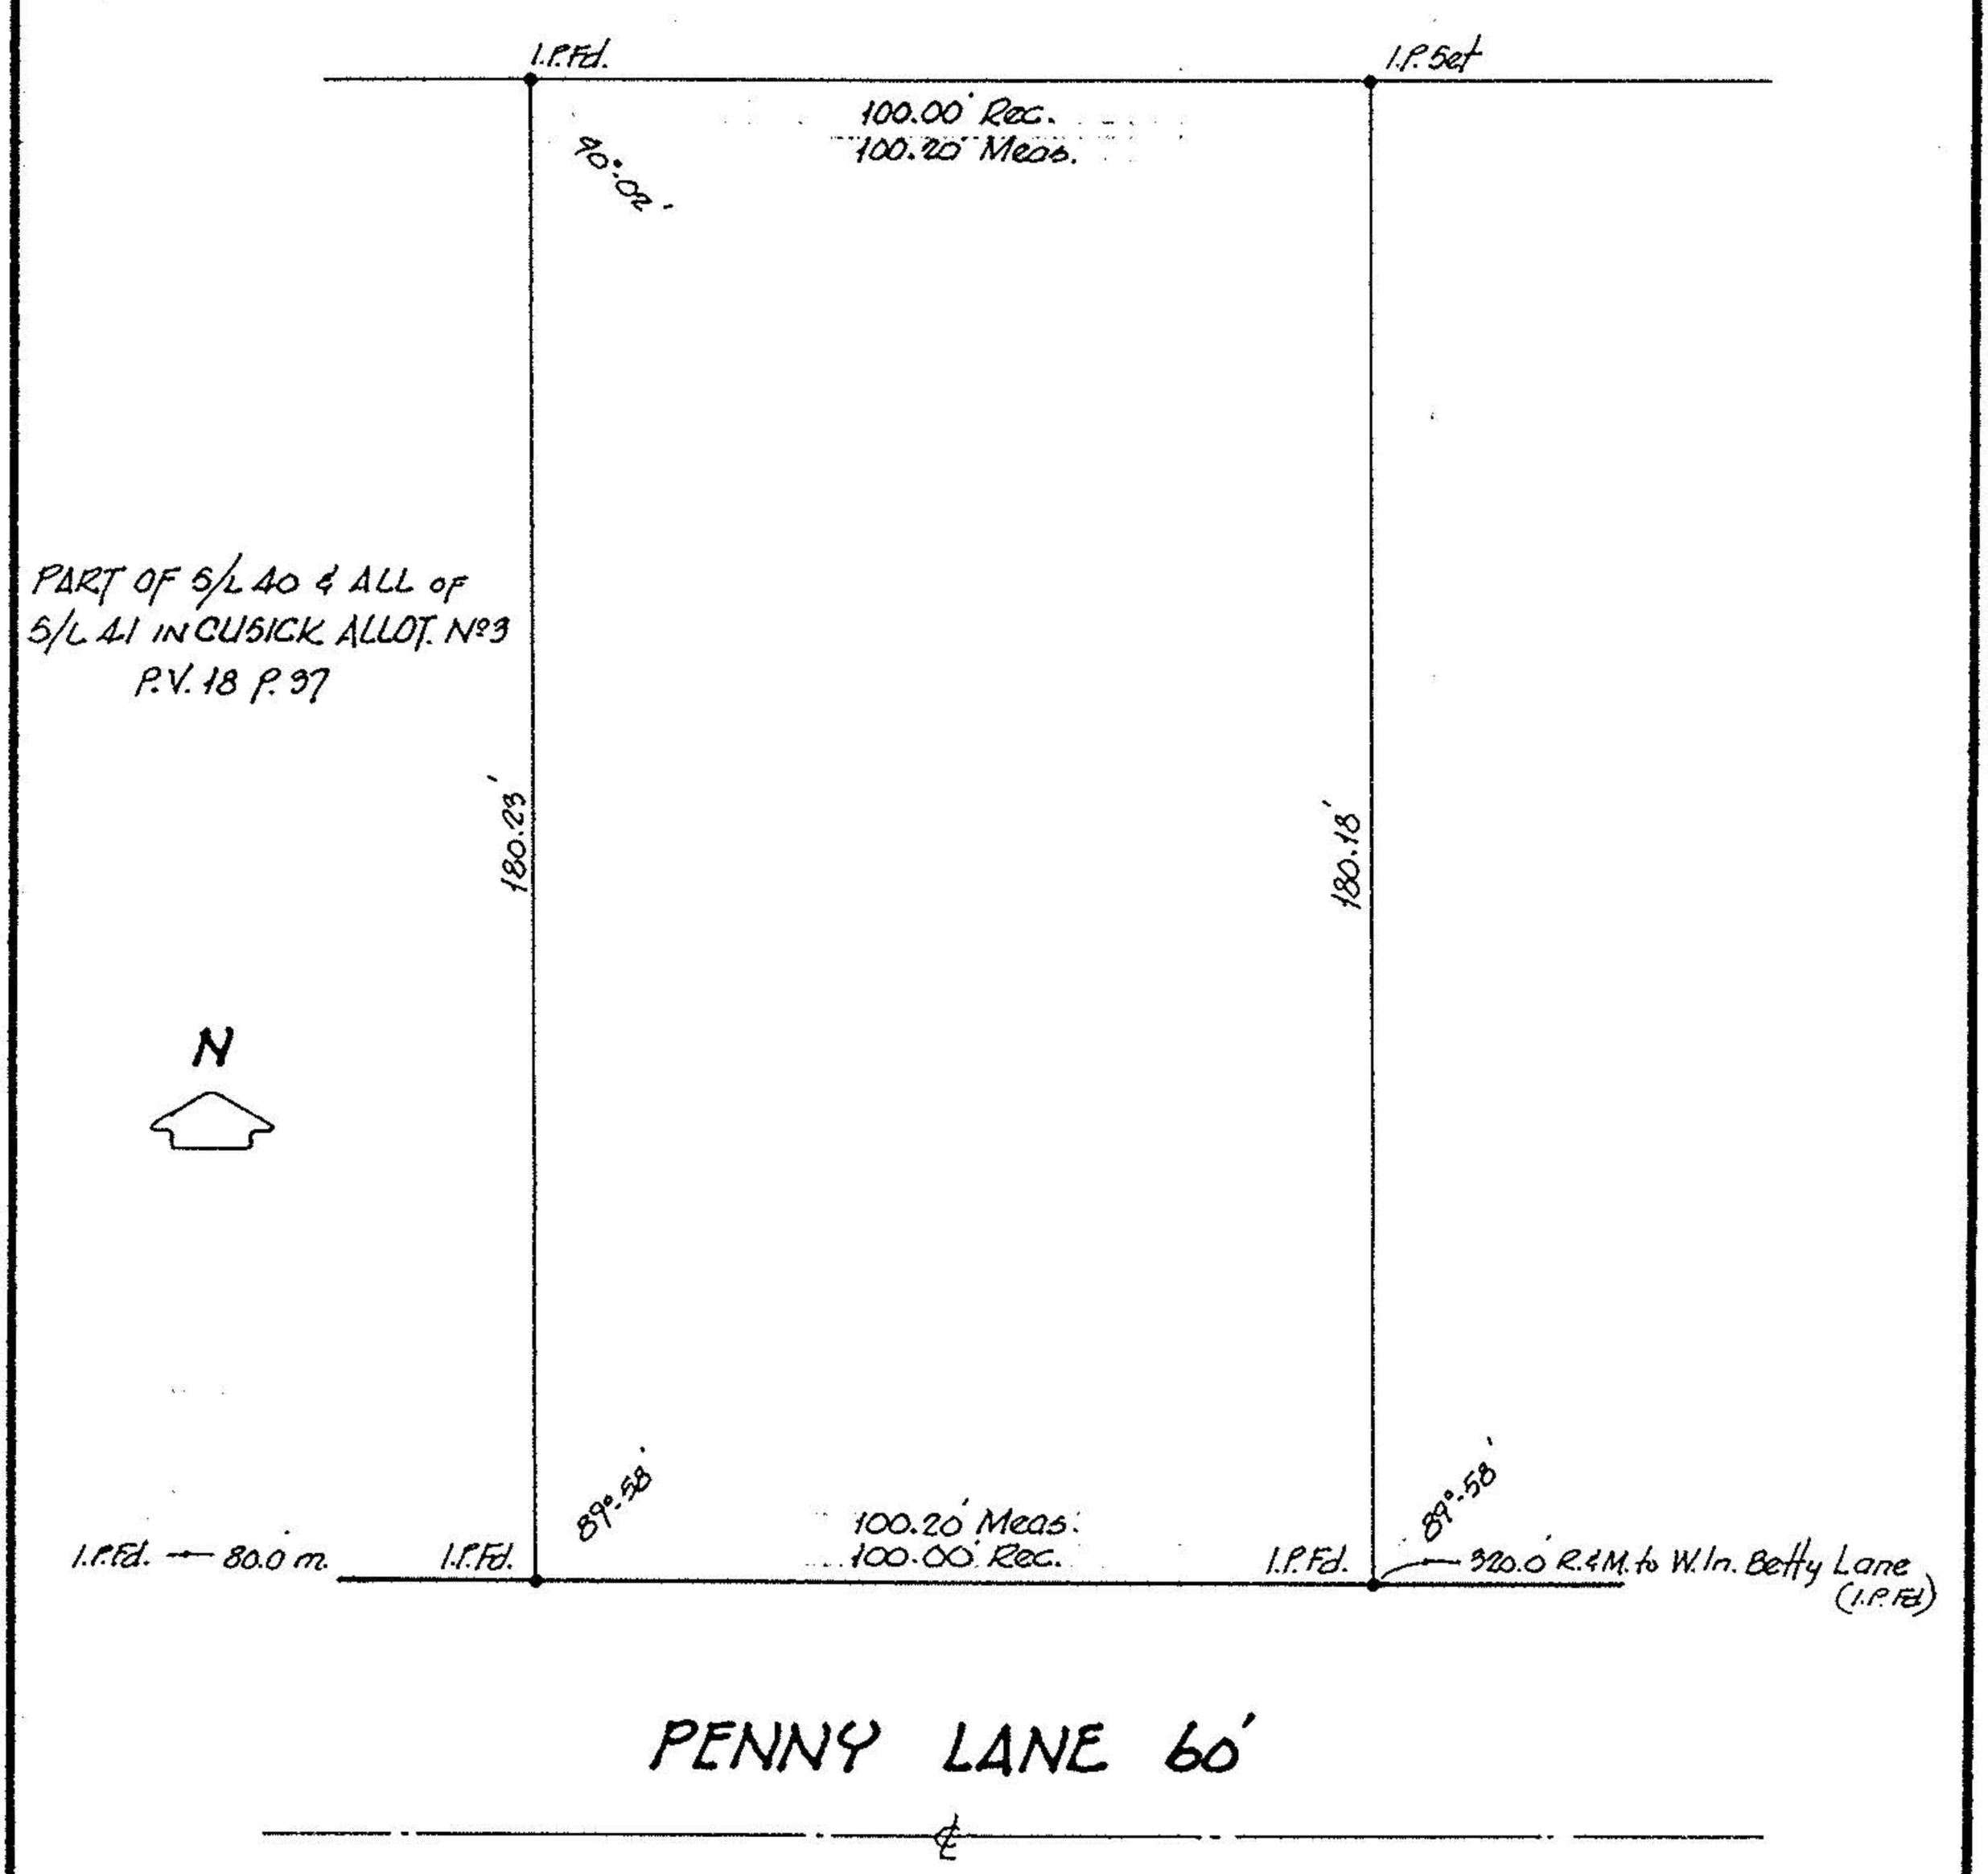
Orig. Lot	City of	Date SEPT. 9, 1986 Scale 1"=30'
Orig. Sec 4	Village of	Dwn. by R.G.S. Chkd. by C.J.
Tract	County of LORAIN	Job No. 86-1519 F.B.
Township of CARLISLE	State of OHIO	Printed