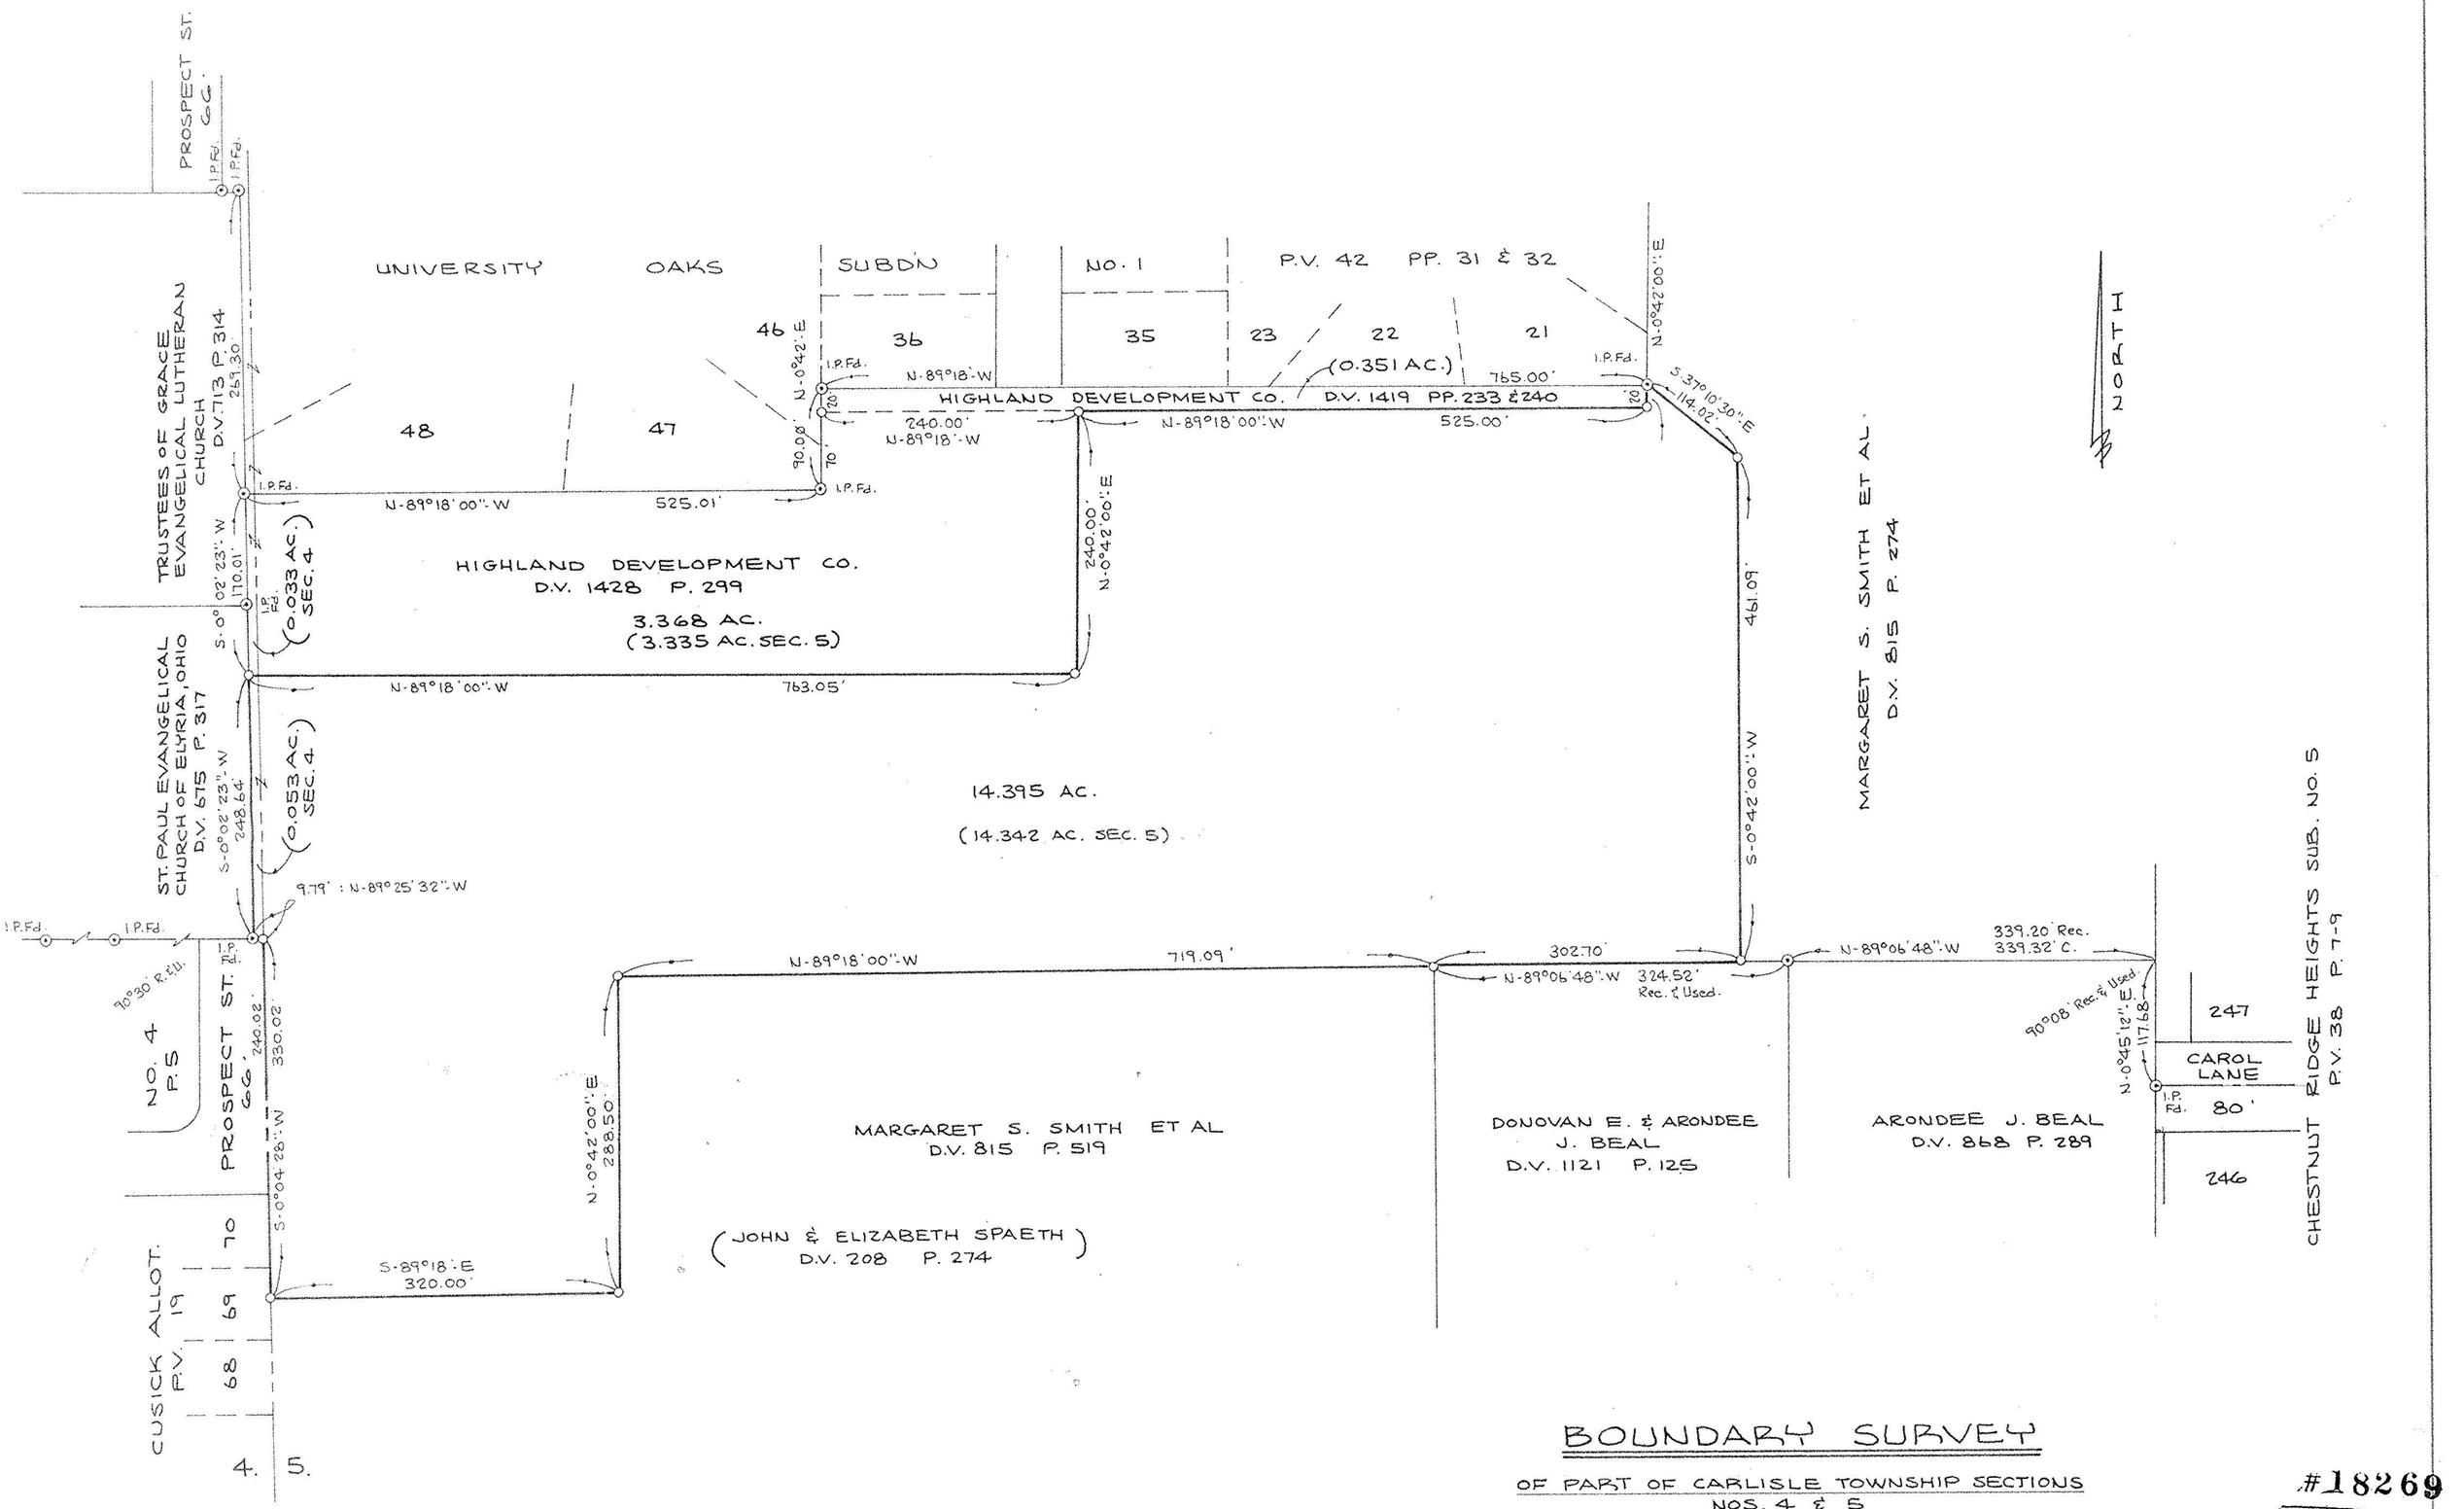

BOUNDARY SURVEY

OF PART OF CARLISLE TOWNSHIP SECTIONS NOS. 4 & 5

CITY OF ELYRIA COUNTY OF LORAIN

STATE OF OHIO

SCALE: 1" = 100' OCT. 9, 1988

PREPARED BY

K.S ASSOCIATES INC.

ENGINEERS SURVEYORS

David L. Elwell

REG. SURV. NO. 6333

STATE OF OHIO DAVID L. ELWELL 6333 REGISTERED SURVEYOR

#18269

APPROVED LORAIN CO. MAP DEPT.

DATE 12-27-88

PAGE 10-00-004-D

BY CF 5-A

VOID AFTER # 18269