SURVEY MAP
SPLIT & COMBINATION

PART OF ORIGINAL CARLISLE TOWNSHIP
SECTION No. 5
CITY OF ELYRIA COUNTY OF LORAIN
STATE OF OHIO

JANUARY 4, 1999

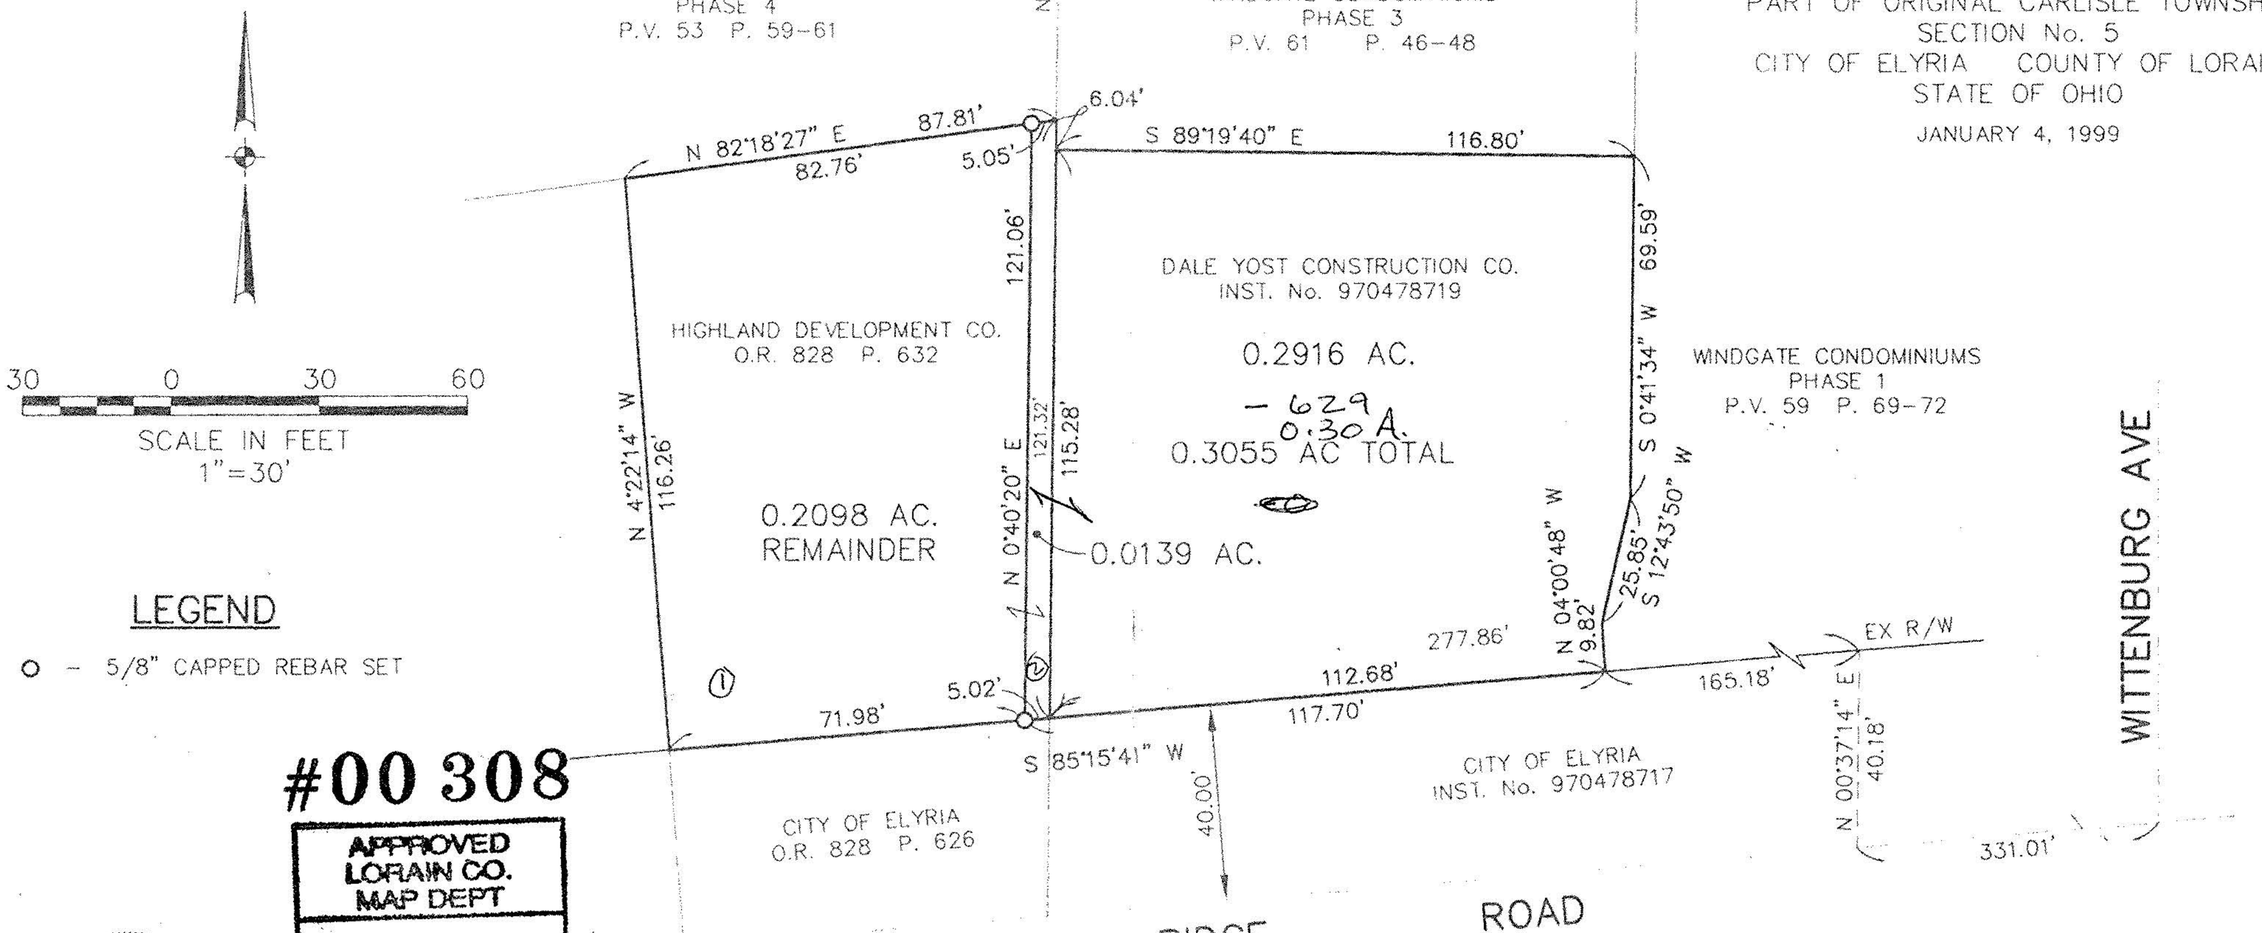

30 0 30 60

SCALE IN FEET
1"=30'

LEGEND

○ – 5/8" CAPPED REBAR SET

#00 308

APPROVED LORAIN CO. MAP DEPT
DATE 12-21-99
PAGE 10-00-005 A+B
BY [signature]
#00308

STATE OF OHIO
DAVID L. ELWELL
6333
REGISTERED SURVEYOR

David L. Elwell 1-11-99
DAVID L. ELWELL, REG. SURVEYOR No. 6333

#00004

APPROVED LORAIN CO. MAP DEPT.
DATE 2-11-99
PAGE 10-00-005-A+B
BY T. Gibb
JOB NUMBER 00004

KS ASSOCIATES, INC.
ENGINEERS/SURVEYORS
424 Middle Avenue
P.O. Box 89
Elyria, Ohio 44036
PHONE: (440) 322-6317 * FAX: (440) 284-0623