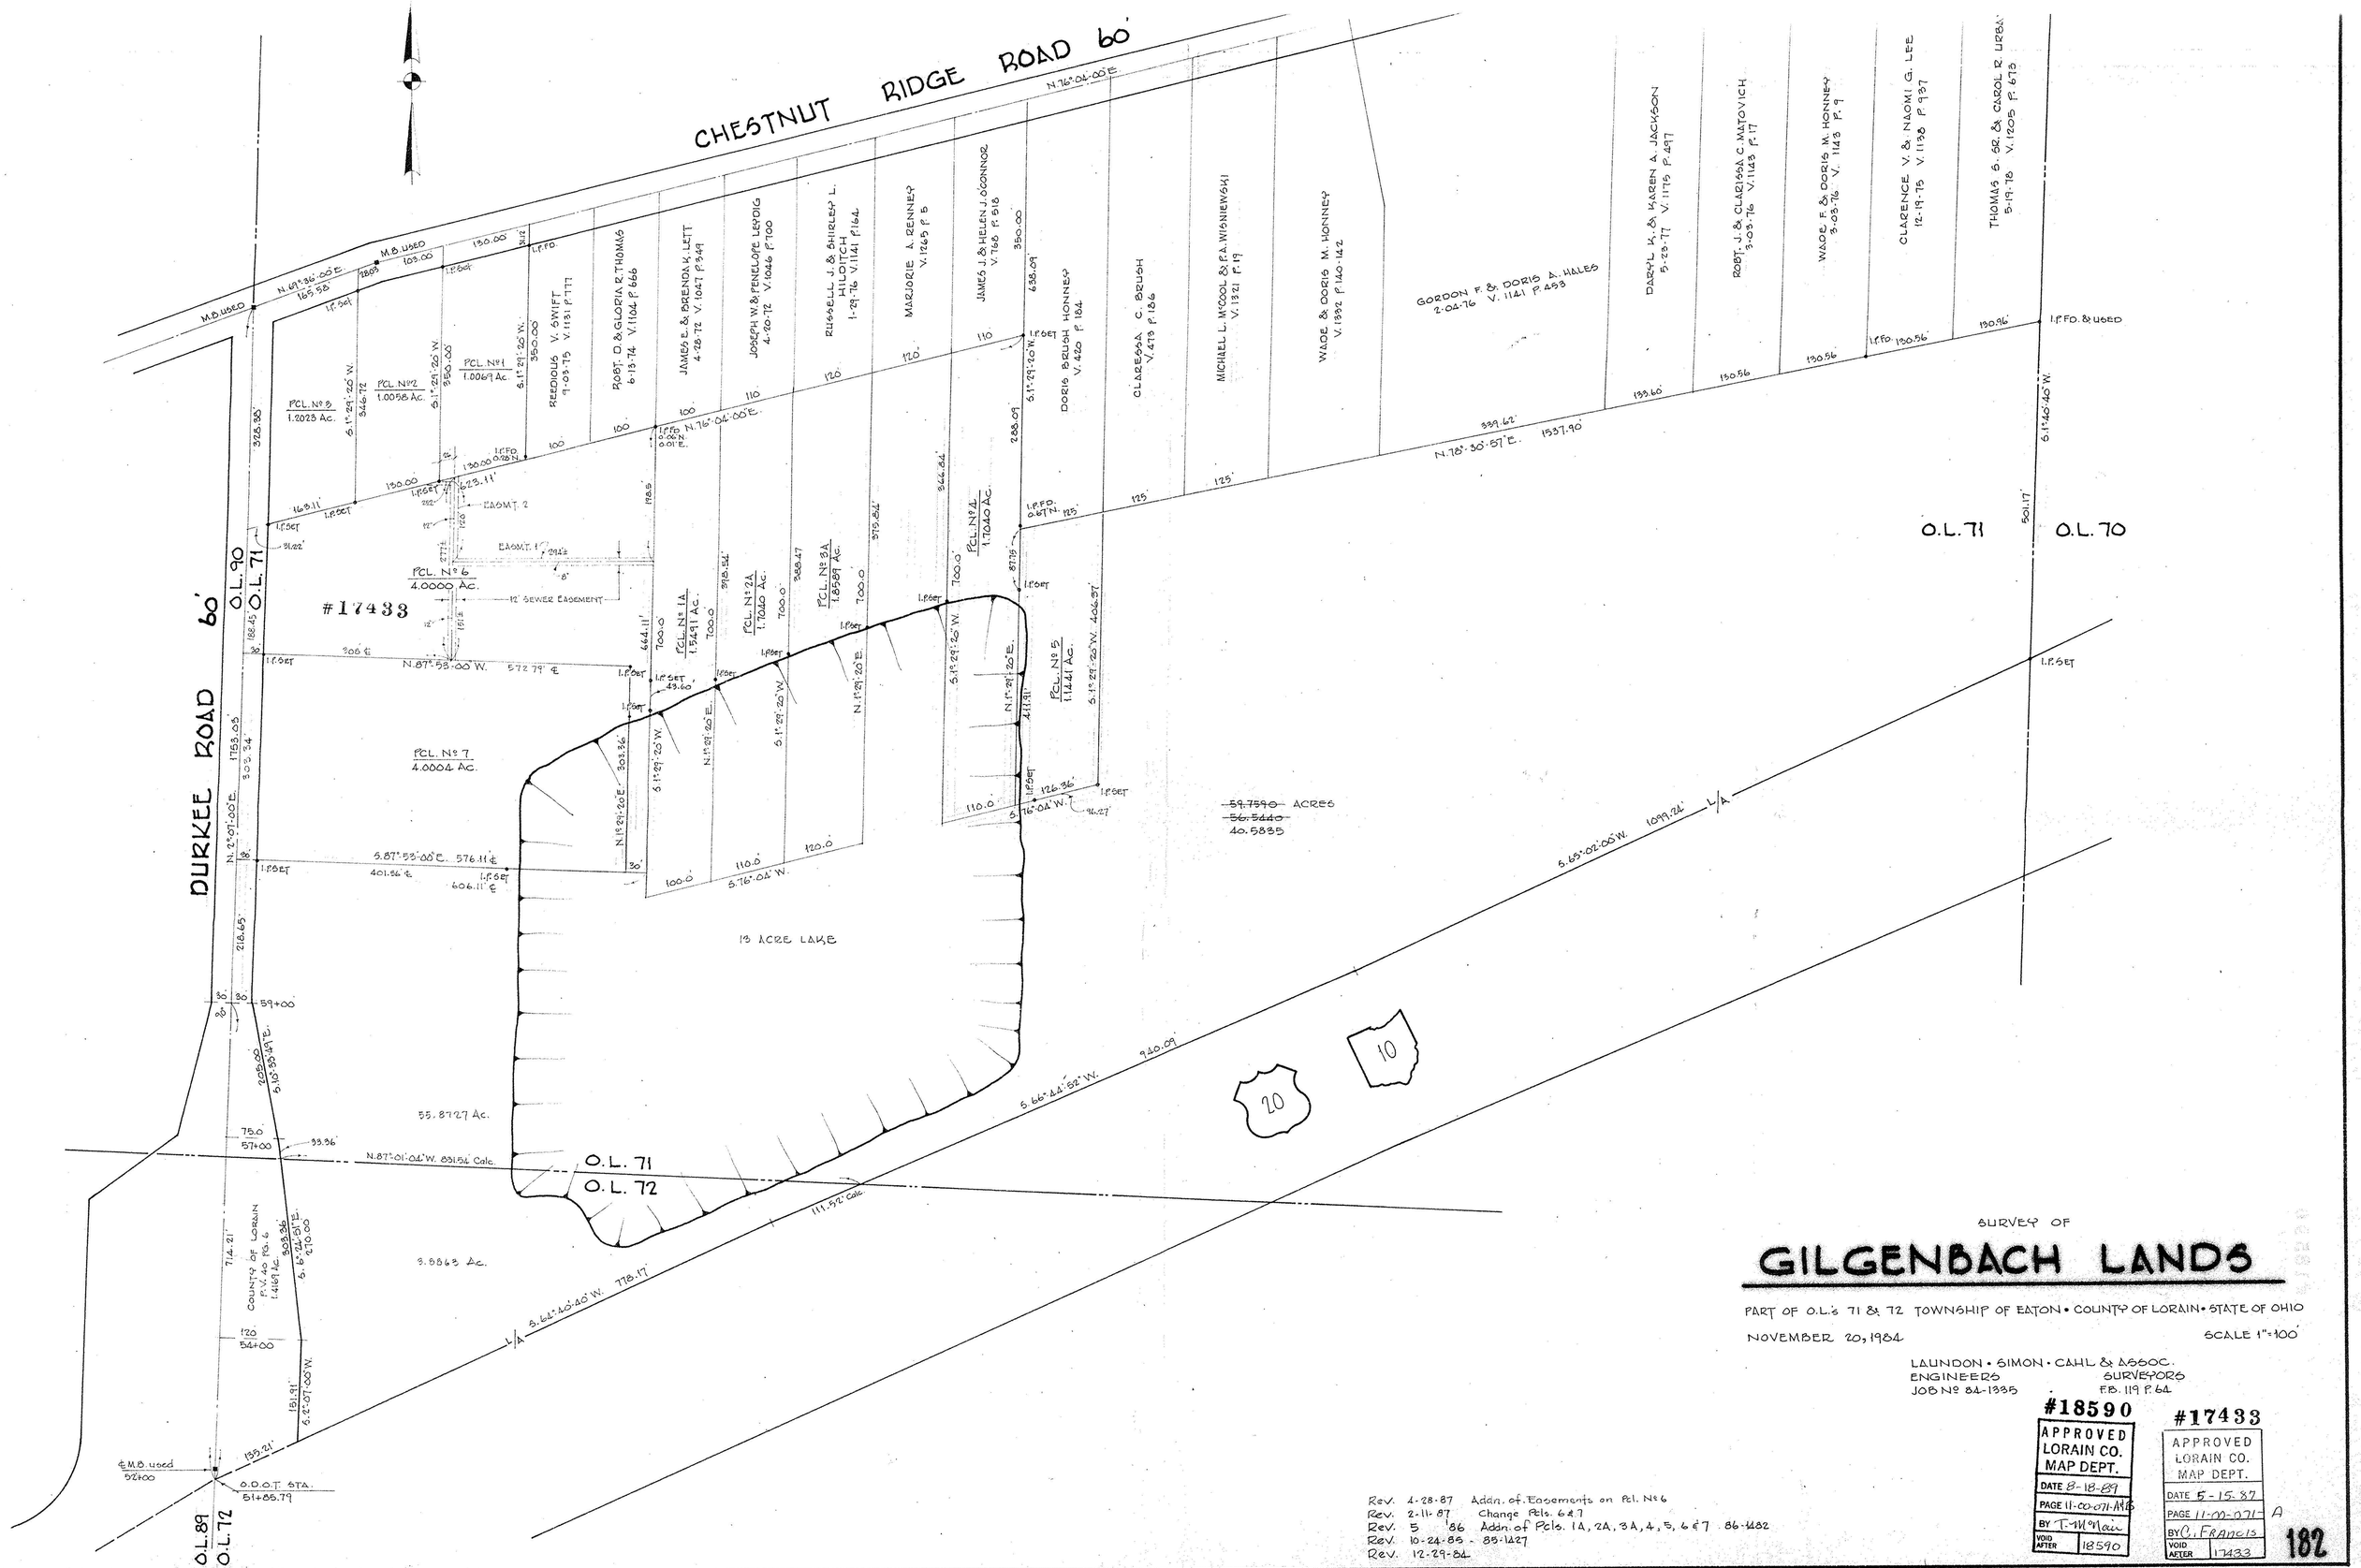

SURVEY OF

GILGENBACH LANDS

PART OF O.L.'S 71 & 72 TOWNSHIP OF EATON • COUNTY OF LORAIN • STATE OF OHIO

NOVEMBER 20, 1984 SCALE 1"=100'

LAUNDON • SIMON • CAHL & ASSOC.
ENGINEERS SURVEYORS
JOB Nº 84-1335 F.B. 119 P. 64

#18590
APPROVED LORAIN CO. MAP DEPT.
DATE 8-18-89
PAGE 11-00-071-A
BY T. McNeil
VOID AFTER 18590

#17433
APPROVED LORAIN CO. MAP DEPT.
DATE 5-15-87
PAGE 11-00-071-A
BY C. FRANCIS
VOID AFTER 17433

Rev. 4-28-87 Addn. of Easements on Pcl. Nº 6
Rev. 2-11-87 Change Pcls. 6 & 7
Rev. 5-'86 Addn. of Pcls. 1A, 2A, 3A, 4, 5, 6 & 7 86-1182
Rev. 10-24-85 - 85-1227
Rev. 12-29-84

182