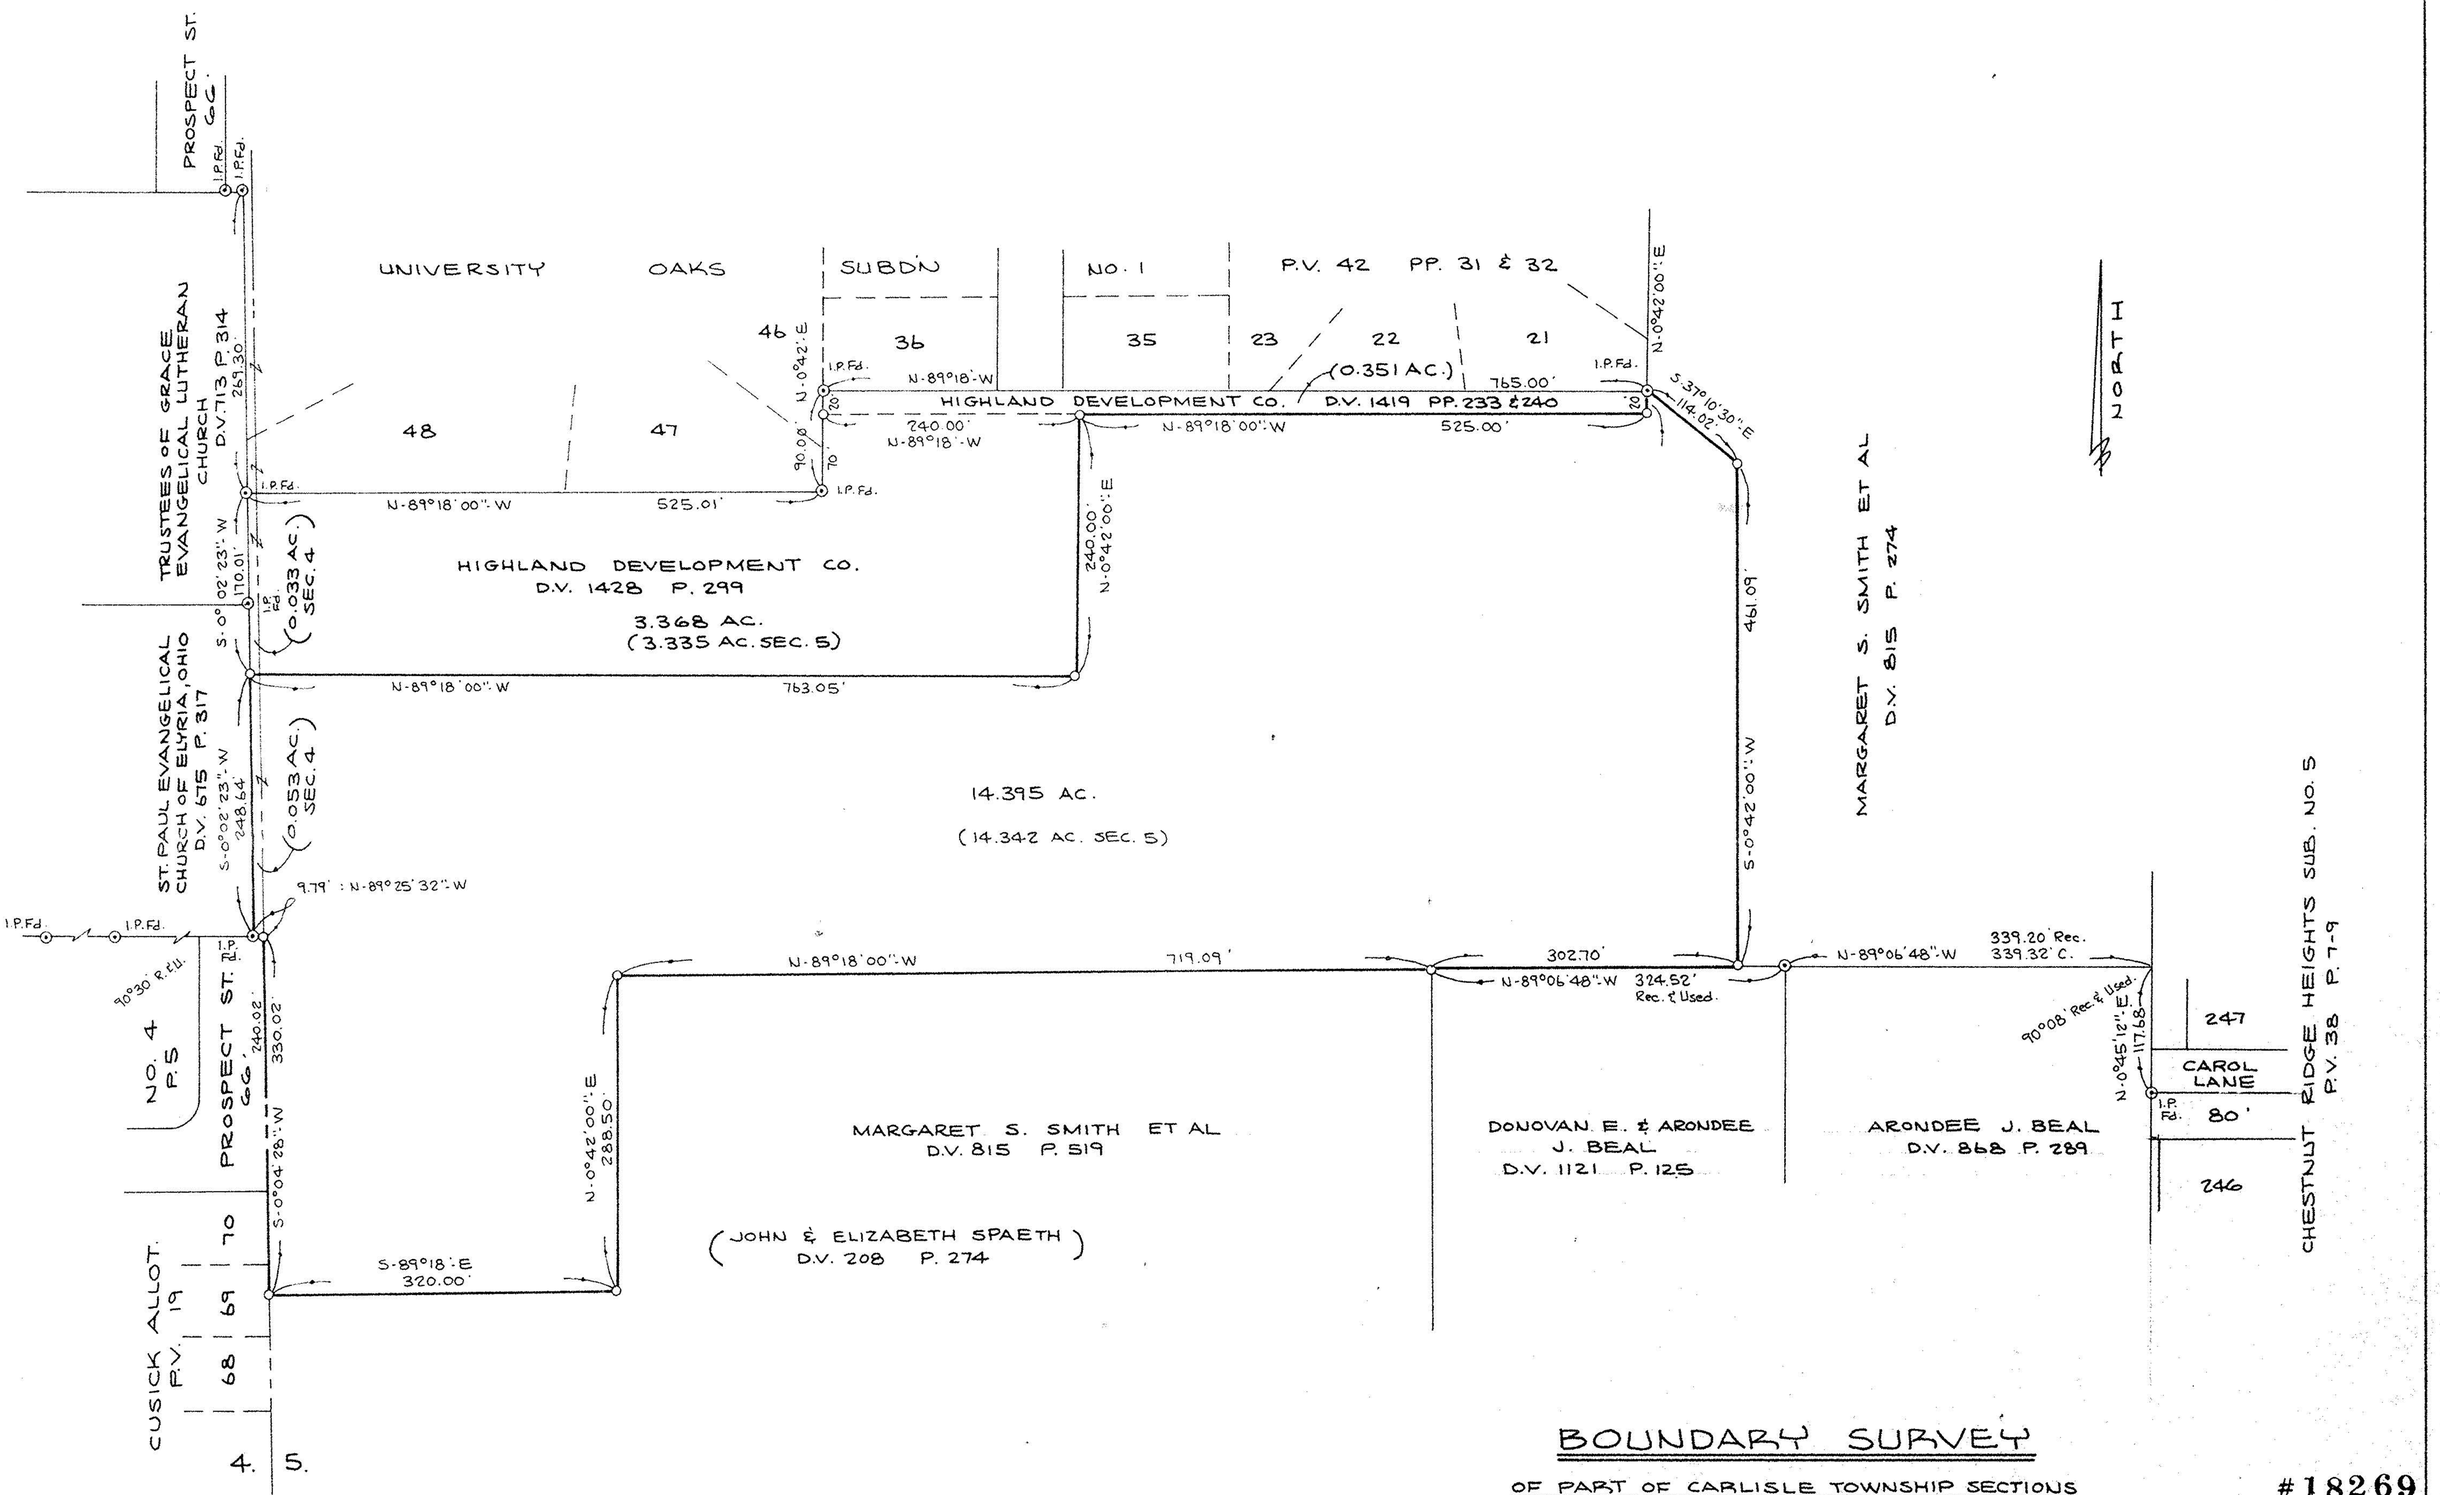

BOUNDARY SURVEY

OF PART OF CARLISLE TOWNSHIP SECTIONS NOS. 4 & 5

CITY OF ELYRIA COUNTY OF LORAIN

STATE OF OHIO

SCALE: 1" = 100' OCT. 9, 1988

PREPARED BY

K.S ASSOCIATES INC.

ENGINEERS SURVEYORS

David L. Elwell

REG. SURV. NO. 6333

STATE OF OHIO
DAVID L. ELWELL
6333
REGISTERED SURVEYOR

#18269

APPROVED
LORAIN CO.
MAP DEPT.
DATE 12-27-88
PAGE 10-00-004-D
BY LR 5-A
VOID AFTER 4 18269