

# PLAS SUBDIVISION

PART OF SECTION 4, CARLISLE TOWNSHIP  
LORAIN COUNTY, OHIO  
SCALE 1" = 40' OCTOBER 1956

PLAS DRIVE  
Ded. Not excepted  
As of 2/13/86

ENG. Department  
Does not maintain Dr.

### SURVEYORS CERTIFICATE:

THIS IS TO CERTIFY THAT AT THE REQUEST OF THE OWNERS I HAVE SURVEYED AND PLATTED PLAS SUBDIVISION AS SHOWN HEREON. DISTANCES ARE SHOWN IN FEET AND DECIMAL PARTS THEREOF. IRON PIN MONUMENTS WERE FOUND OR SET AS SHOWN. THIS PLAT EMBRACES 3.591 ACRES OF LAND IN SECTION 4 CARLISLE TOWNSHIP INCLUSIVE OF THE LAND TO THE CENTERLINE OF ELYRIA-GRAFTON ROAD BEARINGS USED ARE TO DENOTE ANGLES ONLY. ALL OF WHICH I CERTIFY TO BE CORRECT.


ARNOLD F. KOEPP  
REGISTERED SURVEYOR

SEAL  
SURVEYOR

THIS IS TO CERTIFY THAT THE UNDERSIGNED RALPH J. PLAS AND K.A. PLAS, HUSBAND AND WIFE, BERNARD I. PLAS AND MARION C. PLAS, HUSBAND AND WIFE, OWNERS OF THE LANDS EMBRACED BY THIS PLAT OF PLAS SUBDIVISION, DO HEREBY ACCEPT THE SAME TO BE CORRECT AND DEDICATE TO PUBLIC USE PLAS DRIVE AS SHOWN HEREON.

RALPH J. PLAS  
K.A. PLAS

MARION C. PLAS  
BERNARD I. PLAS

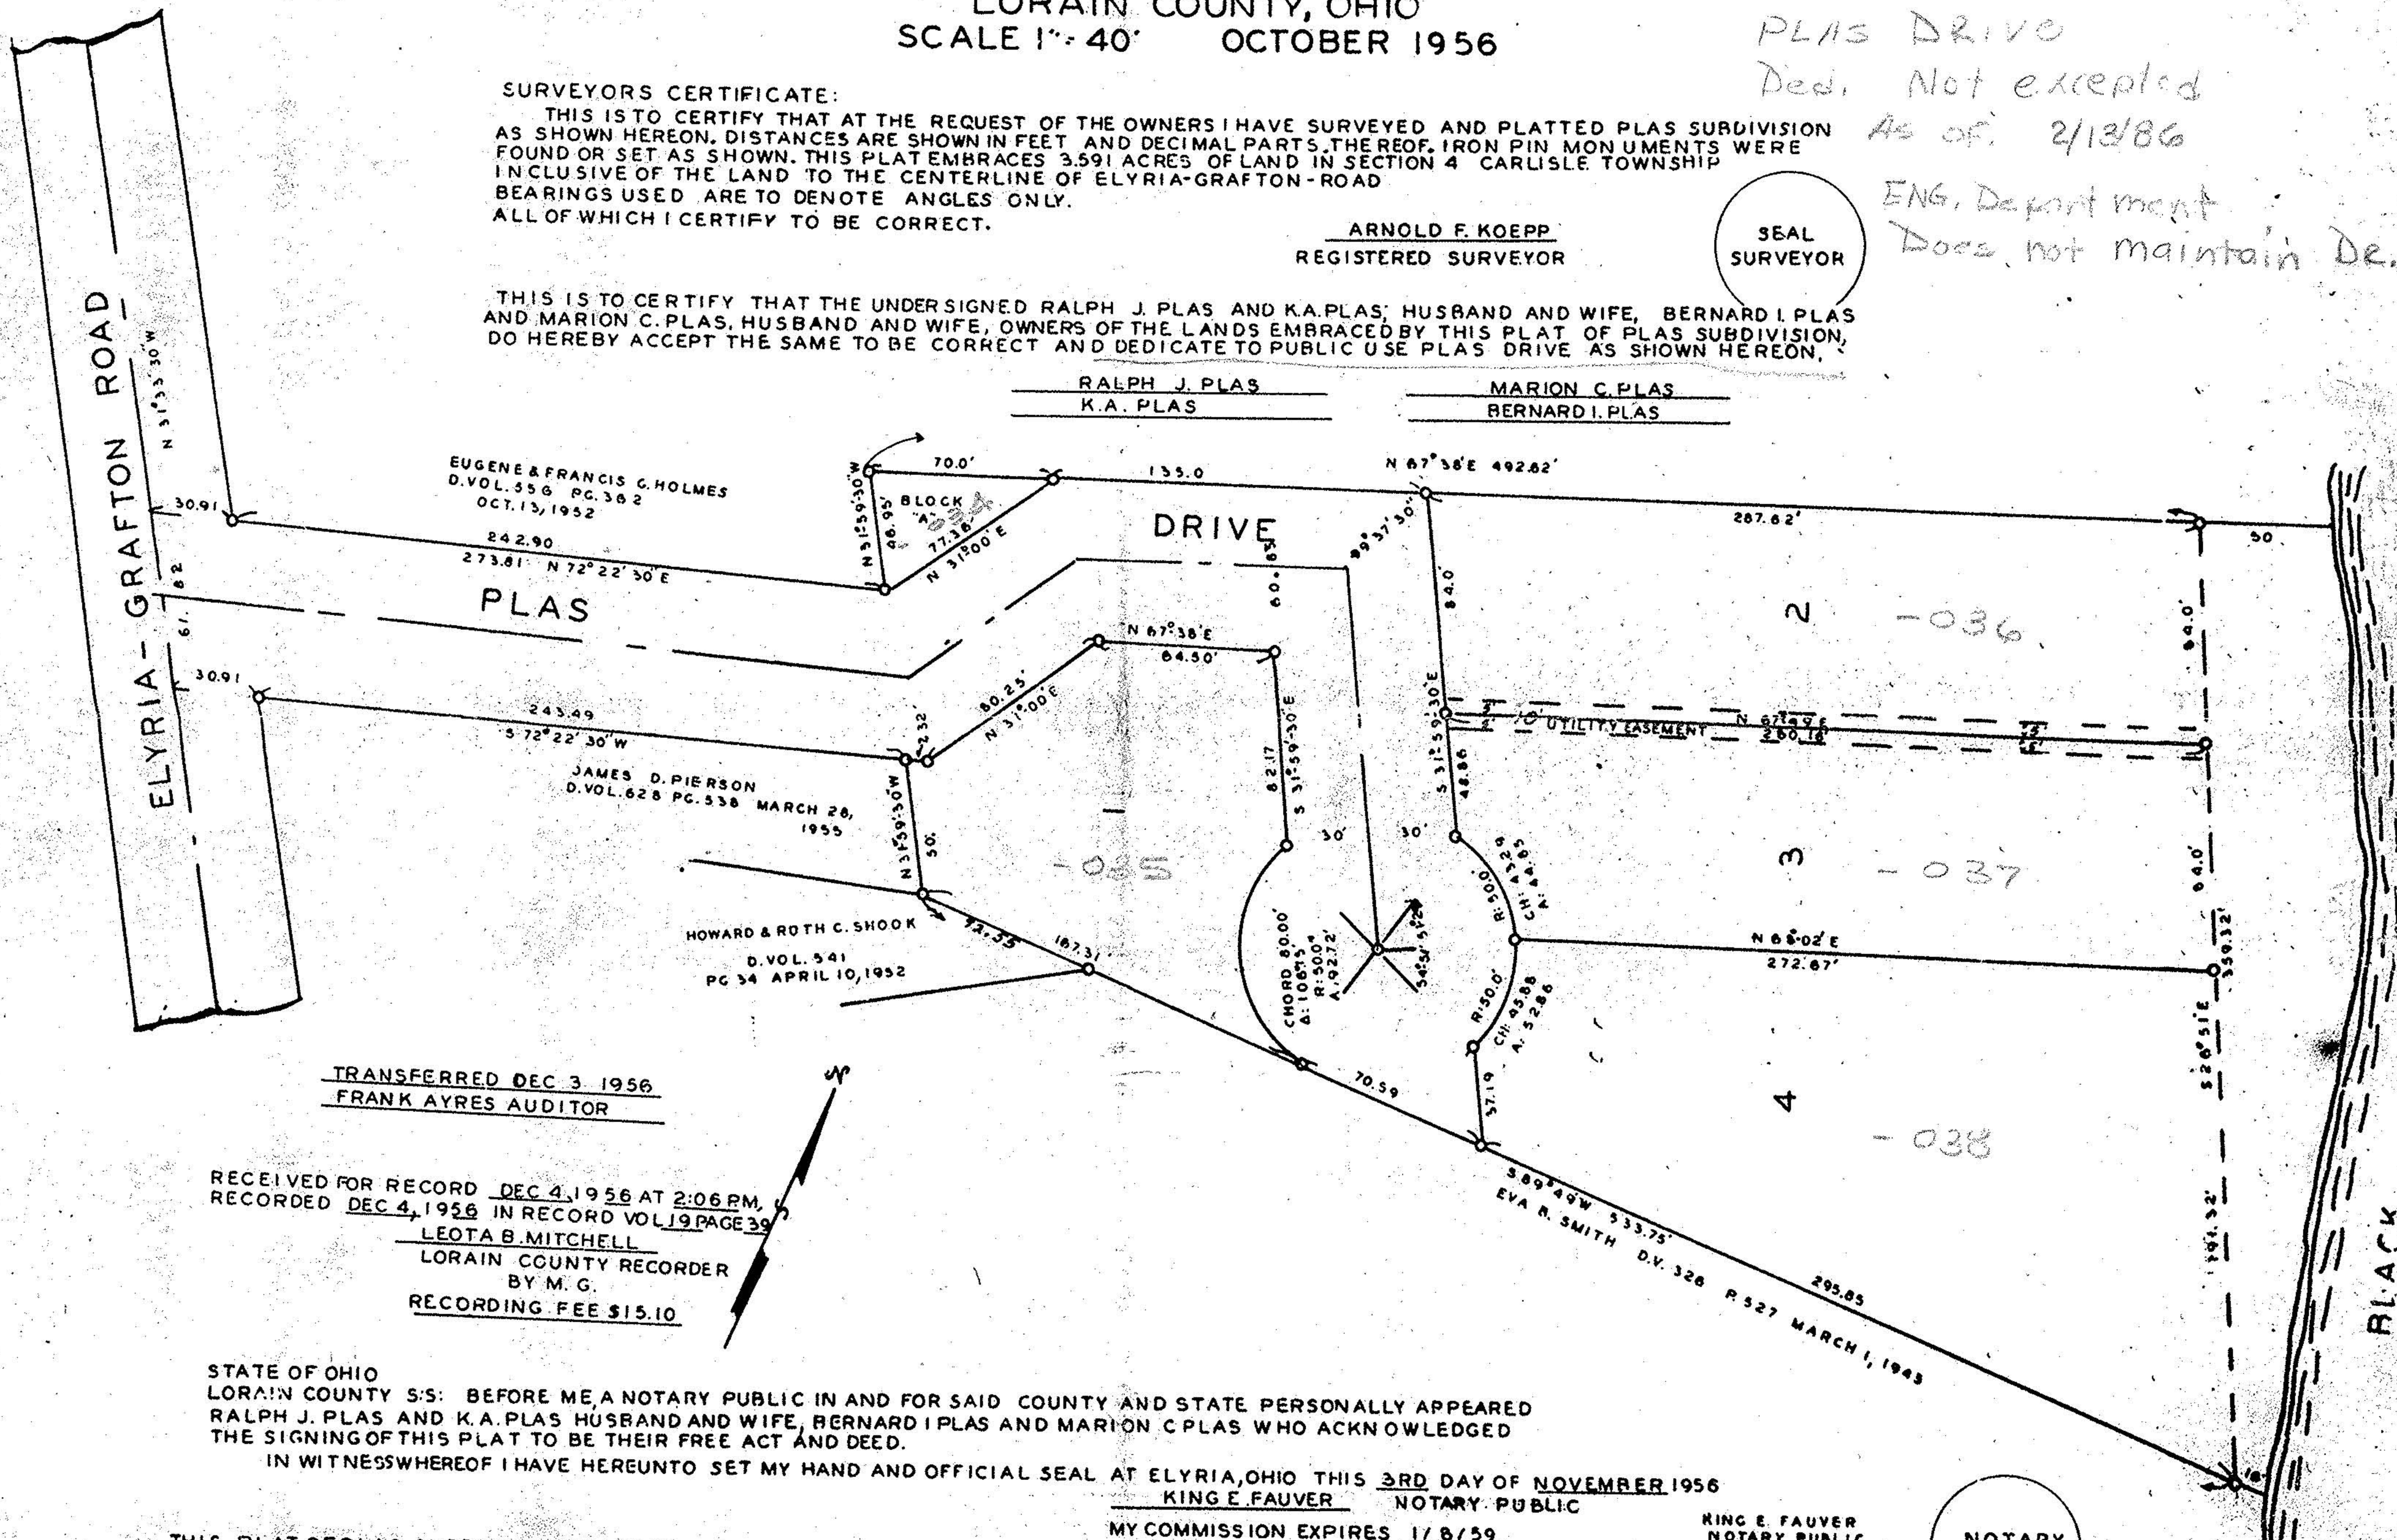

TRANSFERRED DEC 3 1956  
FRANK AYRES AUDITOR

RECEIVED FOR RECORD DEC 4, 1956 AT 2:06 PM,  
RECORDED DEC 4, 1956 IN RECORD VOL. 19 PAGE 39  
LEOTA B. MITCHELL  
LORAIN COUNTY RECORDER  
BY M. G.  
RECORDING FEE \$15.10

STATE OF OHIO  
LORAIN COUNTY S/S: BEFORE ME, A NOTARY PUBLIC IN AND FOR SAID COUNTY AND STATE PERSONALLY APPEARED RALPH J. PLAS AND K.A. PLAS HUSBAND AND WIFE, BERNARD I. PLAS AND MARION C. PLAS WHO ACKNOWLEDGED THE SIGNING OF THIS PLAT TO BE THEIR FREE ACT AND DEED.

IN WITNESS WHEREOF I HAVE HEREUNTO SET MY HAND AND OFFICIAL SEAL AT ELYRIA, OHIO THIS 3RD DAY OF NOVEMBER 1956

KING E. FAUVER NOTARY PUBLIC

KING E. FAUVER  
NOTARY PUBLIC

NOTARY  
SEAL

THIS PLAT OF PLAS SUBDIVISION IS HEREBY APPROVED BY THE BOARD OF TRUSTEES OF CARLISLE TOWNSHIP ON THIS 5TH DAY OF NOVEMBER 1956

CARL MCMULLEN  
LAURENCE A. JACKSON

GEORGE ROBSON CLERK

THIS PLAT OF PLAS SUBDIVISION IS HEREBY APPROVED BY THE ZONING BOARD OF CARLISLE TOWNSHIP ON THIS 5TH DAY OF NOVEMBER 1956

H.E. KALTER R.W. SAENS  
CLARENCE HOLTON KARL SIMMS

THIS PLAT OF PLAS SUBDIVISION IS HEREBY APPROVED BY THE PLANNING COMMISSION OF THE CITY OF ELYRIA, OHIO ON THIS 28 DAY OF NOV 1956

J.G. KEYS PRESIDENT  
J.J. SERES SECRETARY