10-00-004-G

KLEINOEDER · SCHMIDT
and ASSOCIATES

ENGINEERS — SURVEYORS — CONSULTANTS in LAND PLANNING

ELYRIA · NORWALK · MEDINA OHIO

SURVEY

Sublot(s) _____

Subd'n _____

Township CARLISLE Tract _____

Orig. Lot(s) _____ Sec. 4

County of LORAIN State of Ohio

Corporation _____

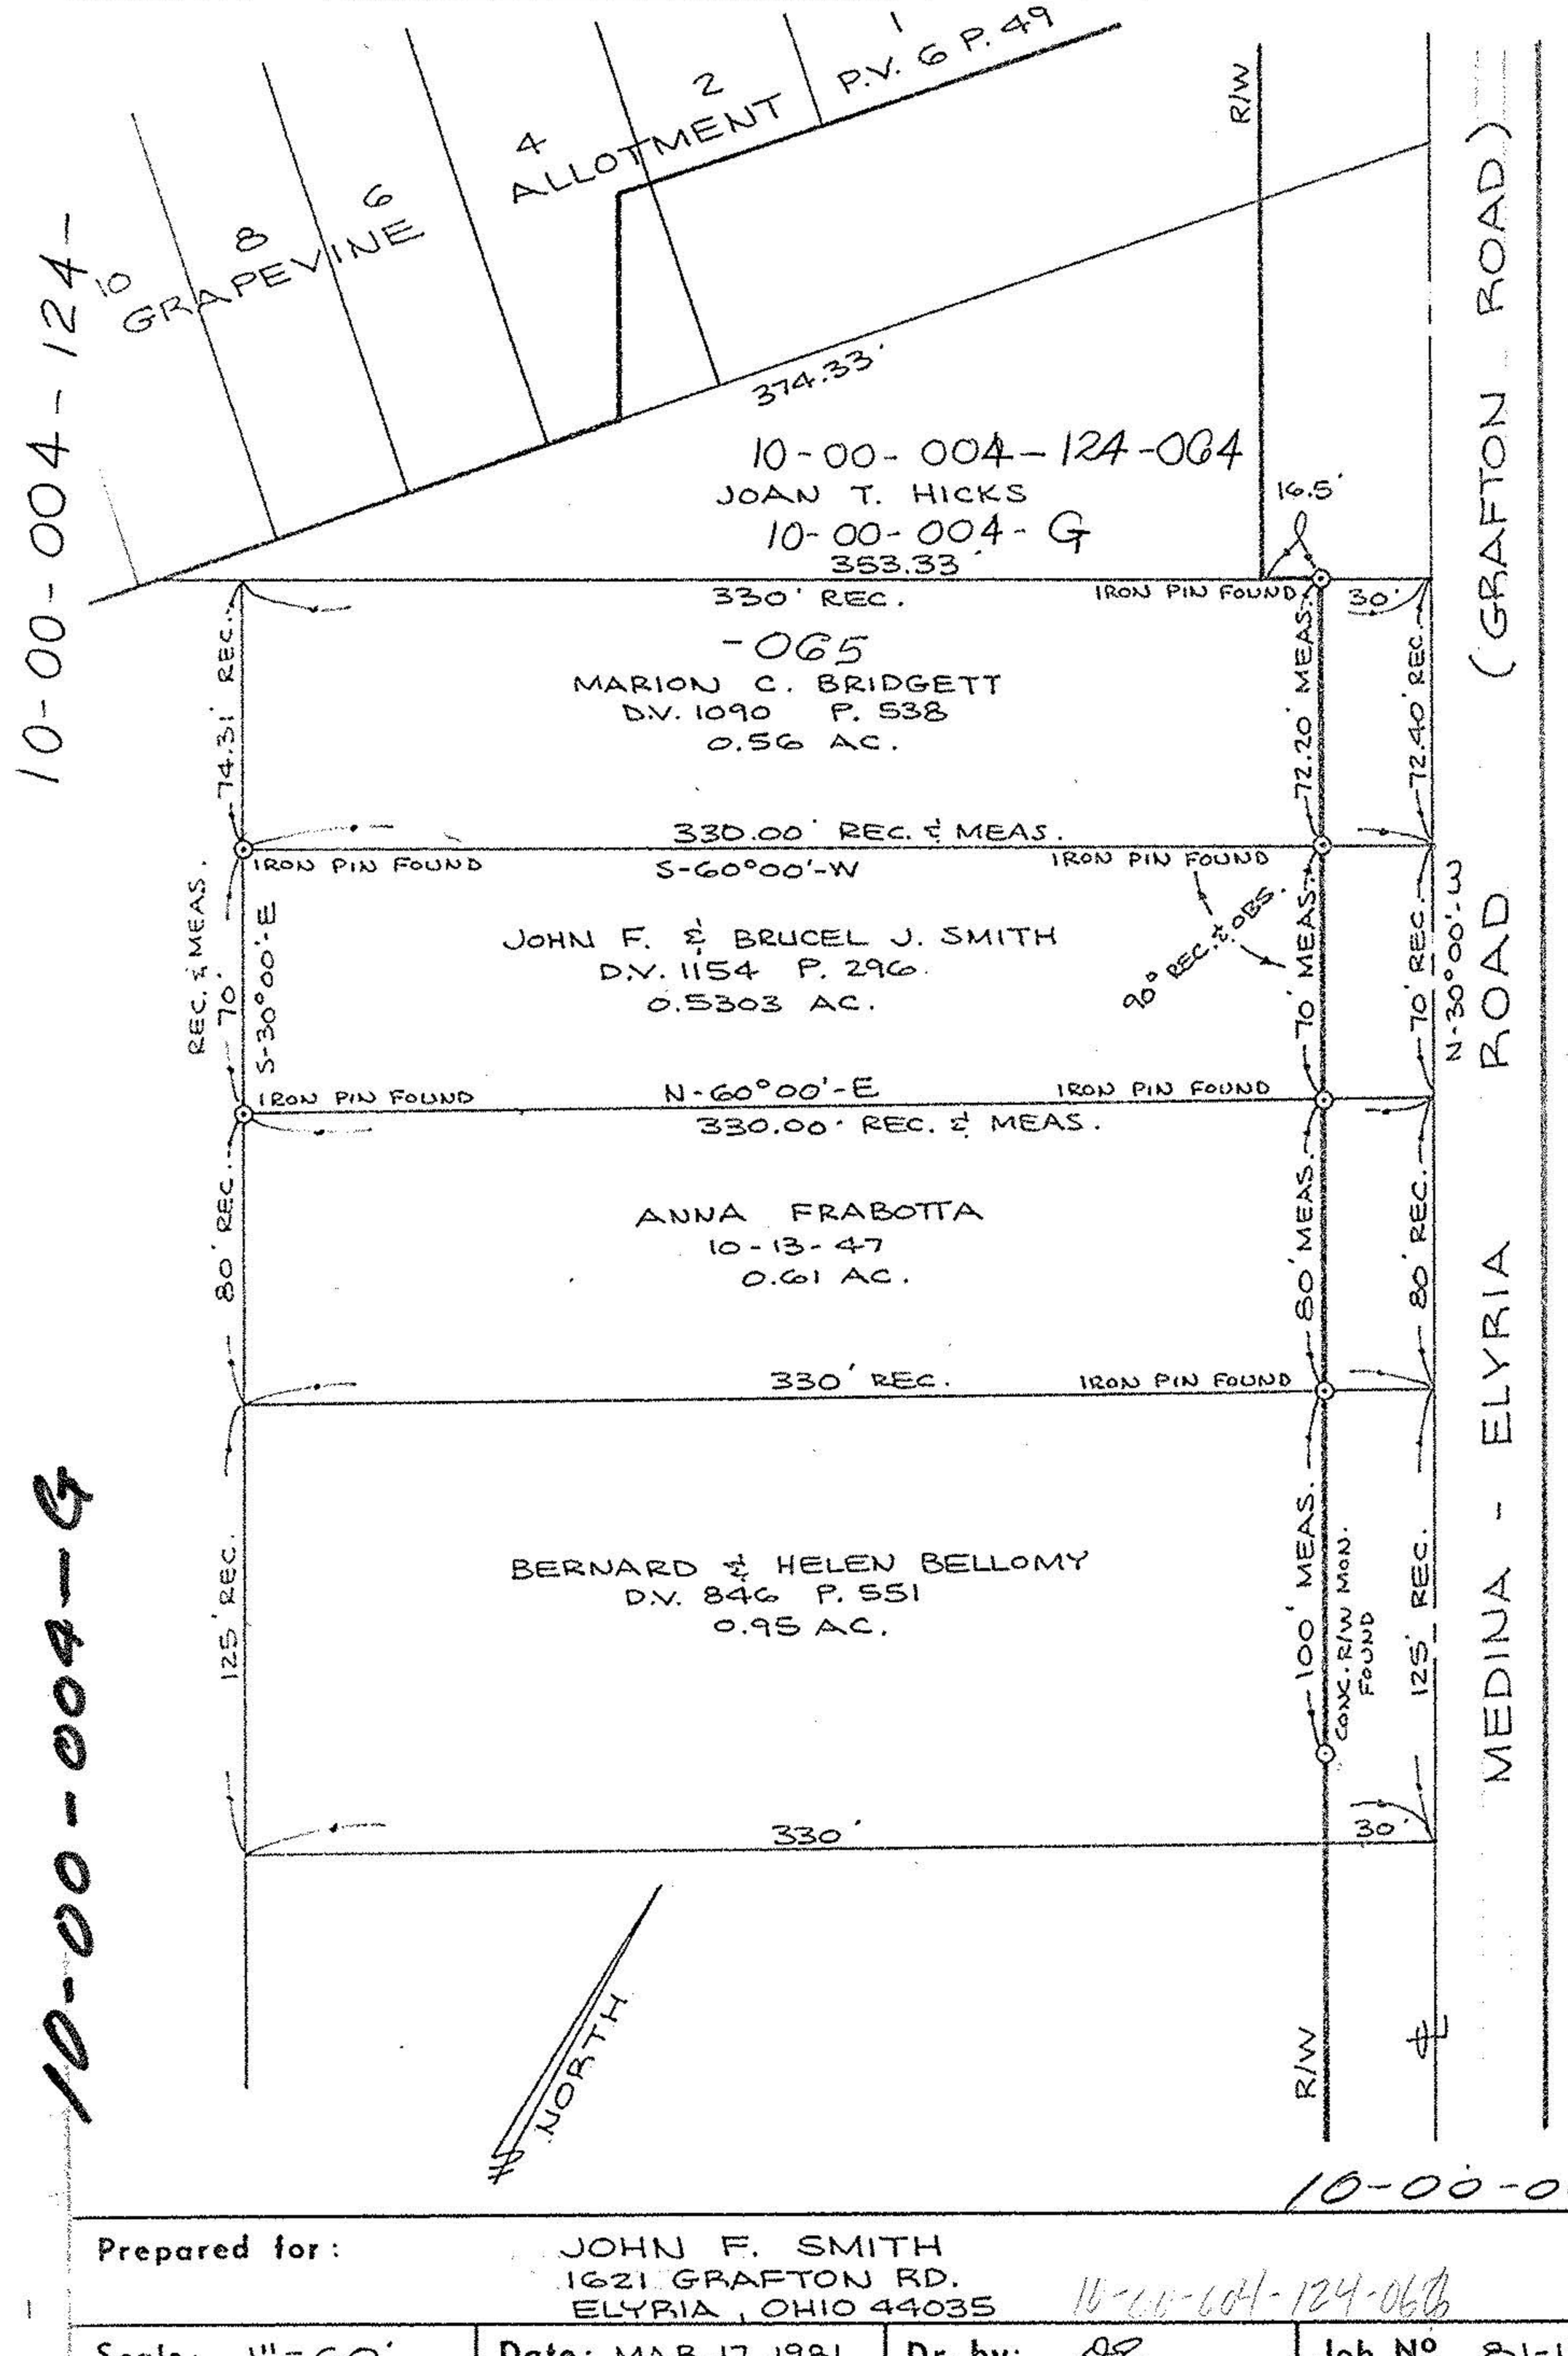

10-00-004-G

Prepared for: JOHN F. SMITH
1621 GRAFTON RD.
ELYRIA, OHIO 44035

10-00-004-124-064

Scale: 1" = 60'	Date: MAR. 17, 1981	Dr. by: DE	Job No 81-13

10-00-004-G