LAUNDON . SIMON . CAHL & ASSOC. INC.
CONSULTING ENGINEERS & SURVEYORS
219 COURT ST. ELYRIA, OHIO 44035

SURVEY FOR:
ELIZABETH J. LAWRENCE
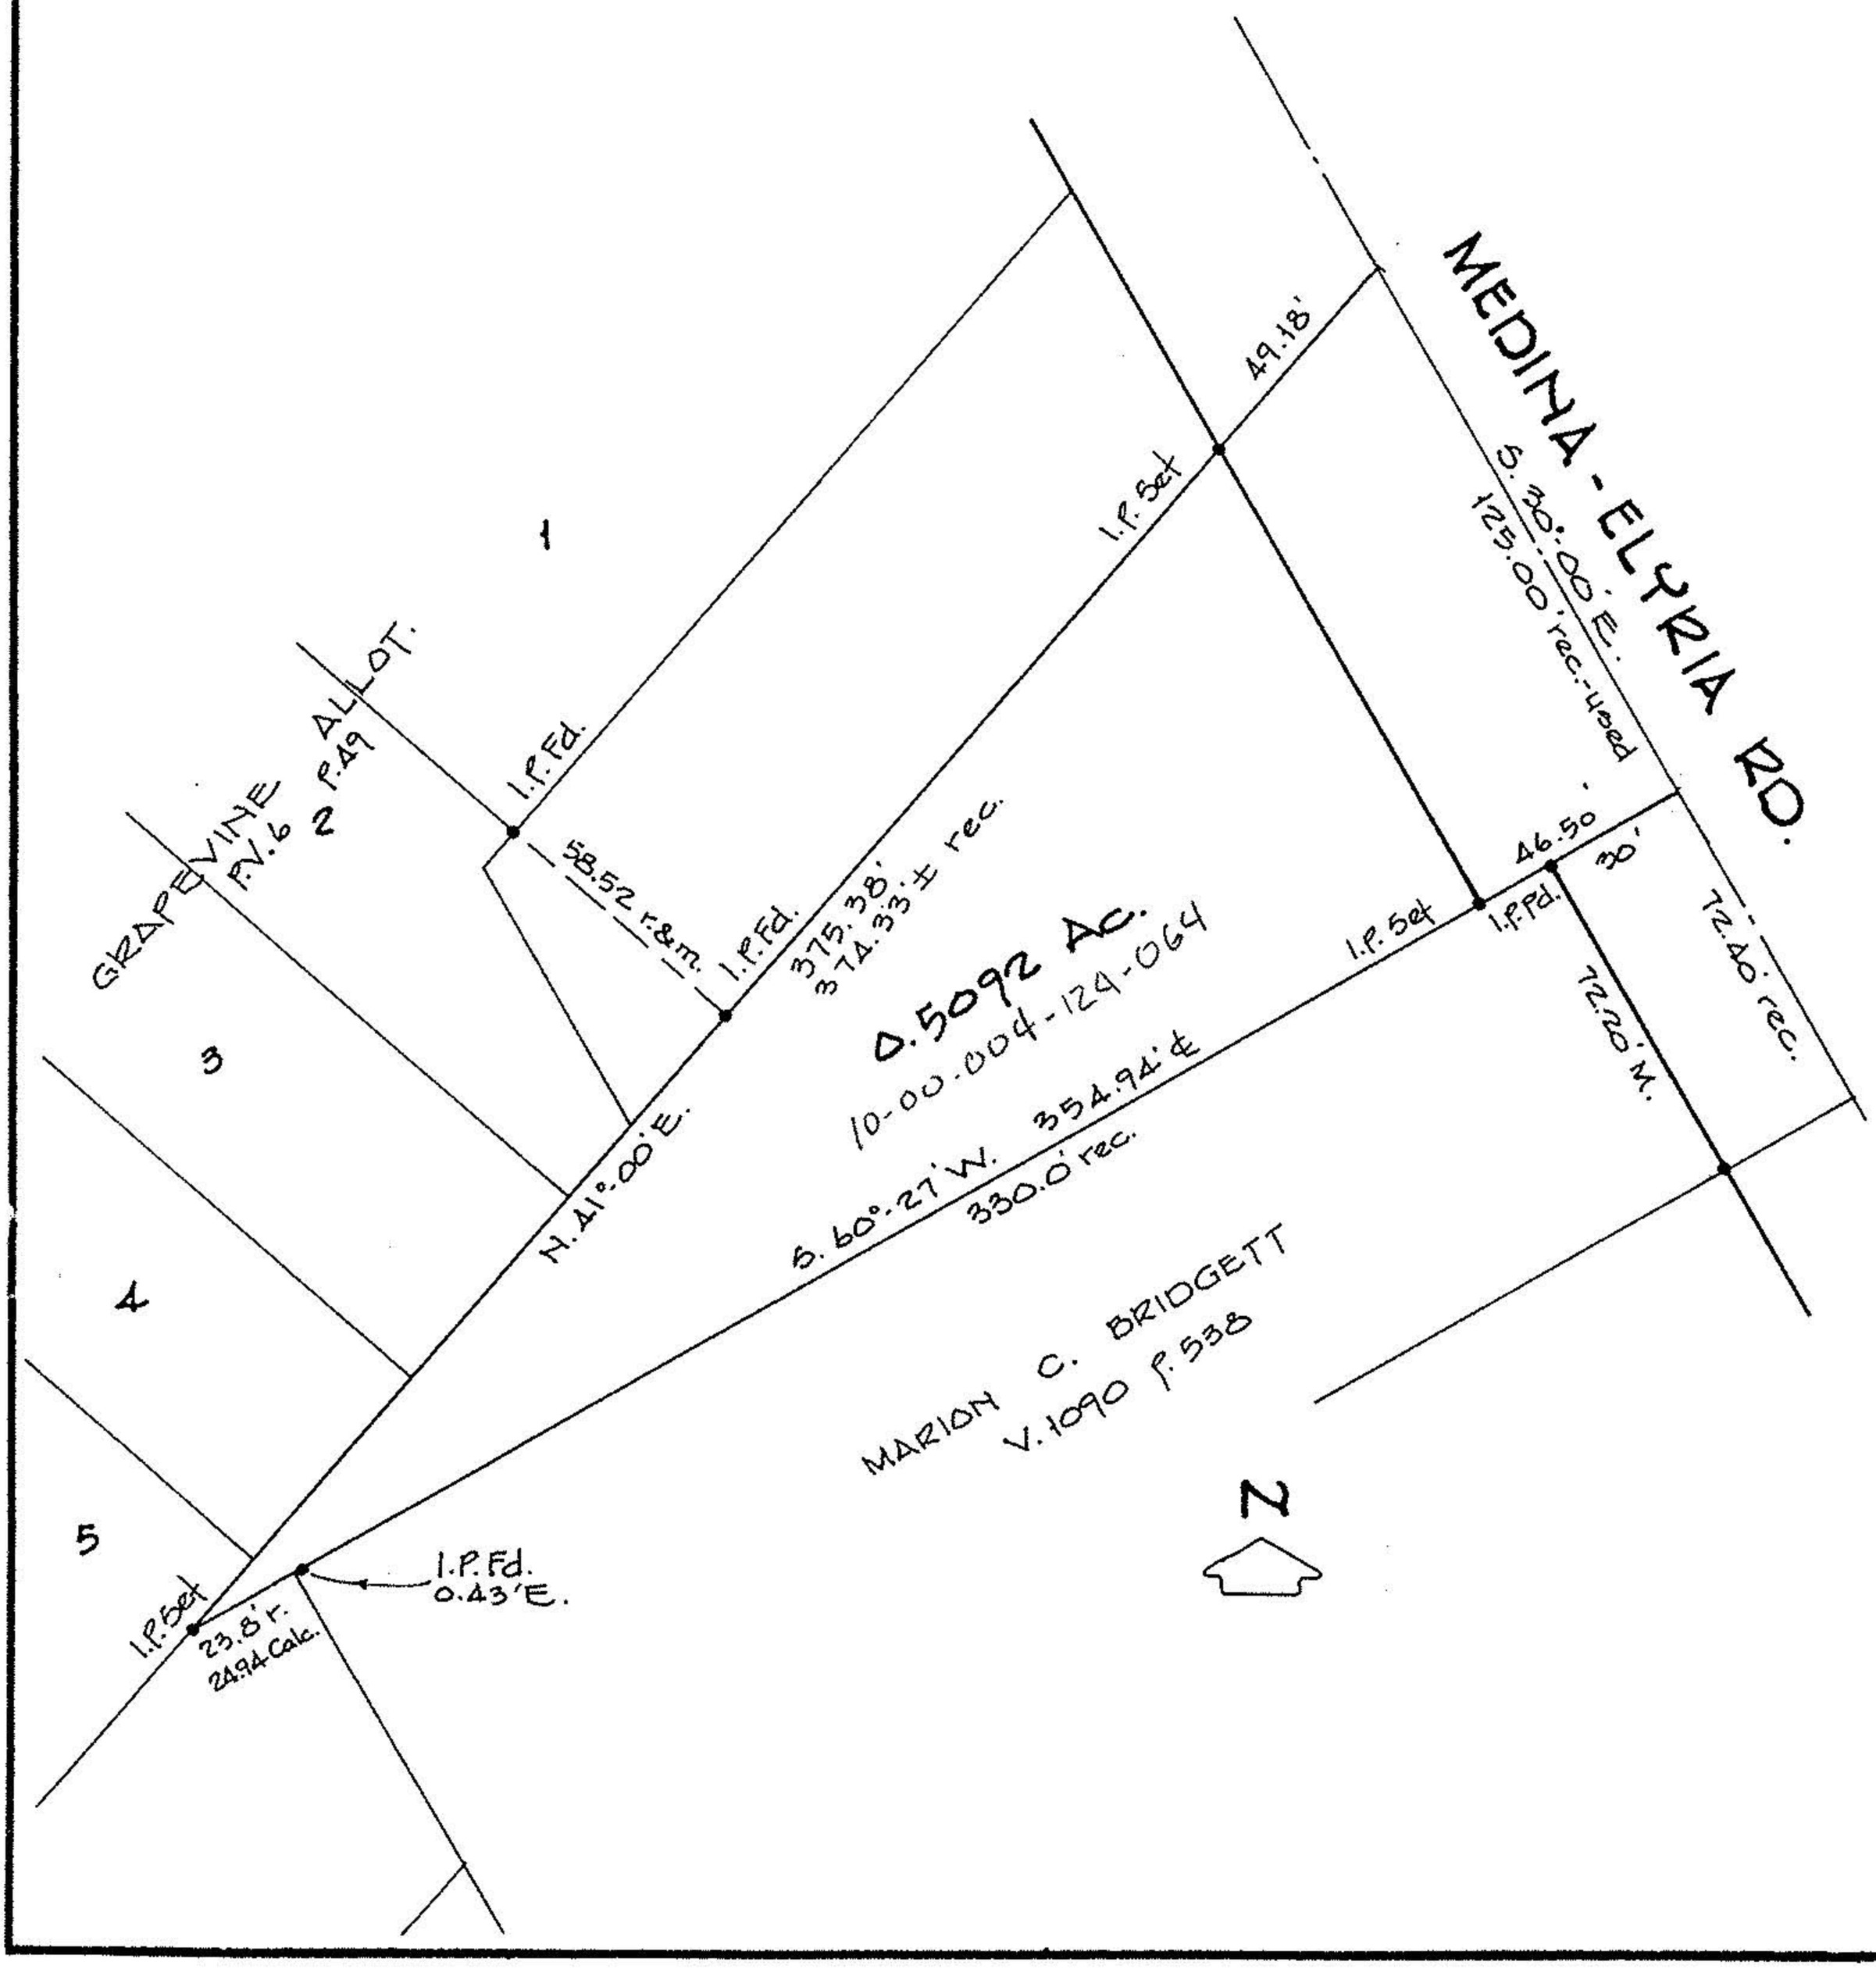
Orig. Lot	City of	Date FEB. 1, 1989 Scale 1" = 50'
Orig. Sec 1	Village of	Dwn. by R.G.S. Chkd. by
Tract	County of LORAIN	Job No. 88-1775 F.B. —
Township of CARLISLE	State of OHIO	Printed