CAP & MIL
EL 17554 in purple
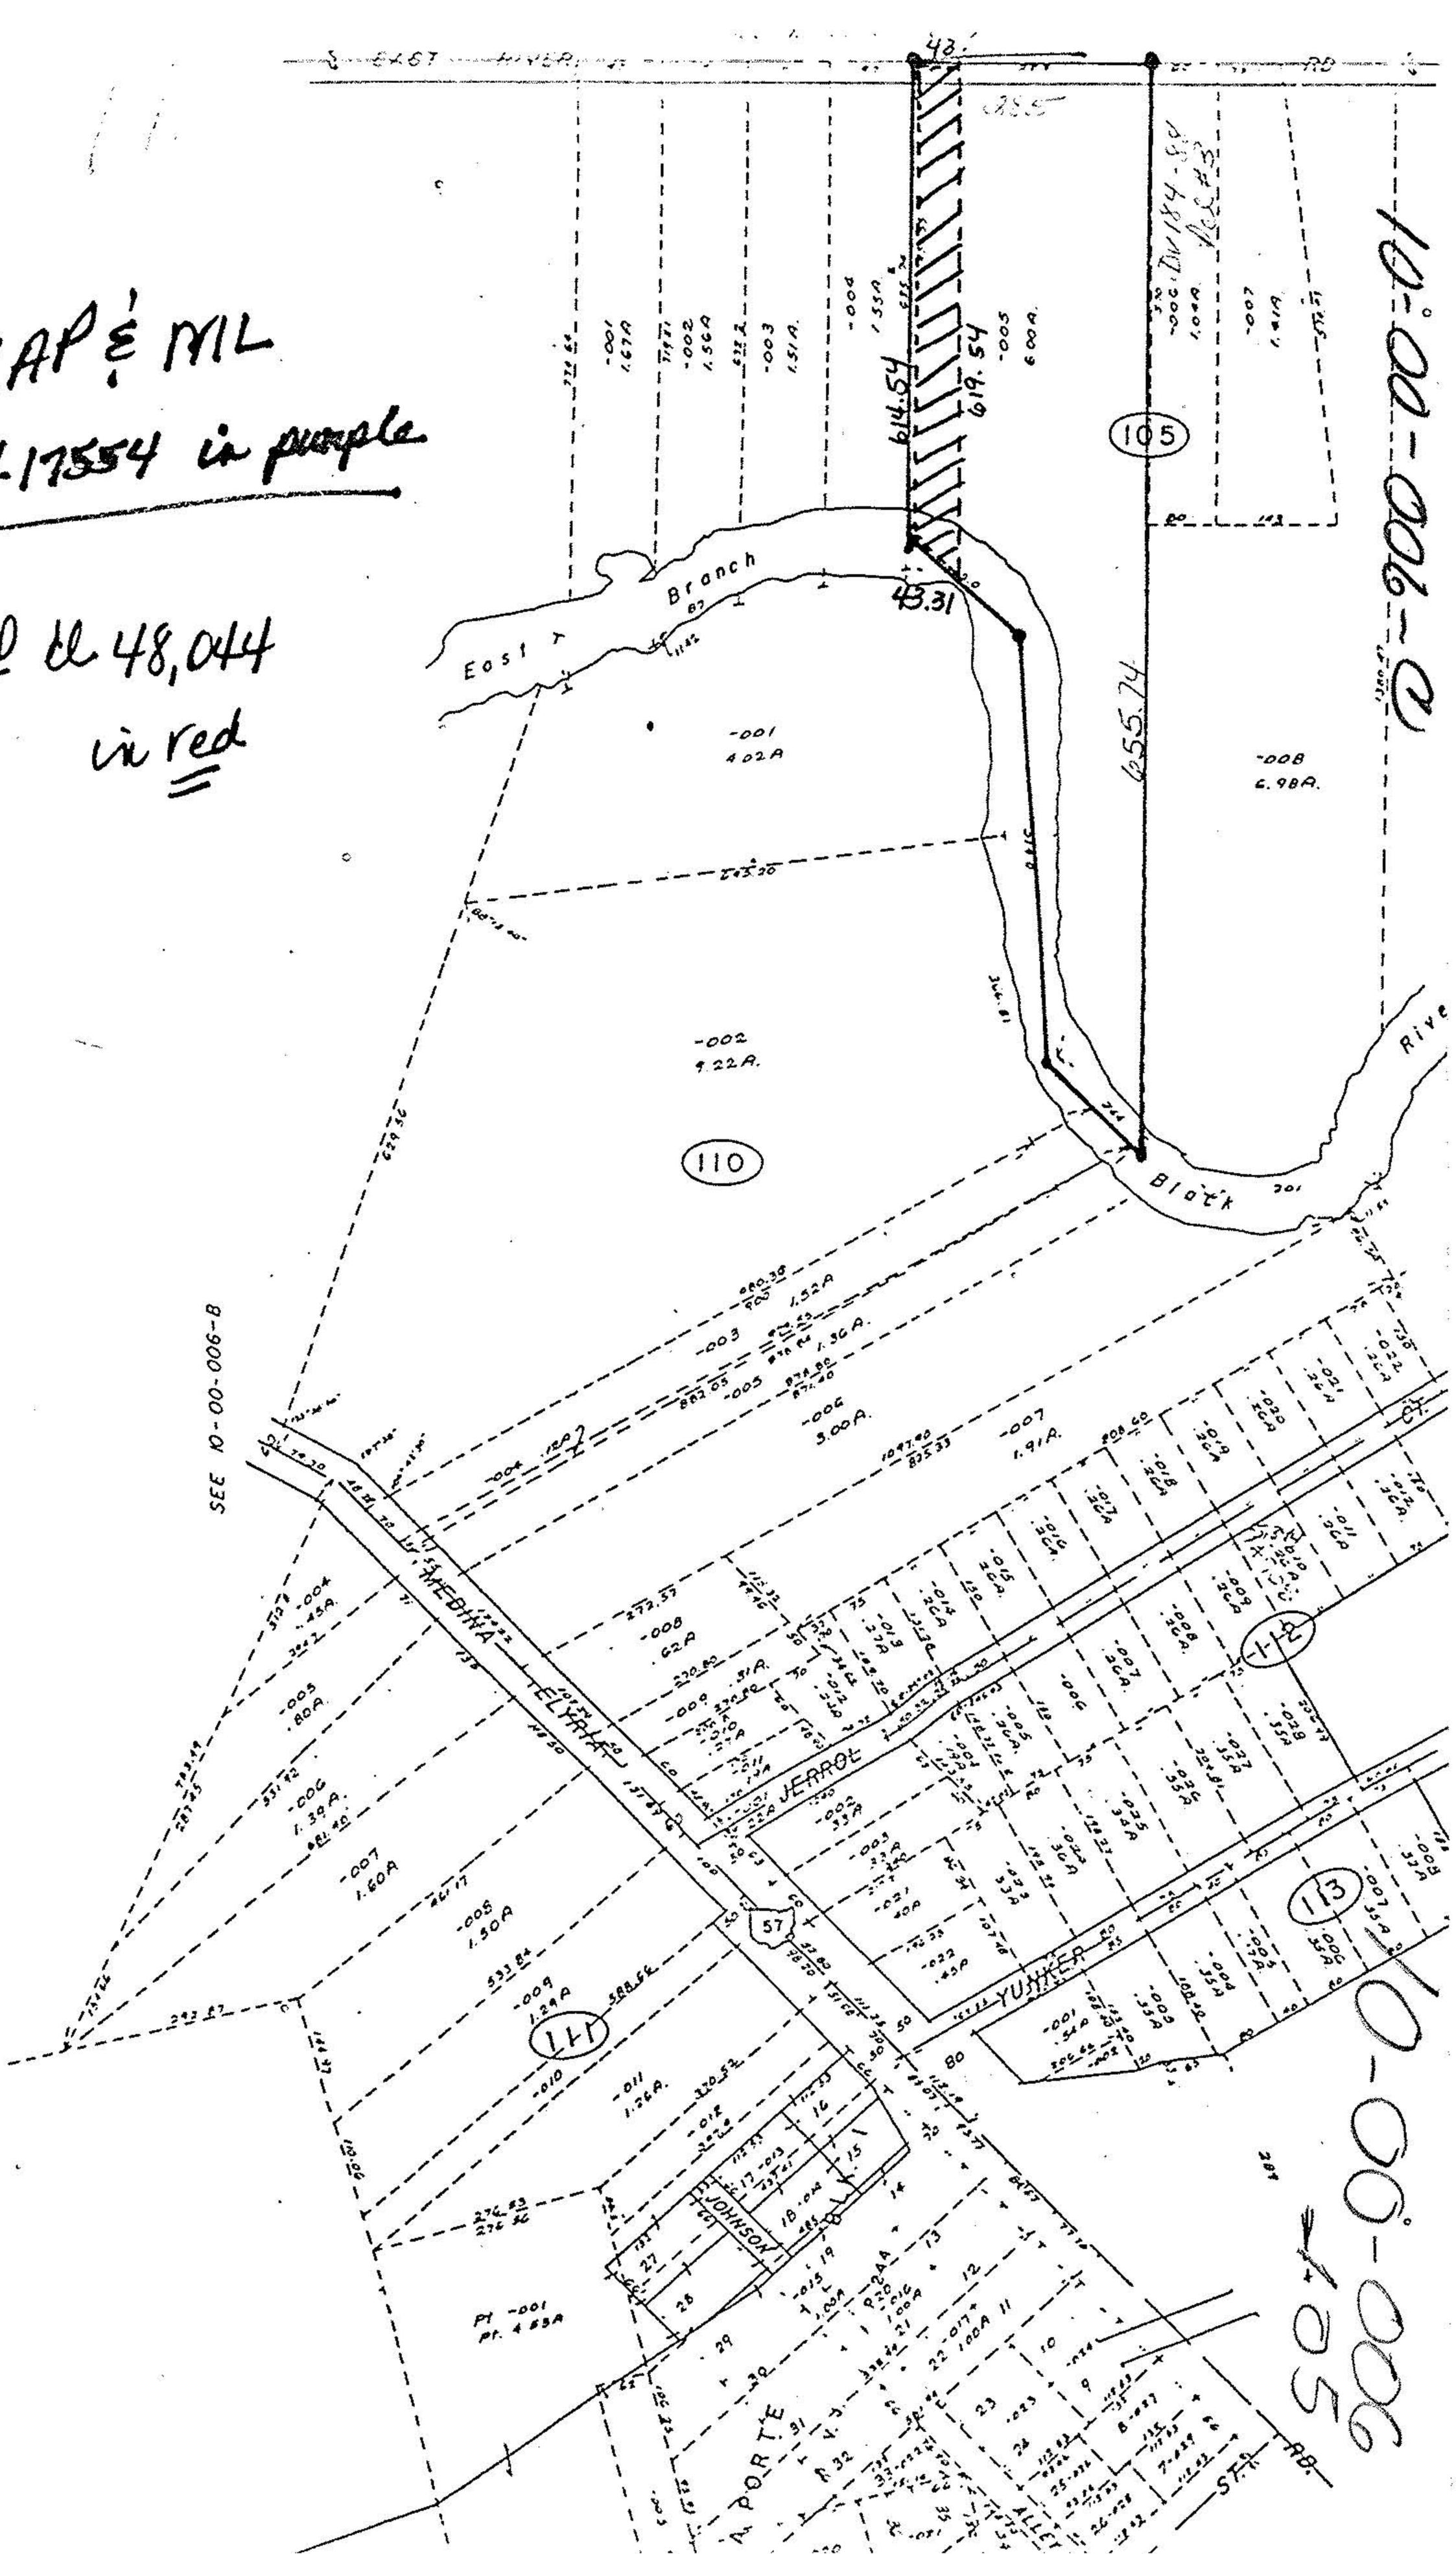
CAP EL 48,044
in red