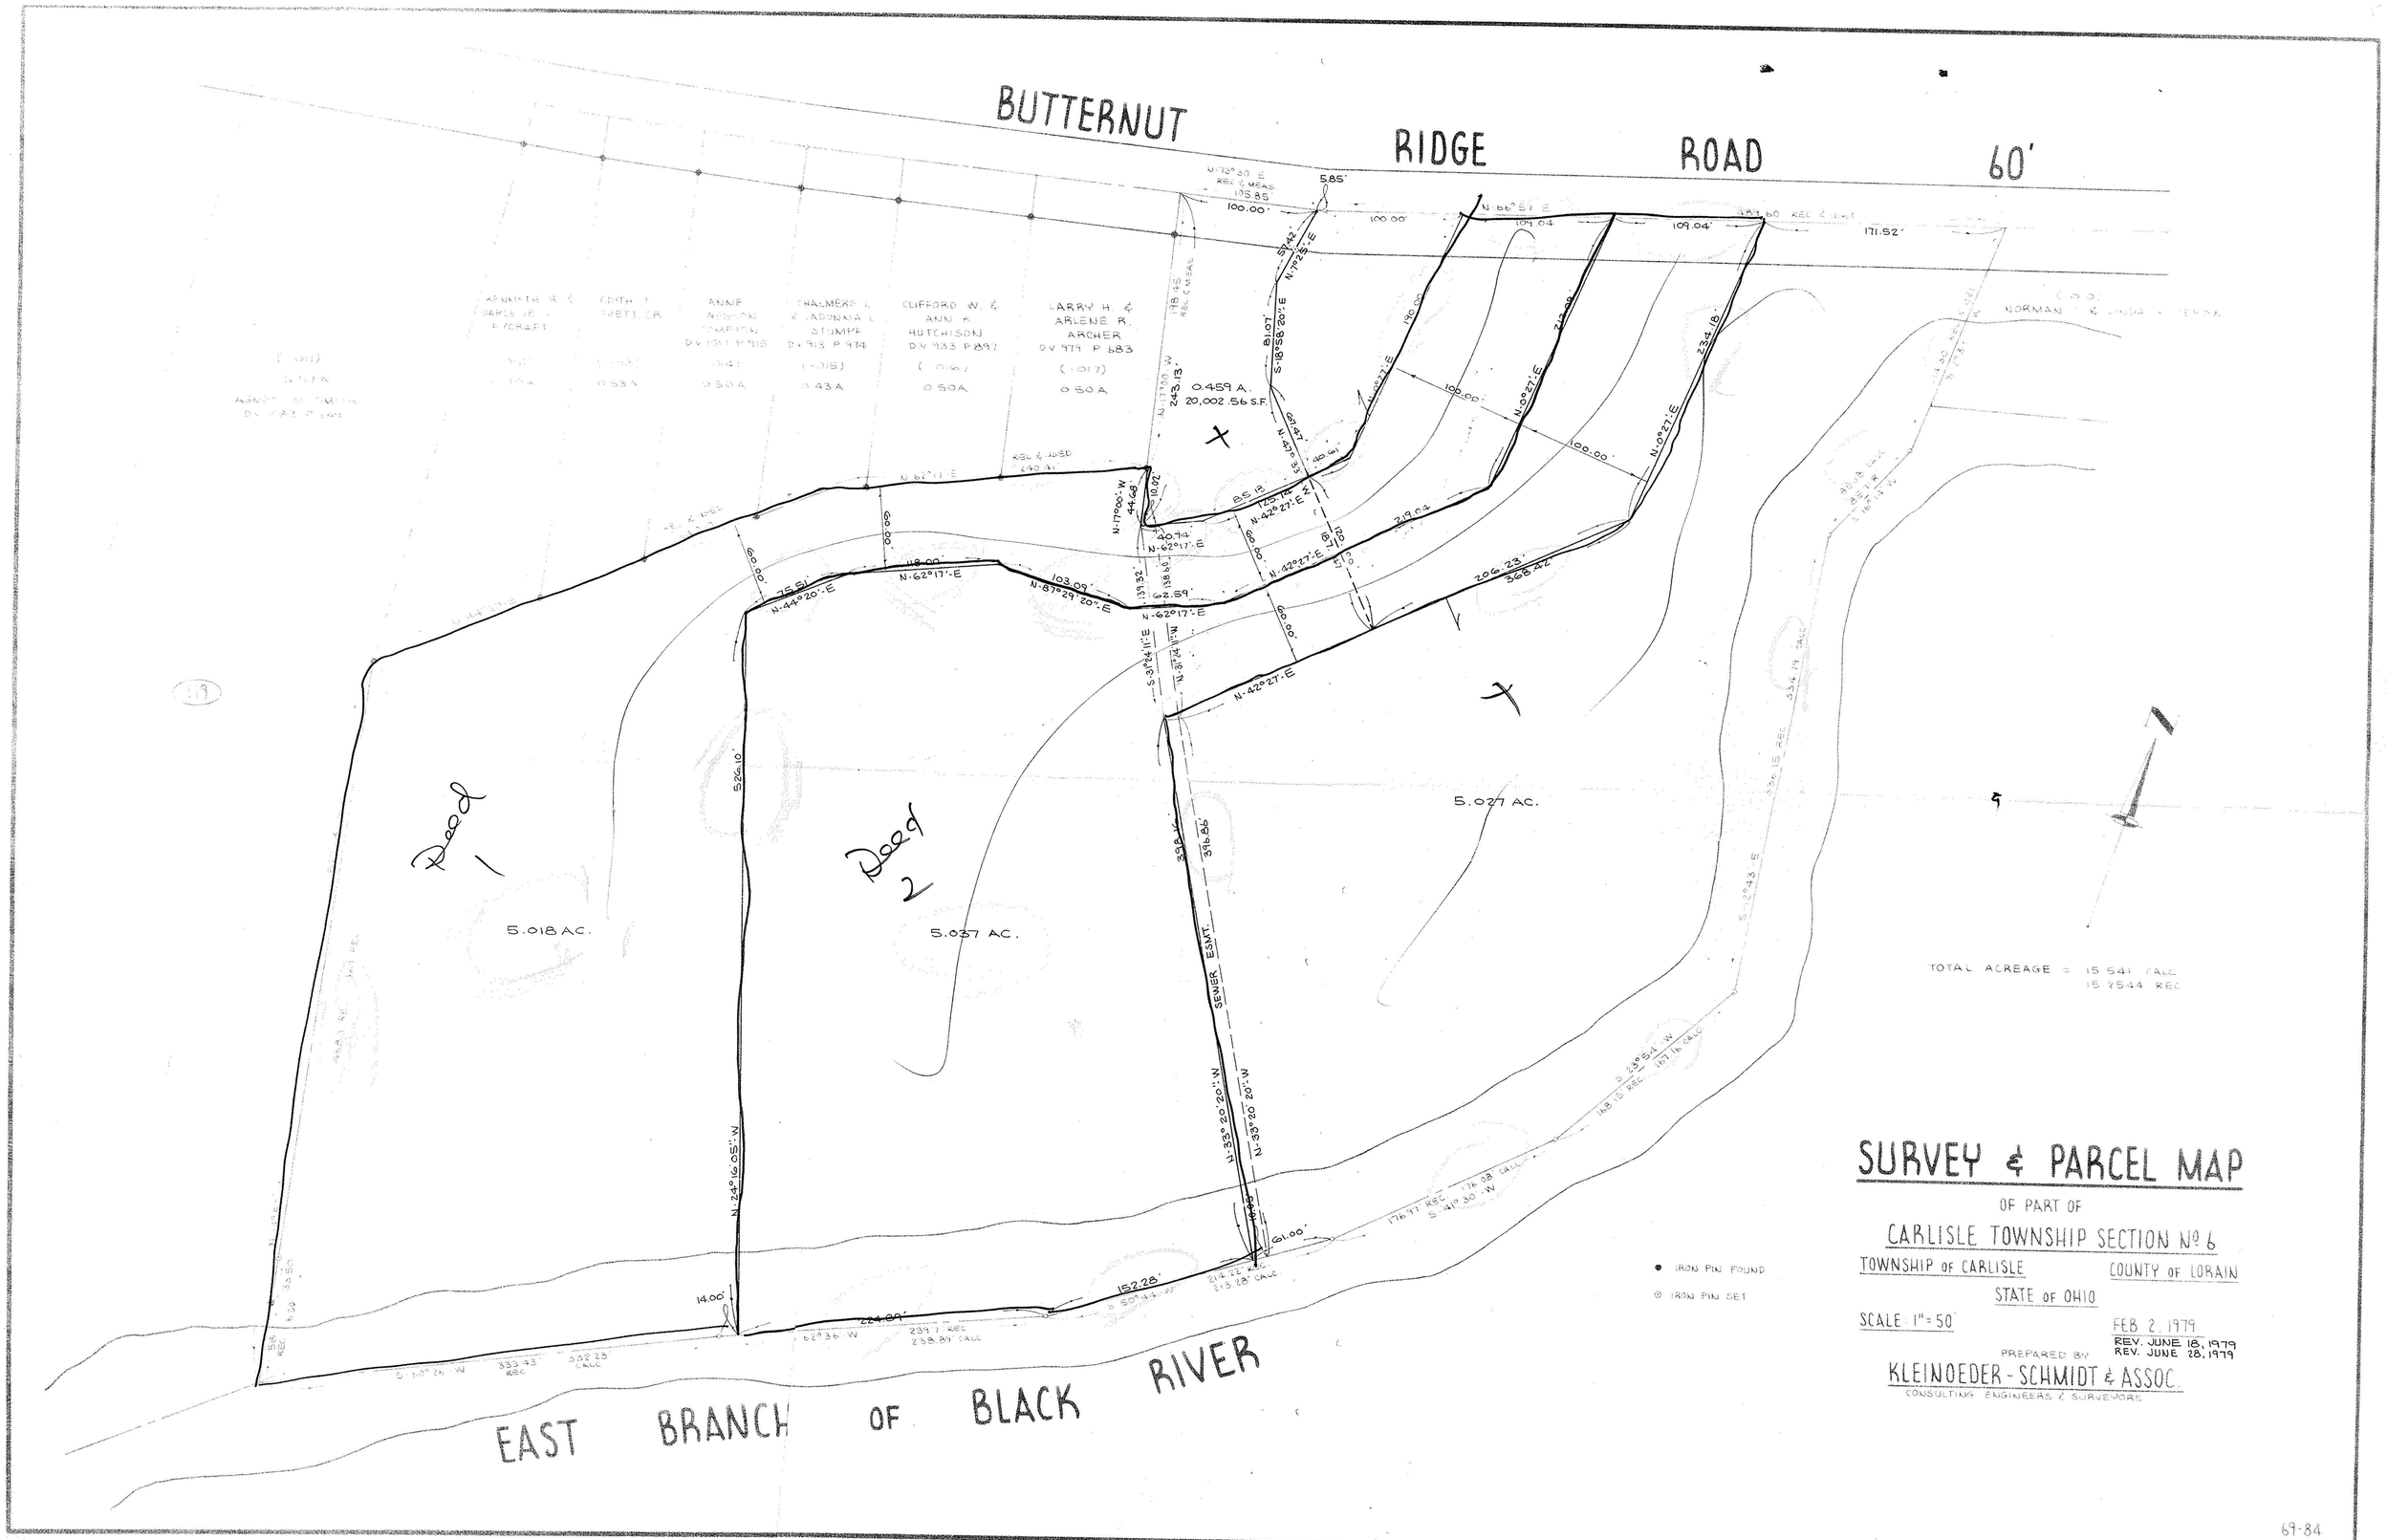
BUTTERNUT RIDGE ROAD 60'
EAST BRANCH OF BLACK RIVER
ANNE NOBLOCK DOMPESKI DV 1011 P 915
CHALMERS L. & JADONNA L. STUMPF DV 913 P 974
CLIFFORD W. & ANN K. HUTCHISON DV 933 P 897
LARRY H. & ARLENE R. ARCHER DV 979 P 683
0.459 A.
20,002.56 S.F.
5.018 AC.
5.037 AC.
5.027 AC.
Deed 1
Deed 2
SEWER ESMT.
N-62°17'-E
N-42°27'-E
N-24°16'05"-W
N-33°20'20"-W
N-35°20'20"-W
N-00°27'-E
S-18°56'20"-E
N-17°23'-E
N-66°57'-E
N-44°20'-E
N-87°29'20"-E
S-37°24'11"-E
N-17°00'-W
S-41°50'-W
S-23°54'-W
TOTAL ACREAGE = 15.541 CALC
15.6544 REC
IRON PIN FOUND
IRON PIN SET
SURVEY & PARCEL MAP
OF PART OF
CARLISLE TOWNSHIP SECTION Nº 6
TOWNSHIP OF CARLISLE
COUNTY OF LORAIN
STATE OF OHIO
SCALE 1" = 50'
FEB 2, 1979
REV. JUNE 18, 1979
REV. JUNE 28, 1979
PREPARED BY
KLEINOEDER - SCHMIDT & ASSOC.
CONSULTING ENGINEERS & SURVEYORS
69-84