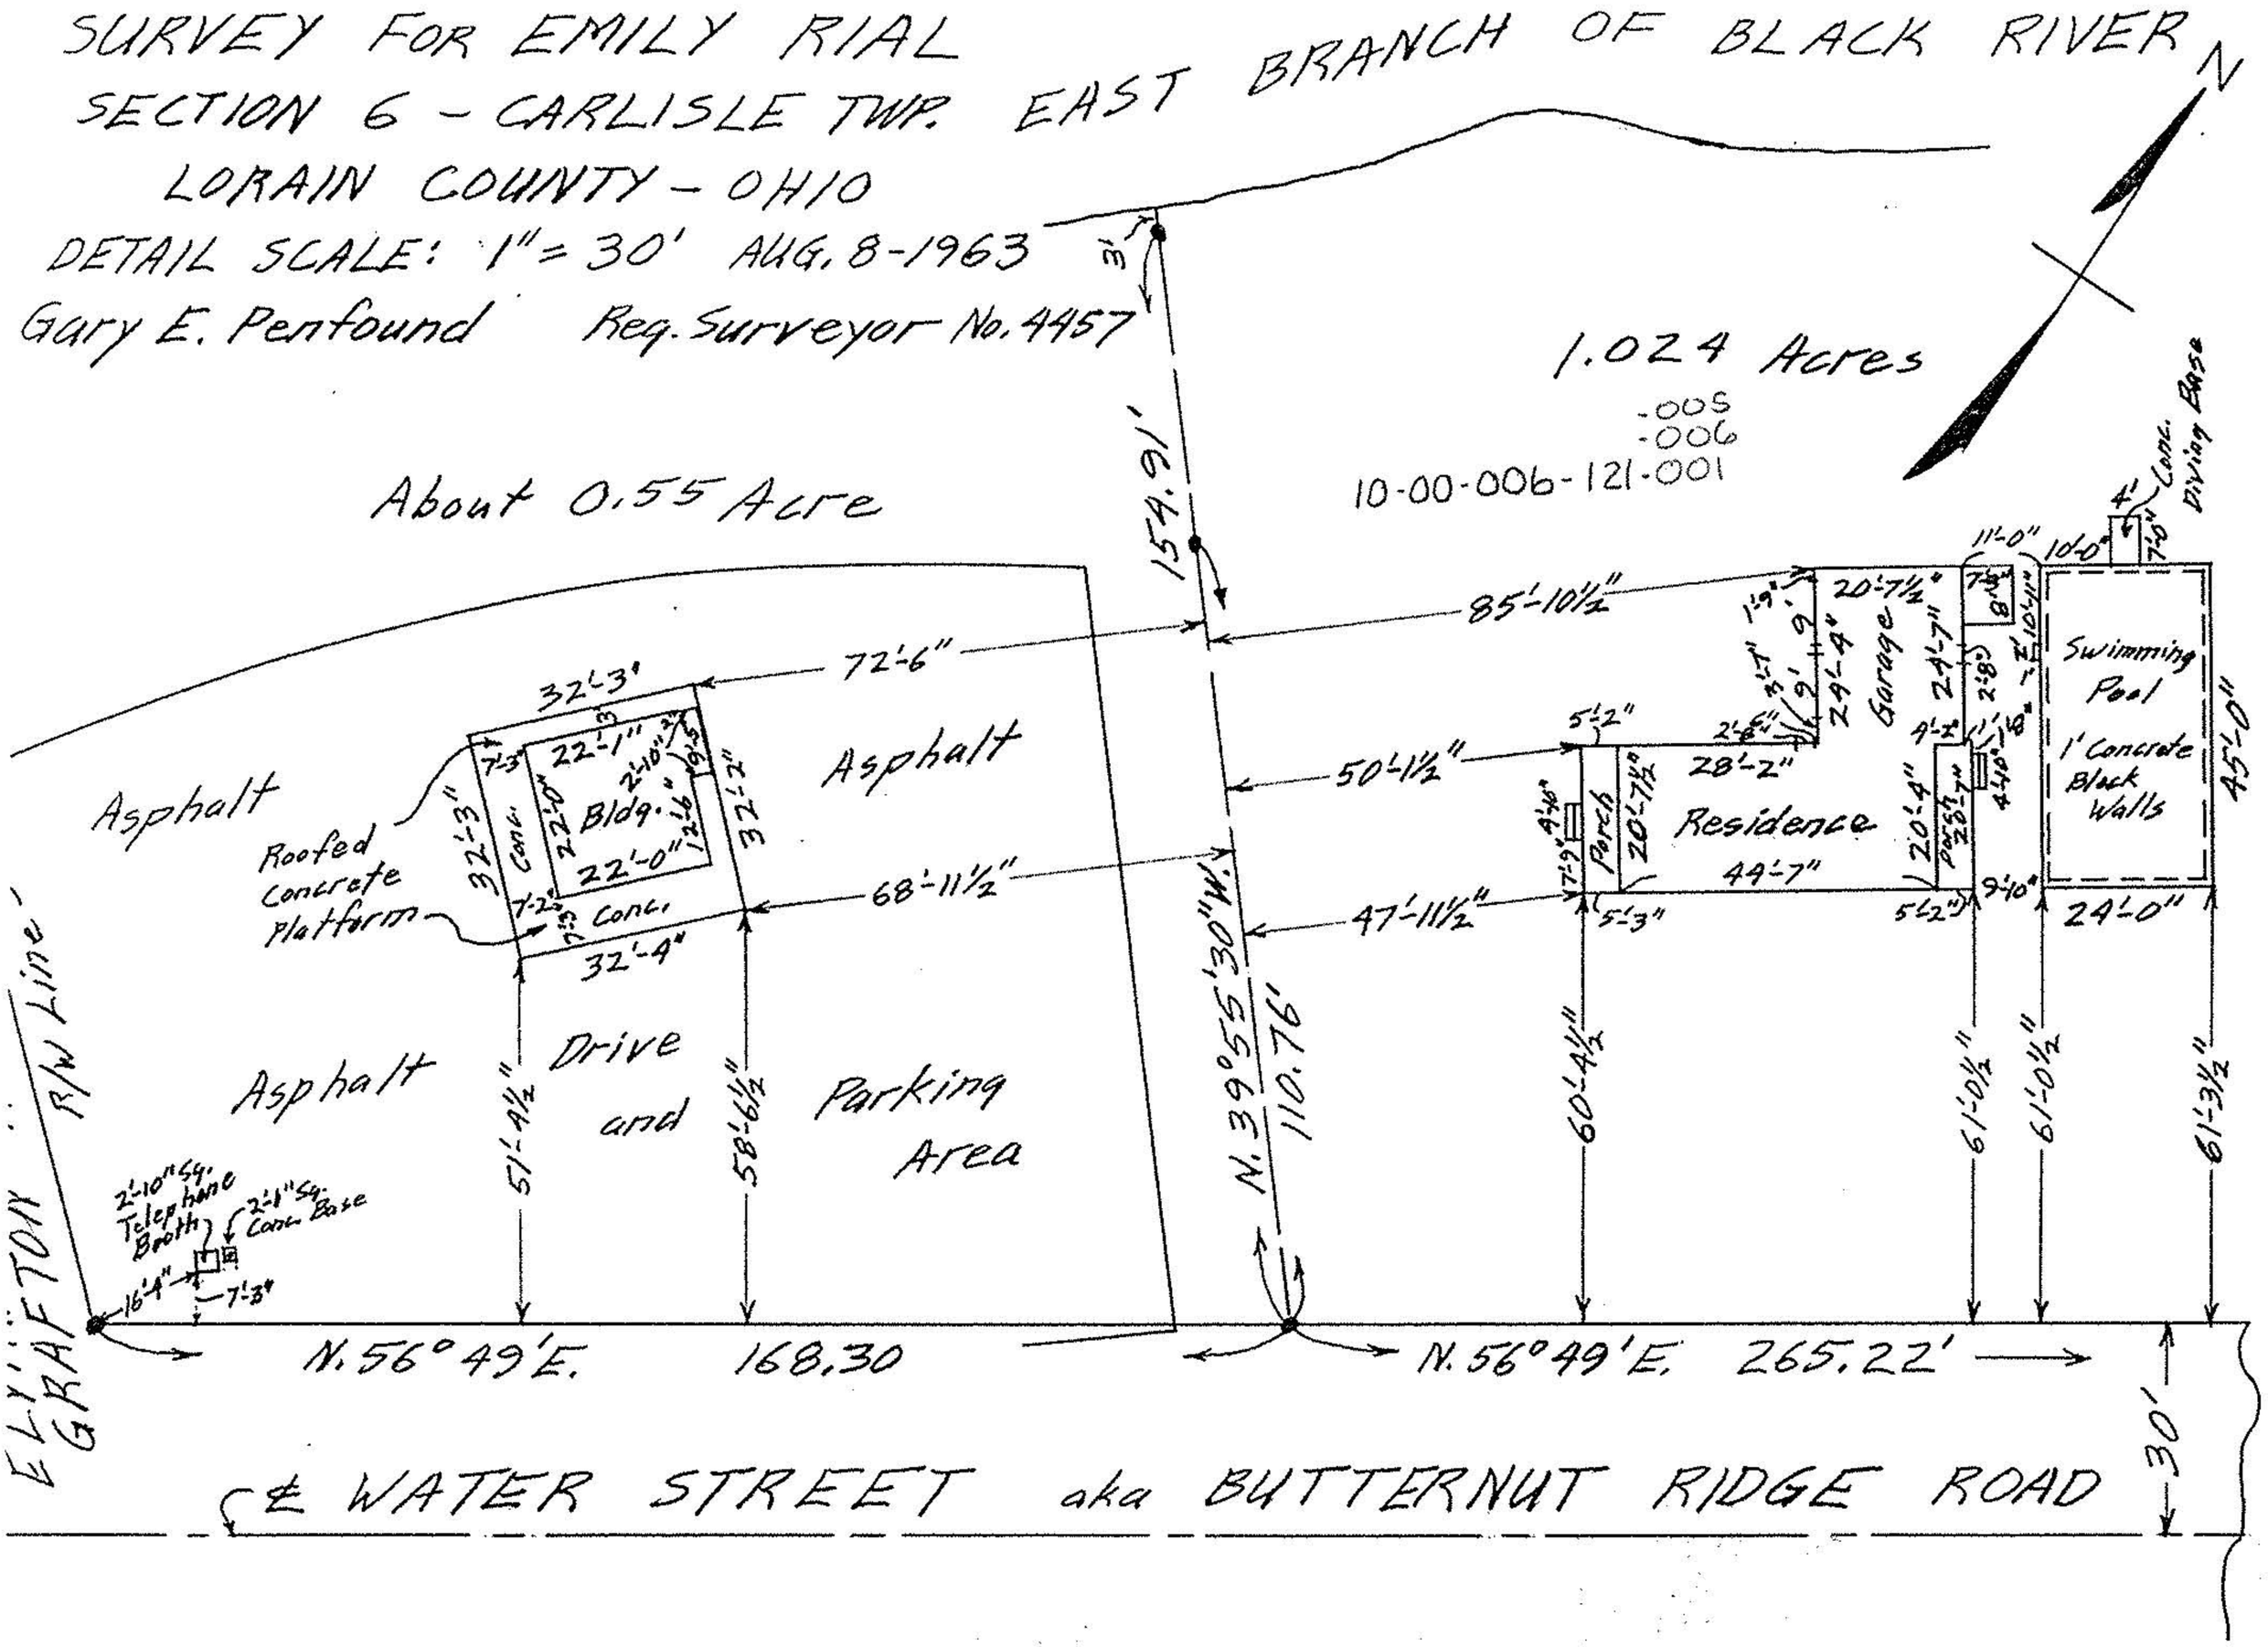DETAIL SHEET OF
SURVEY FOR EMILY RIAL
SECTION 6 - CARLISLE TWP.
LORAIN COUNTY - OHIO
DETAIL SCALE: 1" = 30' AUG. 8-1963
Gary E. Penfound Reg. Surveyor No. 4457