LAUNDON • SIMON • CAHL & ASSOC. INC.
CONSULTING ENGINEERS & SURVEYORS
504 MIDDLE AVENUE ELYRIA, OHIO 44035

SURVEY FOR:

MARK & MARTHA BROWN
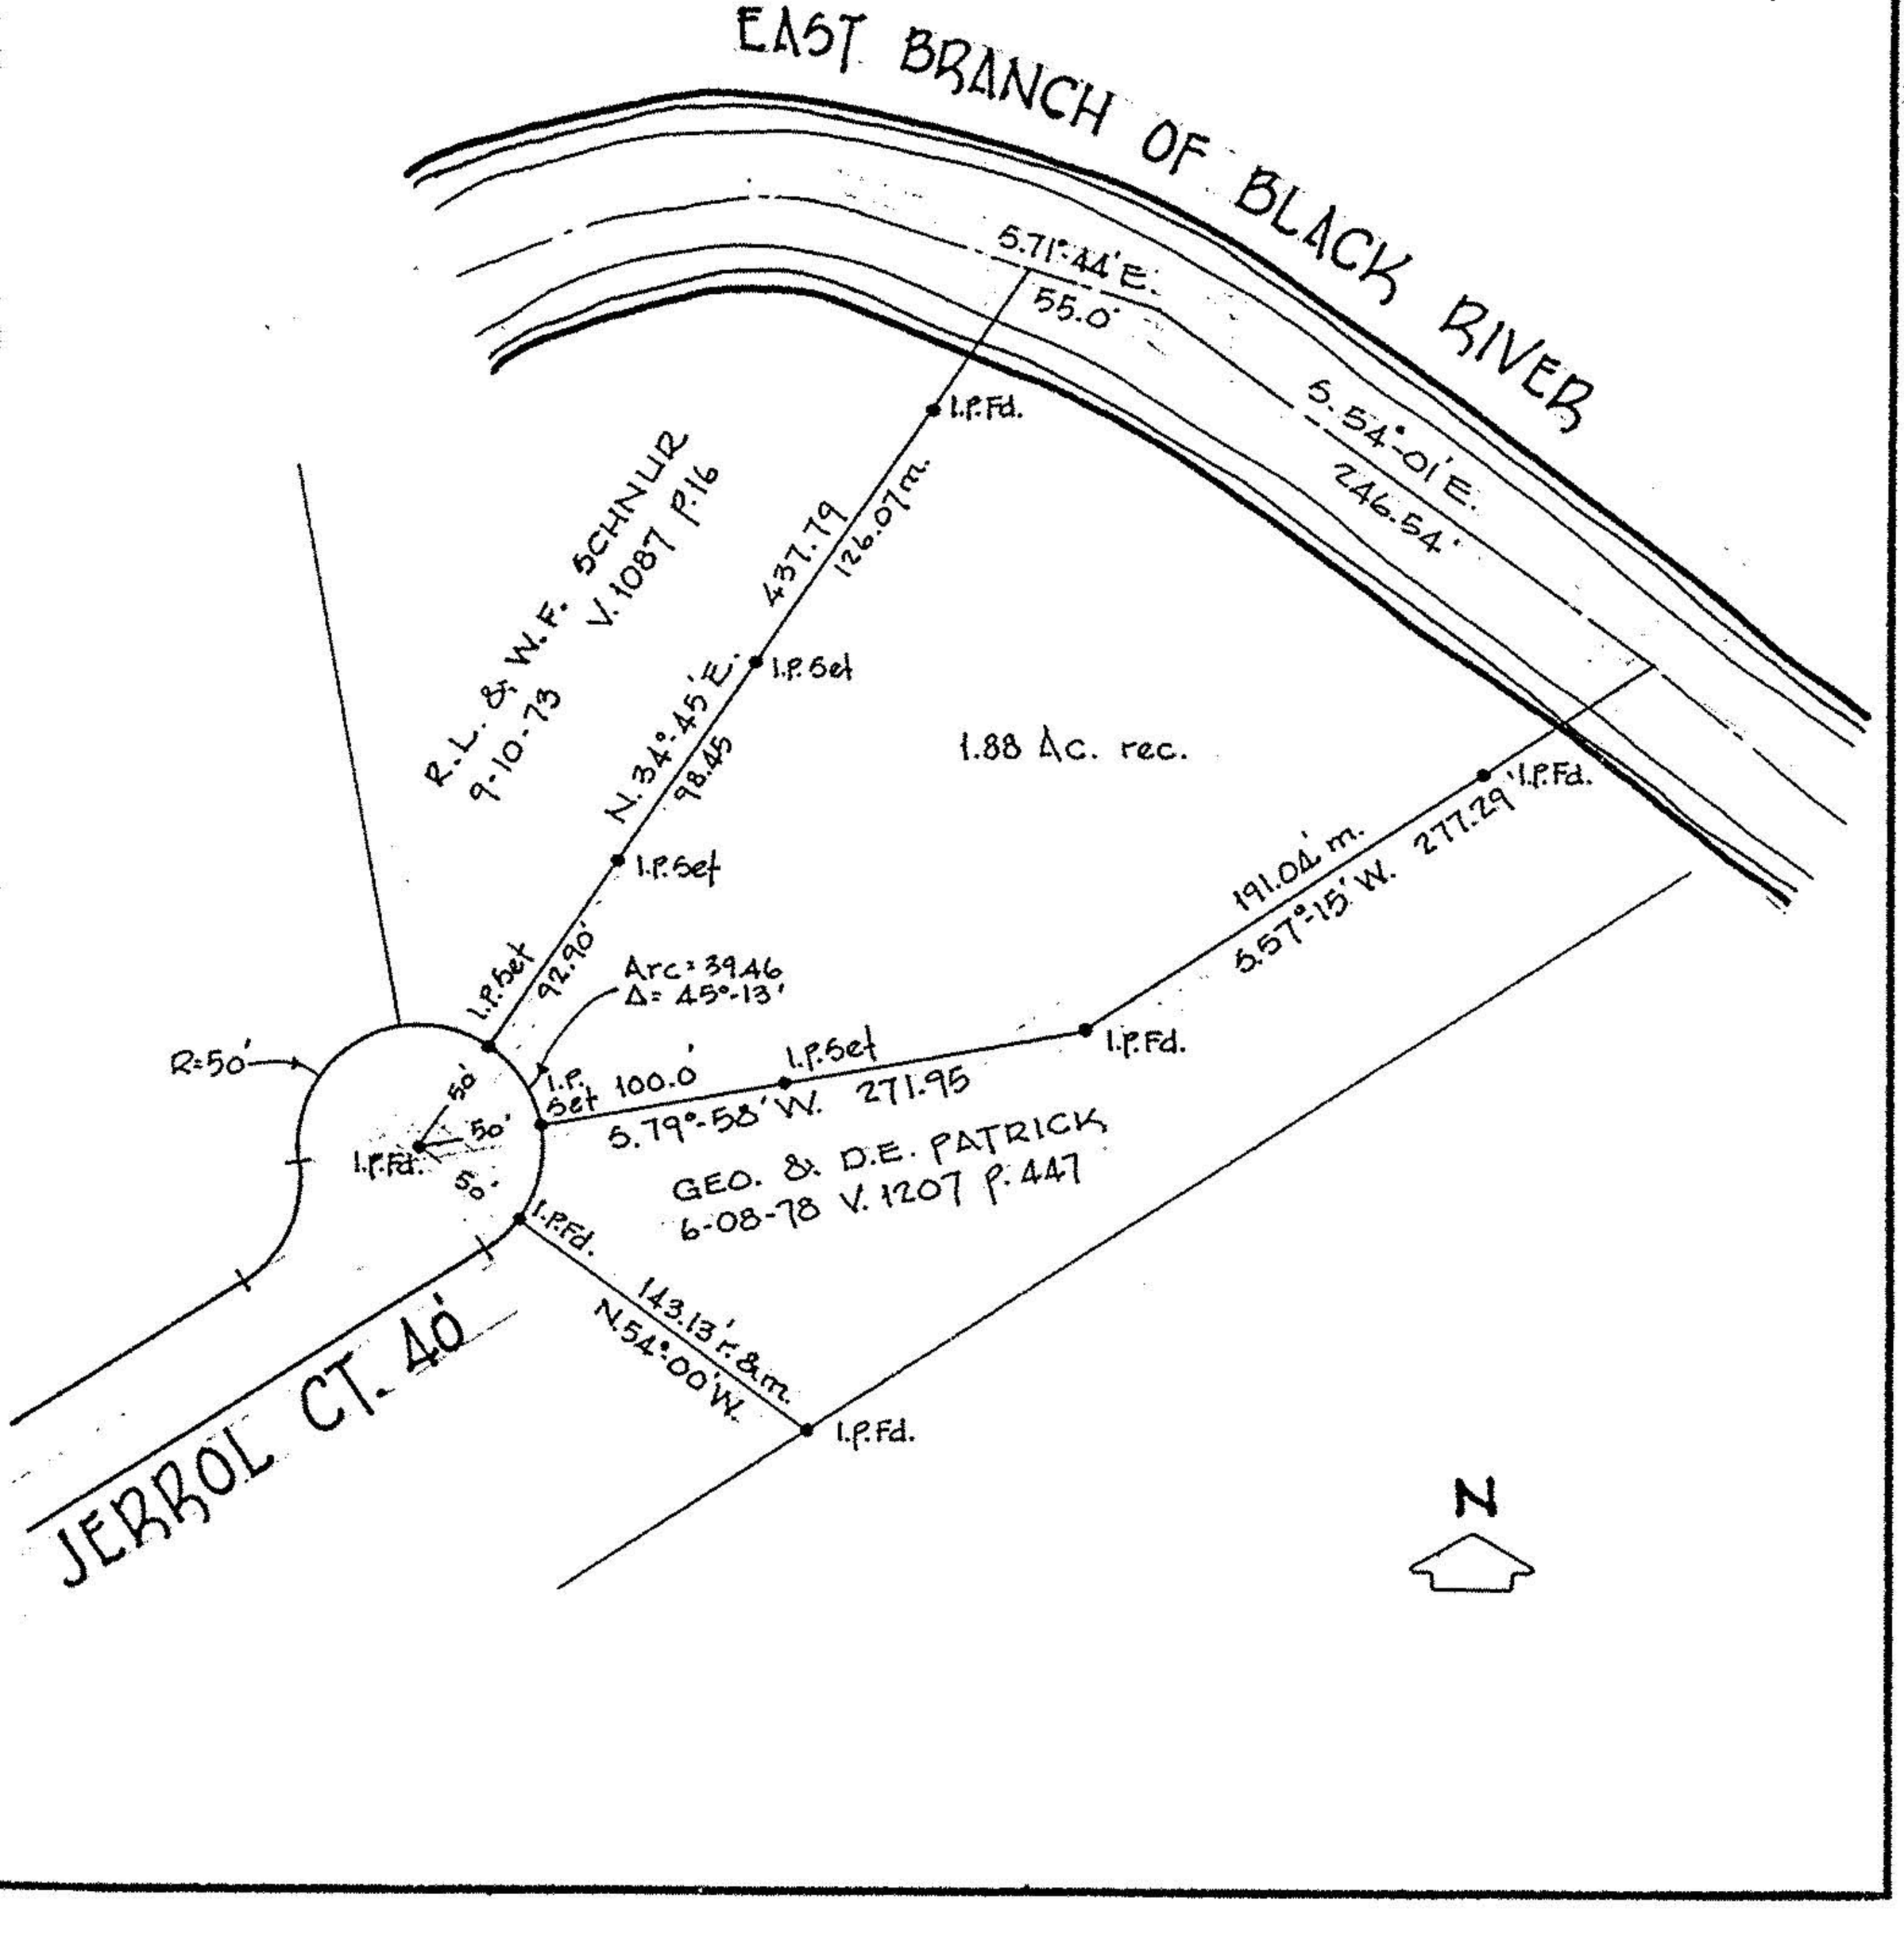
| | | |
|---|---|---|
| Orig. Lot | City of | Date 7-24-84 Scale 1"=100' |
| Orig. Sec 6 | Village of | Dwn. by R.G.S. Chkd. by J.C. |
| Tract | County of LORAIN | Job No. 84-1306 F.B. 98/46 |
| Township of CARLISLE | State of OHIO | Printed |