LAUNDON • SIMON • CAHL & ASSOC. INC.
CONSULTING ENGINEERS & SURVEYORS
504 MIDDLE AVENUE ELYRIA, OHIO 44035

SURVEY FOR:

MARK & MARTHA BROWN
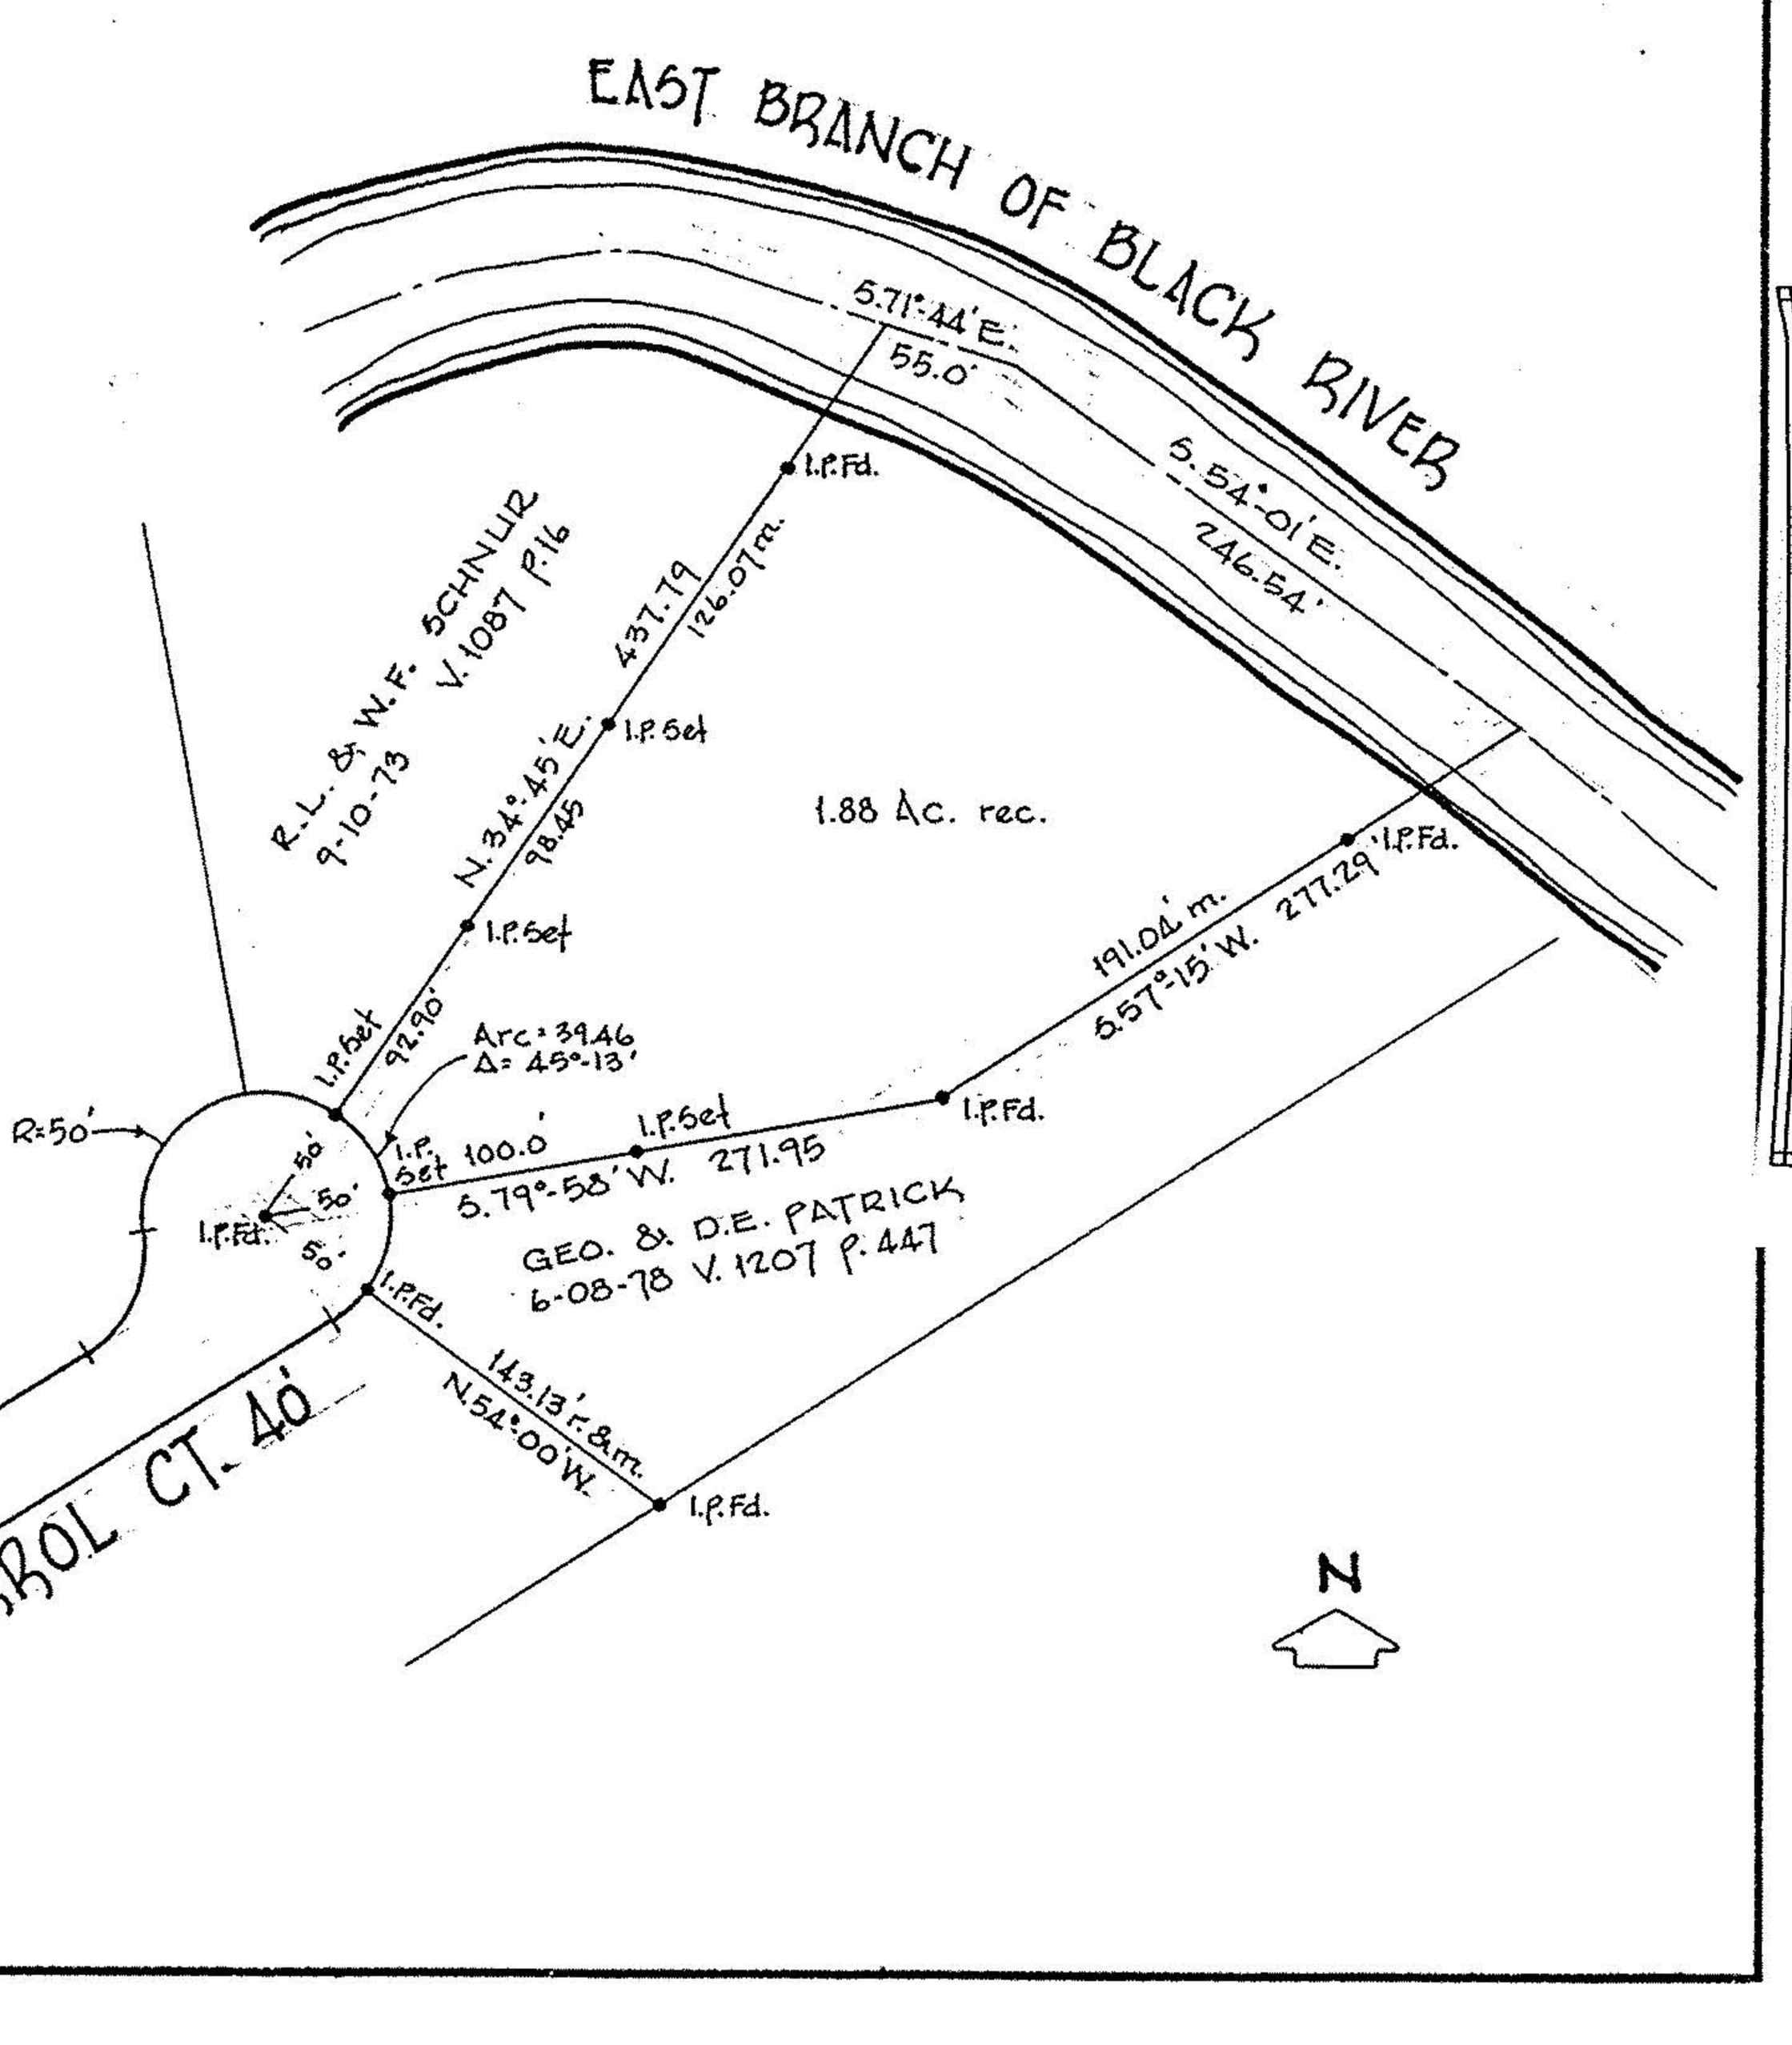
Orig. Lot	City of	Date 7-24-84 Scale 1"= 100'
Orig. Sec 6	Village of	Dwn. by R.G.S. Chkd. by J.C.
Tract	County of LORAIN	Job No. 84-1306 F.B. 98/46
Township of CARLISLE	State of OHIO	Printed