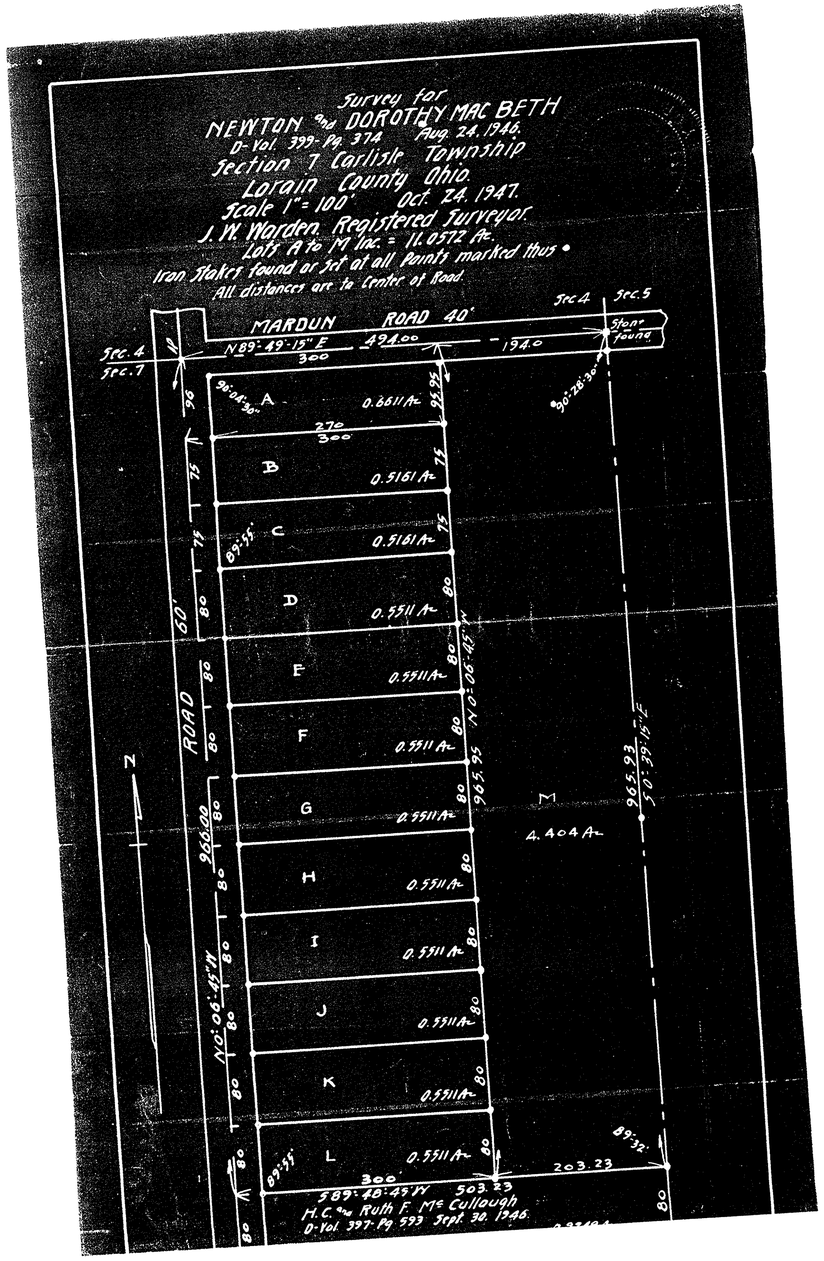

#20429A

APPROVED
LORAIN CO.
MAP DEPT.
DATE
PAGE
BY
2ND LATER

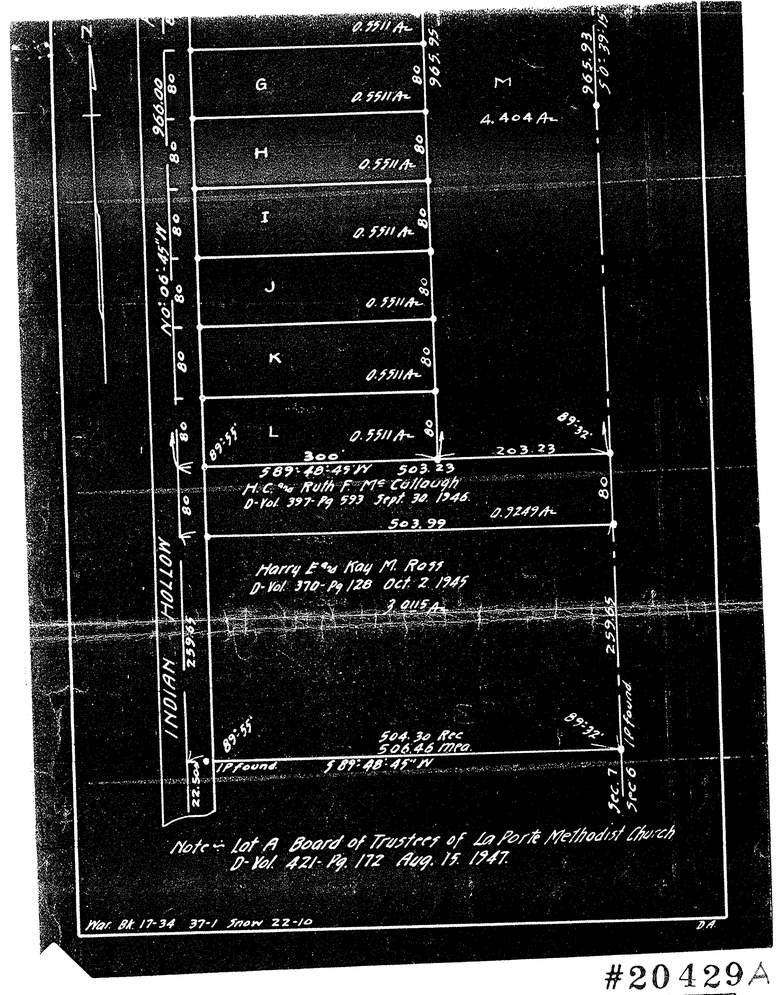

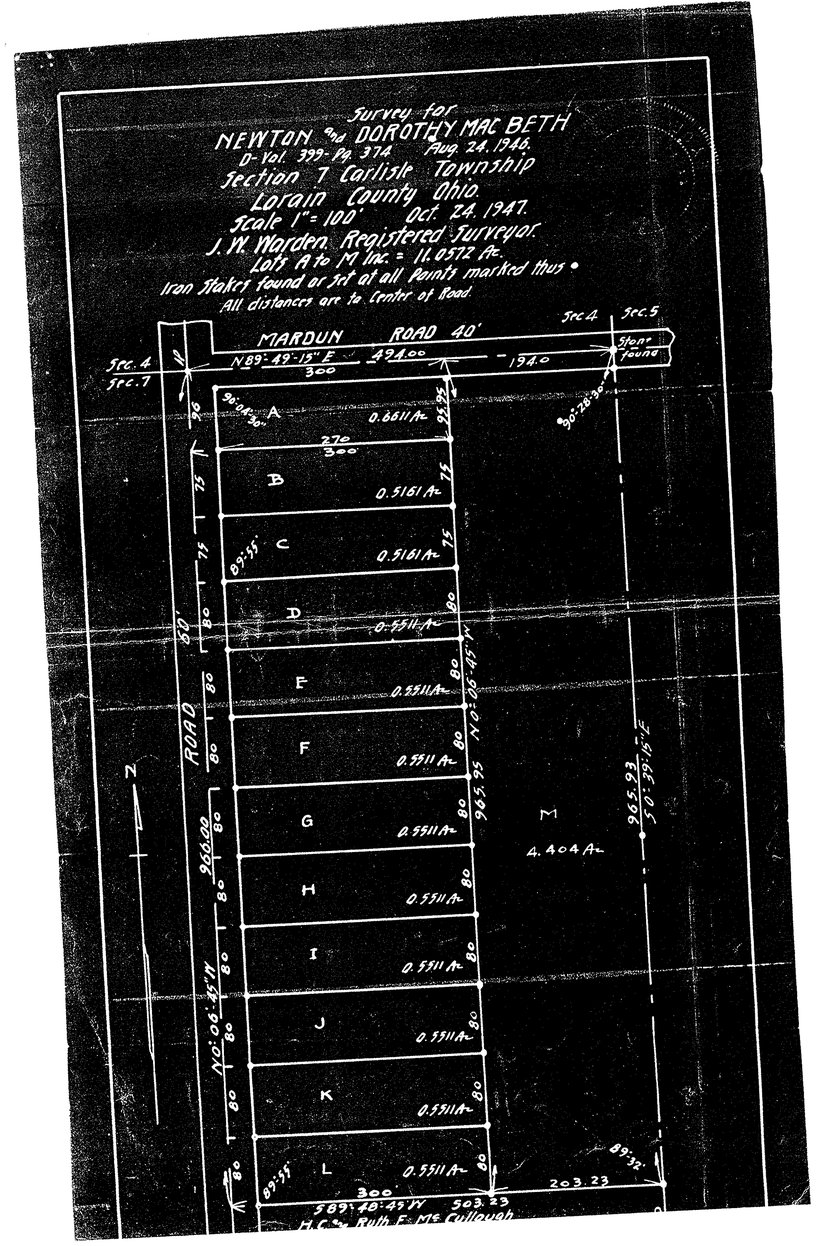
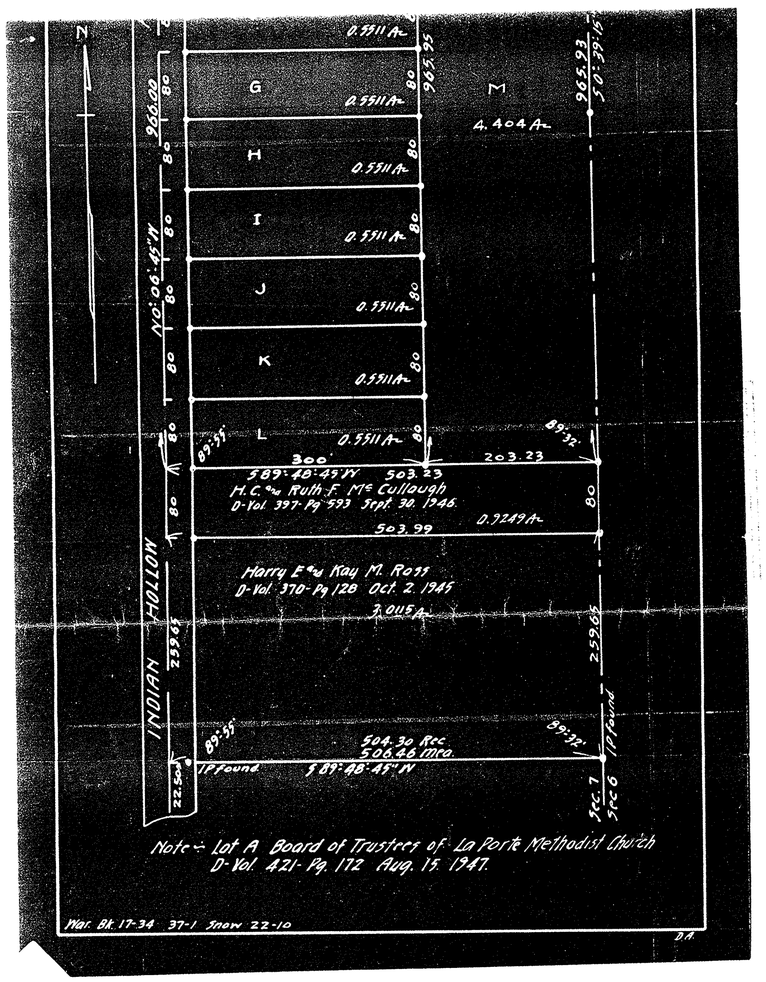
P.P. NO. 10-00-007-103-001 thru -008	
10-00-007-103- thru -013, 015, 017, 018	
SPLIT #	DATE OF SURVEY
20429-A	07. 24, 1947
MAP PAGE	
10-00-007-D	
SURVEYOR	
J.W. WARDEN